


## DEVELOPMENT DATA

TAX PARCEL ID <sup>#</sup>'S: ZONING JURISDICTION: TOTAL SITE ACREAGE:

223-451-81 MECKLENBURG COUNTY (3.78) 3.62 AC NET OF EXISTING R/W

### Zoning:

EXISTING ZONING: EXISTING USE: R8-MF (CD) SINGLE FAMILY DWELLING UNIT (STRUCTURE) & VACANT LAND

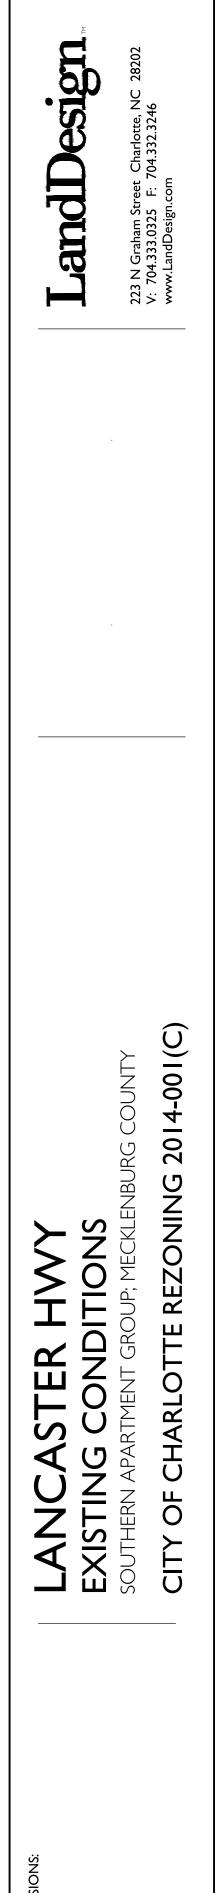


25' 0' 25' 50'

<sup>B</sup>B<sup>D</sup>

A H K

N

PETITION #: 2014-001(C) CITY OF CHARLOTTE

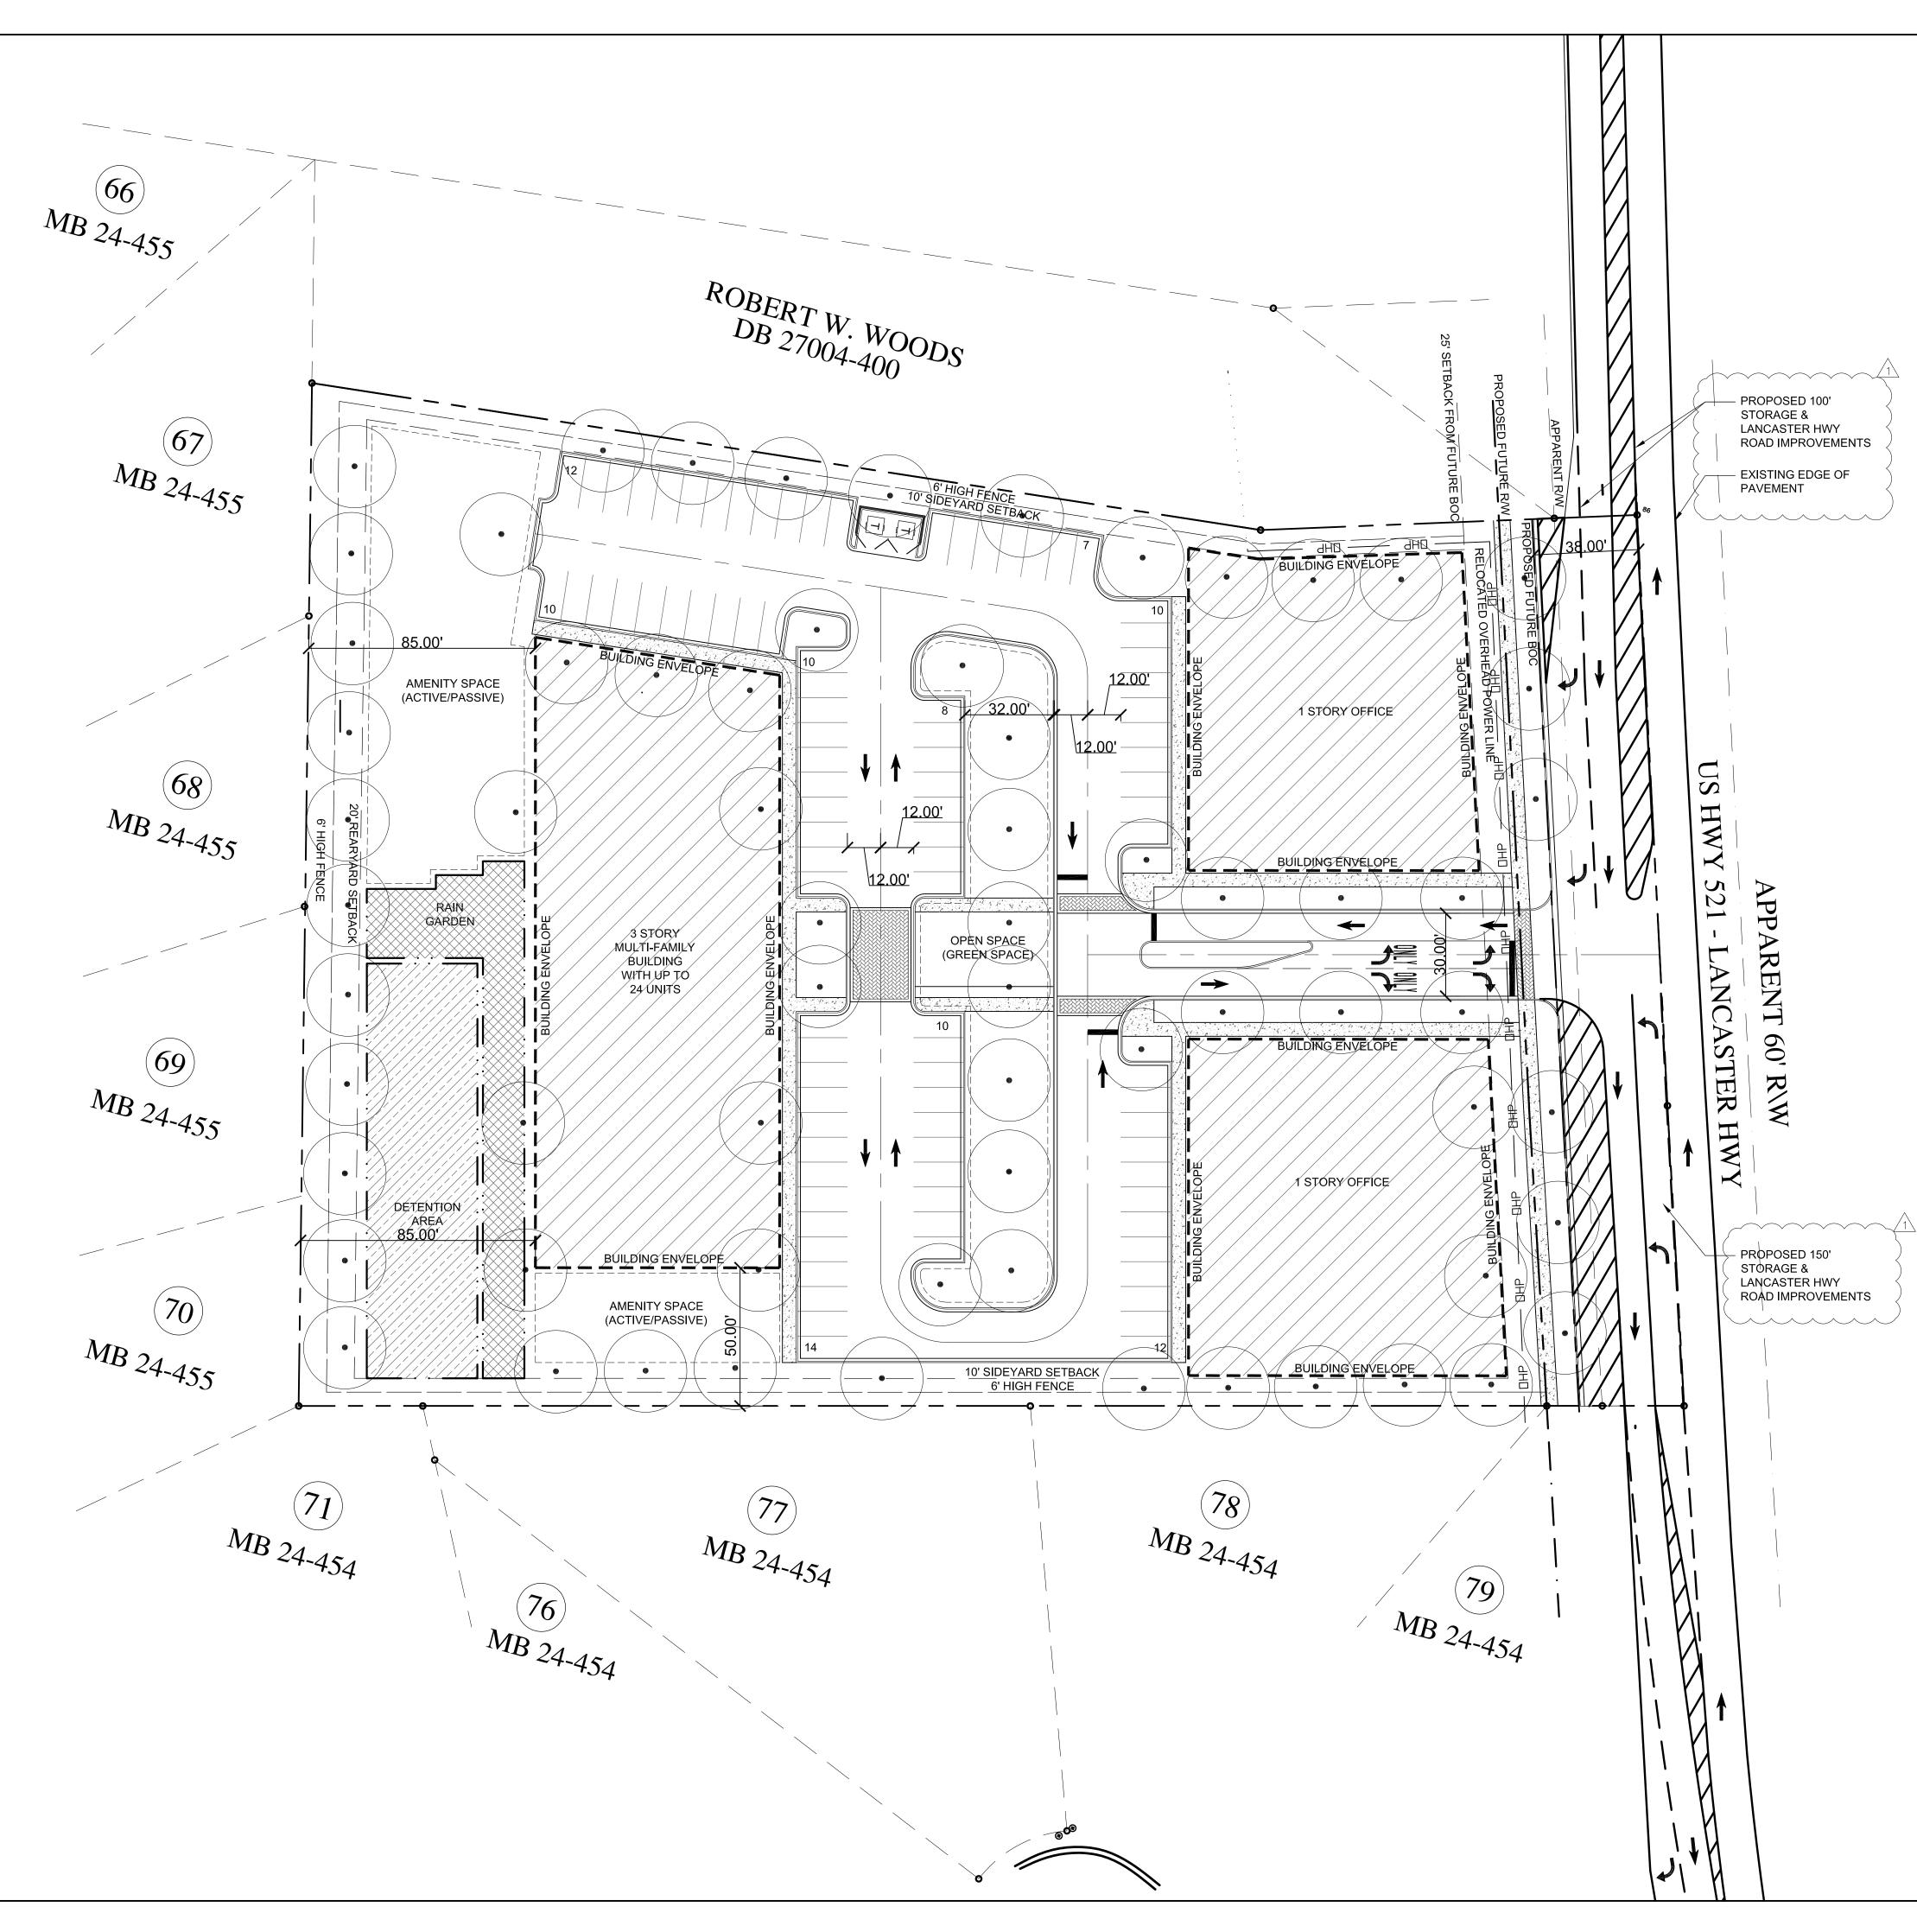

(	~~~~~~			~~~~~	~~~~~~	$\sim$		
$\left\langle \right\rangle$	DEVELOPME	DEVELOPMENT DATA				$\left\{ \right\}$		
	TAX PARCEL ID		223-451-	81				70
$\left\langle \right\rangle$	ZONING JURISD			NBURG COU		,		10 28202
$\left\langle \right\rangle$	TOTAL SITE ACR		. ,		)F EXISTING	FR/W		Charlotte, NC 04.332.3246
	REQUIRED PARI			s (ns dist:				Γĸ _
	PARKING PROVI	DED:	PER DWE OF 1.0 PA GROSS SÇ	LLING UNI' .RKING SPA	PARKING SI F AND A MI CE FOR EAC C OF OFFICE	NIMUM CH 300	Land	2.23 N Granam Street V: 704.333.0325 F: www.LandDesign.com
<pre></pre>	Zoning:						}	
$\left\langle \right\rangle$	EXISTING ZONII	NG:	R8-MF (0	CD)			$\left\{ \right.$	
$\left\langle \right\rangle$	EXISTING USE:		SINGLE F	AMILY DW	ELLING UNI	T		
			(STRUCTI	ure) & vac	CANT LAND		$\left\{ \right\}$	
Ś	PROPOSED ZONI	ING:	NS (NEIG	HBORHOO	D SERVICES	)	$\left\{ \right\}$	
$\left\langle \right\rangle$	PROPOSED USE:				MILY RESID	·	$\left\{ \right.$	
Ś					ND UP TO 10			
					OOR AREA O			
$\left\langle \right\rangle$			GENERAI	AND MED	CAL OFFIC	E USE	$\left\langle \right\rangle$	
$\langle \rangle$			TOGETHE	ER WITH AC	CESSORY US	SES, AS		
$\left\langle \right\rangle$			ALLOWEI	O IN THE N	S ZONING		$\left\{ \right\}$	
<pre></pre>			DISTRICT	Г.			}	
	NEIGHBORHOOD SERVICES DATA:							
(	MIN. SETBACK :	:	25'**					
	MIN. SIDEYARD	):	10'					
	MIN. REARYARI	):	20'					$\widehat{\mathbf{O}}$
	MAX. BLDG HEI	GHT:	*					4-00 I (C)
	*NOT TO EXCEE RESIDENTIAL B FEET FOR THE F BE MEASURED A	UILDING; ANI PROPOSED OFF	) NOT TO EX ICE BUILD	KCEED 0NE INGS, BUIL	(1) STORY A			NING 2014-0
	**25' FROM BAC GREATER	CK OF EXISTIN	G OR PROP	OSED CURB	, WHICHEV	ERIS		LE REZOI
	Legend:						STER UAL S	ARLOT
		Existing tre	EES TO BE S	AVED			ACEPT ACEPT	OF CH.
		Proposed st	REET TREE:	S				CITY
		Proposed wa	ATER QUALI	TY				
		Proposed ra	IN GARDEN	1			COMMENTS	
		Proposed bl	DG ENVELC	)PE			<b>REVISIONS:</b> 09/12/14 - REZONING COMMENTS	
		ION #: 2014-00 OF CHARLOTT	• •		T L L L L L L L L L L L L L L L L L L L		ATE: 06.23.14 ESIGNED BY: LDB RAWN BY: LDB HECKED BY: MB C. BY: MB C. BY: MB C. BY: MB ALE: PER SHEET OJECT #: 1013226	RZ-2
			<b>L</b>	15' 0'	15' 30'	60'	A H H H H H H H H H H H H H H H H H H H	



A	e Development Data:	1.	Arc		
	creage: $\pm 3.62$ acres net of existing right-of-way ( $\pm 3.78$ acres total)	a.	The of the		
Tax Parcel #: 223-451-81 Existing Zoning: R-8MF(CD) (by Rezoning Petition No. 2008-001(c))					
	roposed Zoning: NS		only		
	<b>xisting Uses:</b> A single-family dwelling unit.	b.	No s		
P	<b>roposed Uses:</b> Up to 24 multi-family residential dwelling units and up to 10,000 square feet of gross floor area of general and medical office uses together with accessory uses, as allowed in the NS zoning	c.	The		
N	district.	d.	Met		
not	<b>faximum Building Height:</b> Not to exceed (3) stories or 40 feet for the multi-family residential building; and to exceed one (1) story and 30 feet for the proposed office buildings, building height to be measured as ined by the Ordinance.	e.	HV. prop		
	<b>arking:</b> A minimum of 1.5 parking spaces per dwelling unit and a minimum of 1.0 parking space for each 300 ss square feet of office uses will be provided.	f.	Dur gate mat		
1.	General Provisions:		area		
a.	<b>Site Location</b> . These Development Standards form a part of the Rezoning Plan associated with the Rezoning Petition filed by Southern Apartment Group - Ballantyne, LLC ("Petitioner") to accommodate the development of a 24 unit multi-family community and a small scale professional office park on				
	approximately 3.78 gross acre site (3.62 acres excluding existing road right-of-way) located on the west side of Lancaster Hwy. between Southcrest Lane and Winghurst Drive (the "Site").		Lan		
b.		<b>b</b> .	A <del>fi</del> alon		
Ν.	applicable provisions of the Mecklenburg County Zoning Ordinance (the "Ordinance"). Unless the	$\left\langle \right\rangle$	buff		
	Rezoning Plan establishes more stringent standards the regulations established under the Ordinance for the NS zoning classification shall govern.	с.	The		
C			Rez spac		
c.	Graphics and Alterations. The schematic depictions of the uses, parking areas, sidewalks, structures and buildings, building elevations, streets and other development matters and site elements (collectively the		of th		
	"Development/Site Elements") set forth on the Rezoning Plan should be reviewed in conjunction with the provisions of these Development Standards. The layout, locations, sizes and formulations of the Development/Site Elements depicted on the Rezoning Plan are graphic representations of the Development/Site elements proposed. Changes to the Rezoning Plan not anticipated by the Rezoning Plan will be reviewed and approved as allowed by Section 6.207 of the Ordinance.				
C:		f.	The		
	ce the project has not undergone the design development and construction phases, it is intended that this zoning Plan provide for flexibility in allowing some alterations or modifications from the graphic		Lan side		
rep	resentations of the Development/Site Elements. Therefore, there may be instances where minor modifications 1 be allowed without requiring the Administrative Amendment Process per Section 6.207 of the Ordinance.	G			
These instances would include changes to graphics if they are:		g. h.	Scree Abo		
• expressly permitted by the Rezoning Plan (it is understood that if a modification is expressly permitted by the Rezoning Plan it is deemed a minor modification for the purposes of these Development Standards); or,					
			requ		
	ninor and don't materially change the overall design intent depicted on the Rezoning Plan; or	6.	•		
• r	nodifications to move structures graphically depicted on the Rezoning Plan closer to adjacent properties in a residential district or abutting residential use but no closer than the "building envelope line" indicated on Sheet	<b>6.</b> a.	Env The		
<ul> <li>r</li> <li>r</li> <li>r</li> <li>F</li> <li>r</li> <li>r</li> <li>a</li> </ul>	nodifications to move structures graphically depicted on the Rezoning Plan closer to adjacent properties in a		Env The Ord The revi		
<ul> <li>r</li> <li>r</li> <li>r</li> <li>r</li> <li>a</li> <li>v</li> </ul>	nodifications to move structures graphically depicted on the Rezoning Plan closer to adjacent properties in a residential district or abutting residential use but no closer than the "building envelope line" indicated on Sheet RZ-1; or nodifications to allow changes to the configuration and type of improvements indicated on Sheet RZ-2 to the unenity areas/open spaces as long as the total area of the amenity areas/open spaces is not reduced beyond what is indicated on the Rezoning Plan.	a.	Env The Ord The revi rezo requ		
<ul> <li>rr</li> <li>rr</li> <li>rr</li> <li>aa</li> <li>vv</li> </ul>	nodifications to move structures graphically depicted on the Rezoning Plan closer to adjacent properties in a residential district or abutting residential use but no closer than the "building envelope line" indicated on Sheet RZ-1; or nodifications to allow changes to the configuration and type of improvements indicated on Sheet RZ-2 to the amenity areas/open spaces as long as the total area of the amenity areas/open spaces is not reduced beyond what is indicated on the Rezoning Plan.	a. b.	Env The Ord The revi rezo requ Sign		
<ul> <li>r</li> <li>r</li> <li>r</li> <li>r</li> <li>r</li> <li>a</li> <li>v</li> </ul>	nodifications to move structures graphically depicted on the Rezoning Plan closer to adjacent properties in a residential district or abutting residential use but no closer than the "building envelope line" indicated on Sheet RZ-1; or nodifications to allow changes to the configuration and type of improvements indicated on Sheet RZ-2 to the unenity areas/open spaces as long as the total area of the amenity areas/open spaces is not reduced beyond what is indicated on the Rezoning Plan.	a. b. <b>7.</b>	Env The Ord The revi rezo requ Sign		
<ul> <li>r</li> <li>r</li> <li>r</li> <li>r</li> <li>a</li> <li>v</li> </ul>	nodifications to move structures graphically depicted on the Rezoning Plan closer to adjacent properties in a residential district or abutting residential use but no closer than the "building envelope line" indicated on Sheet RZ-1; or nodifications to allow changes to the configuration and type of improvements indicated on Sheet RZ-2 to the unenity areas/open spaces as long as the total area of the amenity areas/open spaces is not reduced beyond what is indicated on the Rezoning Plan. e Planning Director will determine if such minor modifications are allowed per this amended process, and if it letermined that the alteration does not meet the criteria described above, the Petitioner shall then follow the ministrative Amendment Process per Section 6.207 of the Ordinance; in each instance, however, subject to the itioner's appeal rights set forth in the Ordinance.	a. b. <b>7.</b> a.	Env The Ord The revi rezo requ Sign Sign Ligh All		
<ul> <li>r</li> <li>r</li> <li>r</li> <li>r</li> <li>a</li> <li>v</li> </ul>	<ul> <li>nodifications to move structures graphically depicted on the Rezoning Plan closer to adjacent properties in a residential district or abutting residential use but no closer than the "building envelope line" indicated on Sheet RZ-1; or</li> <li>nodifications to allow changes to the configuration and type of improvements indicated on Sheet RZ-2 to the unenity areas/open spaces as long as the total area of the amenity areas/open spaces is not reduced beyond what is indicated on the Rezoning Plan.</li> <li>e Planning Director will determine if such minor modifications are allowed per this amended process, and if it letermined that the alteration does not meet the criteria described above, the Petitioner shall then follow the ministrative Amendment Process per Section 6.207 of the Ordinance; in each instance, however, subject to the itioner's appeal rights set forth in the Ordinance.</li> <li>Number of Buildings Principal and Accessory. The total number of principal buildings to be developed on the Site shall not exceed four (4). Accessory buildings and structures located on the Site shall not be considered in any limitation on the number of buildings on the Site. Accessory buildings and structures</li> </ul>	a. b. <b>7.</b> a. <b>8.</b>	Env The Ord The revi rezo requ Sign Sign Lig All inst		
<ul> <li>r</li> <li>r</li> <li>r</li> <li>r</li> <li>a</li> <li>v</li> </ul>	<ul> <li>nodifications to move structures graphically depicted on the Rezoning Plan closer to adjacent properties in a residential district or abutting residential use but no closer than the "building envelope line" indicated on Sheet RZ-1; or</li> <li>nodifications to allow changes to the configuration and type of improvements indicated on Sheet RZ-2 to the unenity areas/open spaces as long as the total area of the amenity areas/open spaces is not reduced beyond what is indicated on the Rezoning Plan.</li> <li>e Planning Director will determine if such minor modifications are allowed per this amended process, and if it letermined that the alteration does not meet the criteria described above, the Petitioner shall then follow the ministrative Amendment Process per Section 6.207 of the Ordinance; in each instance, however, subject to the itioner's appeal rights set forth in the Ordinance.</li> <li>Number of Buildings Principal and Accessory. The total number of principal buildings to be developed on the Site shall not exceed four (4). Accessory buildings and structures located on the Site shall not be</li> </ul>	a. b. <b>7.</b> a. <b>8.</b> a. b.	Env The Ord The revi rezo requ Sign Ligl All insta Deta		
<ul> <li>r</li> <li>r</li> <li>r</li> <li>r</li> <li>a</li> <li>v</li> <li>The</li> <li>is d</li> <li>Adi</li> <li>Pet:</li> </ul>	<ul> <li>nodifications to move structures graphically depicted on the Rezoning Plan closer to adjacent properties in a esidential district or abutting residential use but no closer than the "building envelope line" indicated on Sheet RZ-1; or</li> <li>nodifications to allow changes to the configuration and type of improvements indicated on Sheet RZ-2 to the menity areas/open spaces as long as the total area of the amenity areas/open spaces is not reduced beyond what is indicated on the Rezoning Plan.</li> <li>e Planning Director will determine if such minor modifications are allowed per this amended process, and if it letermined that the alteration does not meet the criteria described above, the Petitioner shall then follow the ministrative Amendment Process per Section 6.207 of the Ordinance; in each instance, however, subject to the itioner's appeal rights set forth in the Ordinance.</li> <li>Number of Buildings Principal and Accessory. The total number of principal buildings to be developed on the Site shall not exceed four (4). Accessory buildings and structures located on the Site shall not be considered in any limitation on the number of buildings on the Site. Accessory buildings and structures will be constructed utilizing similar building materials, colors, architectural elements and designs as the</li> </ul>	<ul> <li>a.</li> <li>b.</li> <li>7.</li> <li>a.</li> <li>8.</li> <li>a.</li> <li>b.</li> <li>9.</li> </ul>	Env The Ord The revi requ Sigr Sigr Lig All insta Deta Am		
<ul> <li>r</li> <li>r</li> <li>r</li> <li>r</li> <li>a</li> <li>v</li> <li>The</li> <li>is c</li> <li>Adi</li> <li>Pet:</li> <li>d.</li> <li>2.</li> </ul>	<ul> <li>nodifications to move structures graphically depicted on the Rezoning Plan closer to adjacent properties in a esidential district or abutting residential use but no closer than the "building envelope line" indicated on Sheet RZ-1; or</li> <li>nodifications to allow changes to the configuration and type of improvements indicated on Sheet RZ-2 to the unenity areas/open spaces as long as the total area of the amenity areas/open spaces is not reduced beyond what is indicated on the Rezoning Plan.</li> <li>e Planning Director will determine if such minor modifications are allowed per this amended process, and if it letermined that the alteration does not meet the criteria described above, the Petitioner shall then follow the ministrative Amendment Process per Section 6.207 of the Ordinance; in each instance, however, subject to the itioner's appeal rights set forth in the Ordinance.</li> <li>Number of Buildings Principal and Accessory. The total number of principal buildings to be developed on the Site shall not exceed four (4). Accessory buildings and structures located on the Site shall not be considered in any limitation on the number of buildings on the Site. Accessory buildings and structures will be constructed utilizing similar building materials, colors, architectural elements and designs as the principal building located on the Site.</li> </ul>	a. b. <b>7.</b> a. <b>8.</b> a. b.	Env Env The Ord The revi rezo requ Sigr Lig All insta Deta Am Futu by 1		
<ul> <li>r</li> <li>r</li> <li>r</li> <li>r</li> <li>a</li> <li>v</li> <li>The</li> <li>is c</li> <li>Adi</li> <li>Pet:</li> <li>d.</li> </ul>	<ul> <li>nodifications to move structures graphically depicted on the Rezoning Plan closer to adjacent properties in a esidential district or abutting residential use but no closer than the "building envelope line" indicated on Sheet RZ-1; or</li> <li>nodifications to allow changes to the configuration and type of improvements indicated on Sheet RZ-2 to the immenity areas/open spaces as long as the total area of the amenity areas/open spaces is not reduced beyond what is indicated on the Rezoning Plan.</li> <li>e Planning Director will determine if such minor modifications are allowed per this amended process, and if it letermined that the alteration does not meet the criteria described above, the Petitioner shall then follow the ministrative Amendment Process per Section 6.207 of the Ordinance; in each instance, however, subject to the itioner's appeal rights set forth in the Ordinance.</li> <li>Number of Buildings Principal and Accessory. The total number of principal buildings to be developed on the Site shall not exceed four (4). Accessory buildings and structures located on the Site shall not be considered in any limitation on the number of buildings on the Site. Accessory buildings and structures will be constructed utilizing similar building materials, colors, architectural elements and designs as the principal building located on the Site.</li> </ul>	<ul> <li>a.</li> <li>b.</li> <li>7.</li> <li>a.</li> <li>8.</li> <li>a.</li> <li>b.</li> <li>9.</li> <li>a.</li> <li>10.</li> </ul>	Env Env The Ord The revi rezo requ Sign Sign Ligl All insta Deta <u>Ann</u> Futu by t ame <u>Bino</u>		
<ul> <li>r</li> <li>r</li> <li>r</li> <li>r</li> <li>r</li> <li>a</li> <li>v</li> <li>The</li> <li>is c</li> <li>Adi</li> <li>Pet:</li> <li>d.</li> <li>2.</li> </ul>	<ul> <li>nodifications to move structures graphically depicted on the Rezoning Plan closer to adjacent properties in a esidential district or abutting residential use but no closer than the "building envelope line" indicated on Sheet RZ-1; or</li> <li>nodifications to allow changes to the configuration and type of improvements indicated on Sheet RZ-2 to the unenity areas/open spaces as long as the total area of the amenity areas/open spaces is not reduced beyond what is indicated on the Rezoning Plan.</li> <li>e Planning Director will determine if such minor modifications are allowed per this amended process, and if it letermined that the alteration does not meet the criteria described above, the Petitioner shall then follow the ministrative Amendment Process per Section 6.207 of the Ordinance; in each instance, however, subject to the itioner's appeal rights set forth in the Ordinance.</li> <li>Number of Buildings Principal and Accessory. The total number of principal buildings to be developed on the Site shall not exceed four (4). Accessory buildings and structures located on the Site shall not be constructed utilizing similar building materials, colors, architectural elements and designs as the principal building located on the Site.</li> <li>Permitted Uses &amp; Development Area Limitation :</li> </ul>	<ul> <li>a.</li> <li>b.</li> <li>7.</li> <li>a.</li> <li>8.</li> <li>a.</li> <li>b.</li> <li>9.</li> <li>a.</li> </ul>	required for the second		
<ul> <li>r</li> <li>r</li> <li>r</li> <li>r</li> <li>a</li> <li>v</li> <li>The</li> <li>is d</li> <li>Adi</li> <li>Pet</li> <li>d.</li> <li>2.</li> <li>a.</li> </ul>	<ul> <li>nodifications to move structures graphically depicted on the Rezoning Plan closer to adjacent properties in a esidential district or abutting residential use but no closer than the "building envelope line" indicated on Sheet RZ-1; or</li> <li>nodifications to allow changes to the configuration and type of improvements indicated on Sheet RZ-2 to the menity areas/open spaces as long as the total area of the amenity areas/open spaces is not reduced beyond what is indicated on the Rezoning Plan.</li> <li>e Planning Director will determine if such minor modifications are allowed per this amended process, and if it determined that the alteration does not meet the criteria described above, the Petitioner shall then follow the ministrative Amendment Process per Section 6.207 of the Ordinance; in each instance, however, subject to the itioner's appeal rights set forth in the Ordinance.</li> <li>Number of Buildings Principal and Accessory. The total number of principal buildings to be developed on the Site shall not exceed four (4). Accessory buildings and structures located on the Site shall not be considered in any limitation on the number of buildings on the Site. Accessory buildings and structures will be constructed utilizing similar building materials, colors, architectural elements and designs as the principal building located on the Site.</li> <li>Permitted Uses &amp; Development Area Limitation :</li> <li>The Site may be developed with up to 24 multi-family residential dwellings units and up to 10,000 square feet of gross floor area of general and medical office uses together with accessory uses allowed in the NS zoning district.</li> </ul>	<ul> <li>a.</li> <li>b.</li> <li>7.</li> <li>a.</li> <li>8.</li> <li>a.</li> <li>9.</li> <li>a.</li> <li>10.</li> </ul>	Env Env The Ord The revi rezo requ Sigr Ligl All insta Deta All insta Deta Env If th the inur		
<ul> <li>r</li> <li>r</li> <li>r</li> <li>r</li> <li>r</li> <li>a</li> <li>v</li> <li>The</li> <li>is c</li> <li>Adr</li> <li>Pet:</li> <li>d.</li> <li>2.</li> <li>a.</li> <li>b.</li> <li>3.</li> </ul>	<ul> <li>nodifications to move structures graphically depicted on the Rezoning Plan closer to adjacent properties in a esidential district or abutting residential use but no closer than the "building envelope line" indicated on Sheet RZ-1; or</li> <li>nodifications to allow changes to the configuration and type of improvements indicated on Sheet RZ-2 to the unenity areas/open spaces as long as the total area of the amenity areas/open spaces is not reduced beyond what is indicated on the Rezoning Plan.</li> <li>Planning Director will determine if such minor modifications are allowed per this amended process, and if it letermined that the alteration does not meet the criteria described above, the Petitioner shall then follow the ministrative Amendment Process per Section 6.207 of the Ordinance; in each instance, however, subject to the itioner's appeal rights set forth in the Ordinance.</li> <li>Number of Buildings Principal and Accessory. The total number of principal buildings to be developed on the Site shall not exceed four (4). Accessory buildings and structures located on the Site shall not exceed four (4). Accessory buildings on the Site. Accessory buildings and structures will be constructed utilizing similar building materials, colors, architectural elements and designs as the principal building located on the Site.</li> <li>Permitted Uses &amp; Development Area Limitation :</li> <li>The Site may be developed with up to 24 multi-family residential dwellings units and up to 10,000 square feet of gross floor area of general and medical office uses together with accessory uses allowed in the NS zoning district.</li> <li>Surface parking areas will not be allowed between Lancaster Highway and the proposed buildings.</li> </ul>	<ul> <li>a.</li> <li>b.</li> <li>7.</li> <li>a.</li> <li>8.</li> <li>a.</li> <li>9.</li> <li>a.</li> <li>10.</li> </ul>	Env Env The Ord The revi rezo requ Sigr Ligl All insta Deta All insta Deta Env U If the the the Cord Cor		
<ul> <li>r</li> <li>r</li> <li>r</li> <li>r</li> <li>r</li> <li>a.</li> </ul>	<ul> <li>modifications to move structures graphically depicted on the Rezoning Plan closer to adjacent properties in a esidential district or abutting residential use but no closer than the "building envelope line" indicated on Sheet RZ-1; or</li> <li>modifications to allow changes to the configuration and type of improvements indicated on Sheet RZ-2 to the menity areas/open spaces as long as the total area of the amenity areas/open spaces is not reduced beyond what is indicated on the Rezoning Plan.</li> <li>e Planning Director will determine if such minor modifications are allowed per this amended process, and if it letermined that the alteration does not meet the criteria described above, the Petitioner shall then follow the ministrative Amendment Process per Section 6.207 of the Ordinance; in each instance, however, subject to the itioner's appeal rights set forth in the Ordinance.</li> <li>Number of Buildings Principal and Accessory. The total number of principal buildings to be developed on the Site shall not exceed four (4). Accessory buildings on the Site. Accessory buildings and structures will be constructed utilizing similar building materials, colors, architectural elements and designs as the principal building located on the Site.</li> <li>Permitted Uses &amp; Development Area Limitation :</li> <li>The Site may be developed with up to 24 multi-family residential dwellings units and up to 10,000 square feet of gross floor area of general and medical office uses together with accessory uses allowed in the NS zoning district.</li> <li>Surface parking areas will not be allowed between Lancaster Highway and the proposed buildings.</li> <li>Access to the Site will be from Lancaster Highway in the manner generally depicted on the Rezoning Plan.</li> </ul>	<ul> <li>a.</li> <li>b.</li> <li>7.</li> <li>a.</li> <li>8.</li> <li>a.</li> <li>9.</li> <li>a.</li> <li>10.</li> </ul>	Env Env The Ord The revi rezo requ Sigr Ligl All insta Deta All insta Deta Env If th the inur		
<ul> <li>r</li> <li>r</li> <li>r</li> <li>r</li> <li>r</li> <li>a.</li> </ul>	<ul> <li>nodifications to move structures graphically depicted on the Rezoning Plan closer to adjacent properties in a esidential district or abutting residential use but no closer than the "building envelope line" indicated on Sheet RZ-1; or</li> <li>nodifications to allow changes to the configuration and type of improvements indicated on Sheet RZ-2 to the unenity areas/open spaces as long as the total area of the amenity areas/open spaces is not reduced beyond what is indicated on the Rezoning Plan.</li> <li>Planning Director will determine if such minor modifications are allowed per this amended process, and if it letermined that the alteration does not meet the criteria described above, the Petitioner shall then follow the ministrative Amendment Process per Section 6.207 of the Ordinance; in each instance, however, subject to the itioner's appeal rights set forth in the Ordinance.</li> <li>Number of Buildings Principal and Accessory. The total number of principal buildings to be developed on the Site shall not exceed four (4). Accessory buildings and structures located on the Site shall not exceed four (4). Accessory buildings on the Site. Accessory buildings and structures will be constructed utilizing similar building materials, colors, architectural elements and designs as the principal building located on the Site.</li> <li>Permitted Uses &amp; Development Area Limitation :</li> <li>The Site may be developed with up to 24 multi-family residential dwellings units and up to 10,000 square feet of gross floor area of general and medical office uses together with accessory uses allowed in the NS zoning district.</li> <li>Surface parking areas will not be allowed between Lancaster Highway and the proposed buildings.</li> </ul>	<ul> <li>a.</li> <li>b.</li> <li>7.</li> <li>a.</li> <li>8.</li> <li>a.</li> <li>9.</li> <li>a.</li> <li>10.</li> </ul>	Env Env The Ord The revi rezo requ Sigr Ligl All insta Deta All insta Deta Env If th the inur		
<ul> <li>r</li> <li>r</li> <li>r</li> <li>r</li> <li>r</li> <li>a.</li> <li>t</li> <li>t</li></ul>	<ul> <li>modifications to move structures graphically depicted on the Rezoning Plan closer to adjacent properties in a esidential district or abutting residential use but no closer than the "building envelope line" indicated on Sheet <i>IZ-1</i>; or</li> <li>modifications to allow changes to the configuration and type of improvements indicated on Sheet <i>RZ-2</i> to the menity areas/open spaces as long as the total area of the amenity areas/open spaces is not reduced beyond what is indicated on the Rezoning Plan.</li> <li>Planning Director will determine if such minor modifications are allowed per this amended process, and if it determined that the alteration does not meet the criteria described above, the Petitioner shall then follow the ministrative Amendment Process per Section 6.207 of the Ordinance; in each instance, however, subject to the itioner's appeal rights set forth in the Ordinance.</li> <li>Number of Buildings Principal and Accessory. The total number of principal buildings to be developed on the Site shall not exceed four (4). Accessory buildings and structures located on the Site shall not be constructed utilizing similar building materials, colors, architectural elements and designs as the principal building located on the Site.</li> <li>Permitted Uses &amp; Development Area Limitation :</li> <li>The Site may be developed with up to 24 multi-family residential dwellings units and up to 10,000 square feet of gross floor area of general and medical office uses together with accessory uses allowed in the NS zoning district.</li> <li>Surface parking areas will not be allowed between Lancaster Highway and the proposed buildings.</li> <li>Access to the Site will be from Lancaster Highway in the manner generally depicted on the Rezoning Plan.</li> <li>The Petitioner will dedicate in fee-simple to the City of Charlotte up to 50 feet of right-of-way from the center line of Lancaster Highway. This right-of-way dedication will occur prior to the issuance of a</li> </ul>	<ul> <li>a.</li> <li>b.</li> <li>7.</li> <li>a.</li> <li>8.</li> <li>a.</li> <li>9.</li> <li>a.</li> <li>10.</li> </ul>	Env Env The Ord The revi rezo requ Sign Lig All inst Det All inst Det Env Sign Lig Inst		

required to accommodate final site development and construction plans and to any adjustments required for approval by the CDOT or NCDOT in accordance with applicable published standards.

e. d. The alignment of the internal vehicular circulation and driveways may be modified by the Petitioner to accommodate changes in traffic patterns, parking layouts and any adjustments required for approval by CDOT in accordance with published standards.

hitectural Standards:	
building materials used on the principal buildings constructed on Site will be a combination of portions ne following: brick, stone, precast stone, precast concrete, synthetic stone, cementatious siding (such as i-plank), stucco, EIFS, decorative block and/or wood. Vinyl or aluminum as a building material may be used on windows, soffits and on handrails/railings.	arlotte, NC 28202
pans of blank, unarticulated walls greater than 20 feet will be allowed along Lancaster Highway.	harlott 4.332.3
roofs on the buildings will be constructed utilizing architectural shingles.	eet C
er banks will be screened from adjoining properties and from Lancaster Highway.	am Str .0325 Design.
AC and related mechanical equipment will be screened from public view and from view of adjacent erties at grade.	Landbesign.com
apster areas and recycling areas will be enclosed by a solid wall or fence with one side being a decorative. The wall or fence used to enclose the dumpster will be architecturally compatible with the building erials and colors used on the principal building. The location of the proposed dumpster and recycling is generally depicted on the Rezoning Plan.	
etscape, Buffers, Open Space, Yards and Landscaping:	<u></u>
ng Lancaster Highway a 14-25 foot setback measured from the back of the future right-of-way line of caster Highwaycurb will be provided as generally depicted on the Rezoning Plan.	
we (5)10 foot vegetative screen Class C Buffer with a decorative solid six (6) foot fence will be provided g the Site's perimeter as generally depicted on the Rezoning Plan. The trees planted within the Class C er will be evergreen trees and will be a minimum of eight (8) feet tall at installation.	
Petitioner has identified on the Rezoning Plan several open space areas as generally depicted on the oning Plan. These open space areas may include existing trees as well as new landscaping. These open e areas will be improved with seating areas landscaping and other features for the residents and tenants e Site.	
ties may cross the vegetative screen area at angles no greater than 75 degrees.	$\wedge$
Petitioner will provide a five-six (56) foot sidewalk and an eight (8) planting strip as along the Site's tage on Lancaster Highway Road in the manner generally depicted on the Rezoning Plan.	)
Petitioner will provide a sidewalk network that connects the buildings on the Site to the sidewalk along caster Highway in the manner depicted on the Rezoning Plan. The minimum width for this internal walk will be five (5) feet.	
ening requirements of the Ordinance will be met.	
ve ground backflow preventers will be screened from public view and will be located outside of the ired setbacks.	
ironmental Features:	
Petitioner shall comply with the Mecklenburg County approved and adopted Post Construction Controls nance.	, C
location, size and type of storm water management systems depicted on the Rezoning Plan are subject to ew and approval as part of the full development plan submittal and are not implicitly approved with this ning. Adjustments may be necessary in order to accommodate actual storm water treatment irements and natural site discharge points.	JRG COUNTY 2014-001(C)
age:	NBU ZG
age as allowed by the Ordinance will be provided.	! Ш 🚝
nting:	
new lighting shall be full cut-off type lighting fixtures excluding lower, decorative lighting that may be lled along the driveways, sidewalks, and parking areas.	
ched lighting on the Site will be limited to 15 feet in height.	
endments to the Rezoning Plan:	STI AL D RTMEN
re amendments to the Rezoning Plan (which includes these Development Standards) may be applied for he then Owner or Owners of the applicable Development Area portion of the Site affected by such ndment in accordance with the provisions of Chapter 6 of the Ordinance.	
ling Effect of the Rezoning Application :	N HERN
is Rezoning Petition is approved, all conditions applicable to the development of the Site imposed under Rezoning Plan will, unless amended in the manner provided under the Ordinance, be binding upon and e to the benefit of the Petitioner and subsequent owners of the Site and their respective heirs, devisees, onal representatives, successors in interest or assigns.	
	LTS NTS
	COMMENTS
	U D N
	<b>REVISIONS:</b> 09/12/14 - REZONING C
	<b>REVISIONS</b> : 09/12/14 - R
	REV 09/1
	4 :: LDB MB HEET 013226

PETITION #: 2014-001(C) CITY OF CHARLOTTE

RALET #:

DESIG





# PROPOSED OFFICE ELEVATION

NOTE: THESE ELEVATIONS ARE PROVIDED TO REFLECT THE ARCHITECTURAL STYLE AND QUALITY OF THE BUILDINGS THAT MAY BE CONSTRUCTED ON THE SITE (THE ACTUAL BUILDINGS CONSTRUCTED ON THE SITE MAY VARY FROM THESE ILLUSTRATIONS AS LONG AS THE GENERAL ARCHITECTURAL CONCEPTS AND INTENT ILLUSTRATED IS MAINTAINED).

LandDesign       223 N Graham Street Charlotte, NC 28202	V: 704.333.0325 F: 704.332.3246 www.LandDesign.com
WATTS LEAF ARCHIT 101 North McDowell Stree Charlotte, North Caroli PH 704 376 1200 FX 7	na 28204
LANCASTER HWY CONCEPTUAL ARCHITECTURAL ELEVATIONS SOUTHERN APARTMENT GROUP; MECKLENBURG COUNTY	CITY OF CHARLOTTE REZONING 2014-001(C)
REVISIONS: 09/12/14 - REZONING COMMENTS	
DATE: 06.23.14 DESIGNED BY: LDB DRAWN BY: LDB CHECKED BY: MB Q.C. BY: MB Q.C. BY: MB SCALE: PER SHEET PROJECT #: 1013226	RZ-4

PETITION #: 2014-001(C) CITY OF CHARLOTTE