
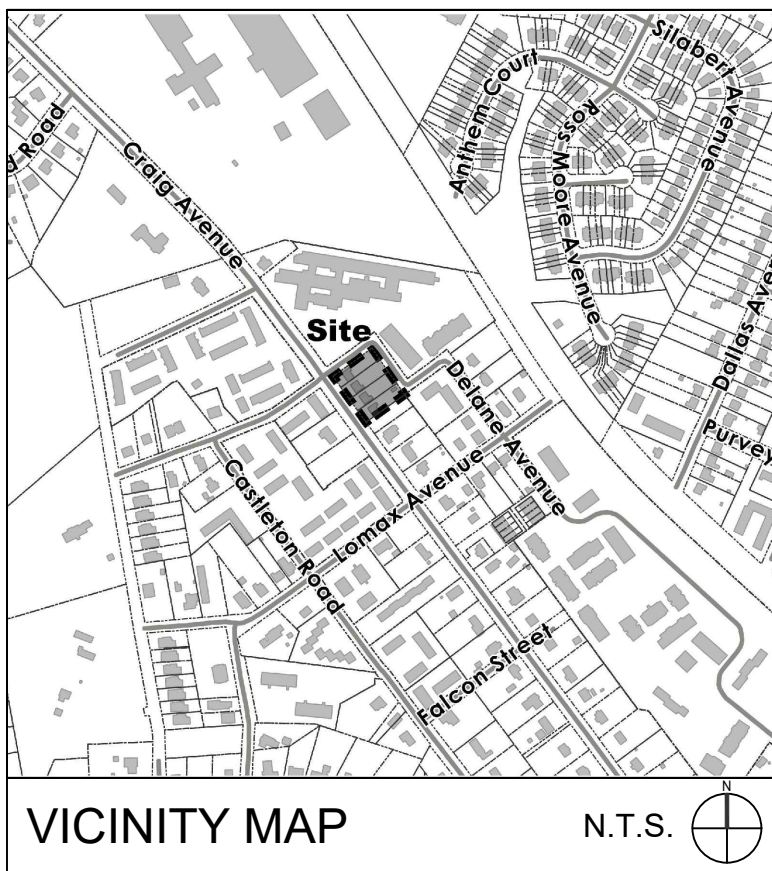


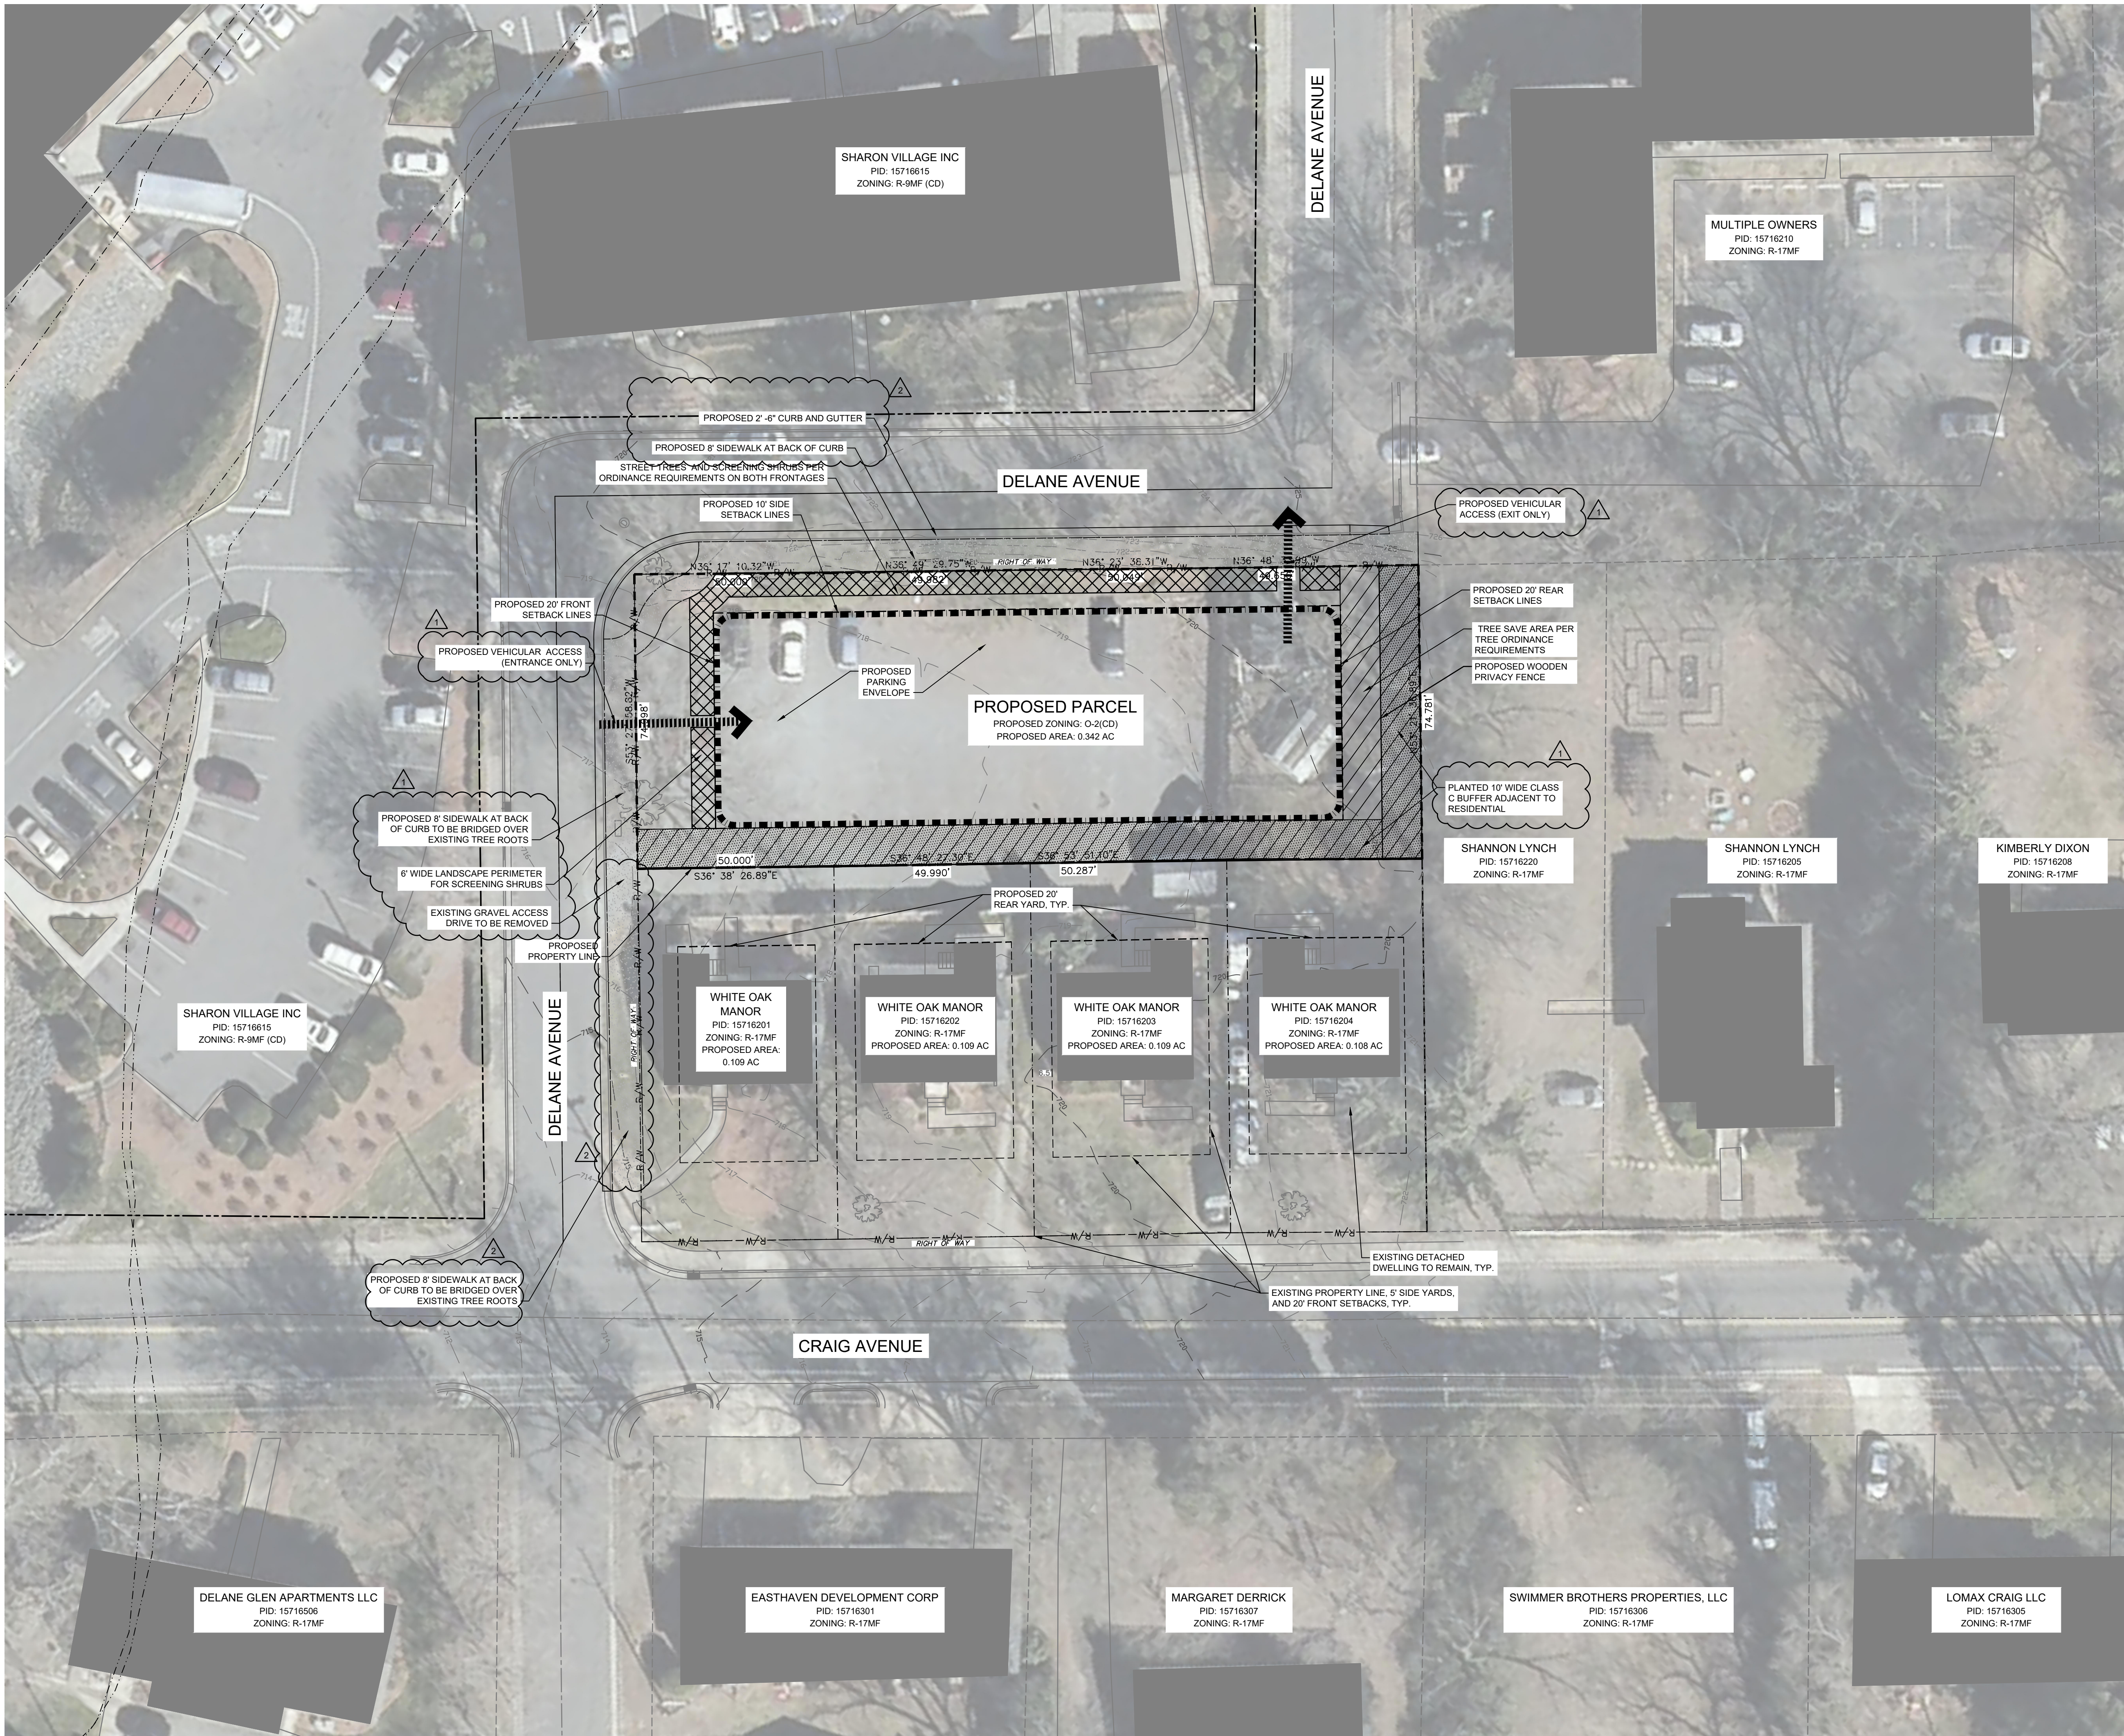

SURVEY DISCLAIMER
BACKGROUND INFORMATION PROVIDED BY MECKLENBURG COUNTY GIS AND PLANNING TRICS.

LEGEND	
SYMBOL	
	PROPOSED REZONING BOUNDARY
	PROPOSED PROPERTY LINE
	PROPOSED SETBACK LINE
	APPROXIMATE VEHICULAR CONNECTIONS
	PROPOSED LANDSCAPE BUFFER
	PROPOSED TREE SAVE AREA

SITE DATA:	
TAX PARCELS:	15716201 15716202 15716203 15716204 +/- 0.777 AC
TOTAL SITE ACREAGE:	0.342 AC
PROPOSED PARCEL ZONING:	O-2(CD)
PROPOSED PARCEL ACREAGE:	0.342 AC
EXISTING ZONING:	R-17MF
EXISTING USES:	SINGLE FAMILY
*REFER TO DEVELOPMENT STANDARD NOTES ON THIS SHEET FOR FURTHER INFORMATION.	
TREE SAVE CALCULATIONS:	
TOTAL SITE AREA:	0.342 AC
TREE SAVE REQUIRED:	0.05 AC
TREE SAVE PROVIDED:	0.076 AC

DEVELOPMENT STANDARDS:

1. GENERAL PROVISIONS

- THESE DEVELOPMENT STANDARDS FORM A PART OF THE REZONING PLAN ASSOCIATED WITH THE REZONING PETITION FILED BY WHITE OAK MANAGEMENT, INC. (HEREINAFTER REFERRED TO AS THE "PETITIONER") FOR AN APPROXIMATELY .764 ACRE SITE LOCATED ON THE WEST SIDE OF DELANE AVENUE, EAST OF THE INTERSECTION OF CRAIG AVENUE AND DELANE AVENUE, WHICH SITE IS MORE PARTICULARLY DEPICTED ON THE REZONING PLAN (HEREINAFTER REFERRED TO AS THE "SITE"). THE SITE IS COMPRISED OF PORTIONS OF TAX PARCEL NOS. 157-162-01, 157-162-02, 157-162-03 AND 157-162-04.
- DEVELOPMENT OF THE SITE WILL BE GOVERNED BY THE REZONING PLAN, THESE DEVELOPMENT STANDARDS AND THE APPLICABLE PROVISIONS OF THE CITY OF CHARLOTTE ZONING ORDINANCE (THE "ORDINANCE").
- UNLESS THE REZONING PLAN OR THESE DEVELOPMENT STANDARDS ESTABLISH MORE STRINGENT STANDARDS, THE REGULATIONS ESTABLISHED UNDER THE ORDINANCE FOR THE O-2 ZONING DISTRICT SHALL GOVERN ALL DEVELOPMENT TAKING PLACE ON THE SITE.
- FUTURE AMENDMENTS TO THE REZONING PLAN AND/OR THESE DEVELOPMENT STANDARDS MAY BE APPLIED FOR BY THE THEN OWNER OR OWNERS OF THE SITE IN ACCORDANCE WITH THE PROVISIONS OF CHAPTER 6 OF THE ORDINANCE. ALTERATIONS TO THE REZONING PLAN ARE SUBJECT TO SECTION 6.207 OF THE ORDINANCE.

2. PERMITTED USES/DEVELOPMENT LIMITATIONS

- THE SITE MAY BE DEVOTED ONLY TO OFF-STREET SURFACE PARKING THAT WILL SERVE THE USES LOCATED ON TAX PARCEL NO. 157-166-15.

3. TRANSPORTATION

- VEHICULAR ACCESS SHALL BE AS GENERALLY DEPICTED ON THE REZONING PLAN. THE PLACEMENT AND CONFIGURATION OF THE ACCESS POINTS ARE SUBJECT TO ANY MINOR MODIFICATIONS REQUIRED BY THE CHARLOTTE DEPARTMENT OF TRANSPORTATION ("CDOT").
- THE ALIGNMENTS OF THE INTERNAL VEHICULAR CIRCULATION AREAS AND THE DRIVEWAYS MAY BE MODIFIED BY PETITIONER TO ACCOMMODATE CHANGES IN TRAFFIC PATTERNS, PARKING LAYOUTS AND ANY ADJUSTMENTS REQUIRED FOR APPROVAL BY CDOT IN ACCORDANCE WITH APPLICABLE PUBLISHED STANDARDS.
- PRIOR TO USE OF THE PARKING LOT TO BE CONSTRUCTED ON THE SITE, PETITIONER SHALL DEDICATE AND CONVEY TO THE CITY OF CHARLOTTE THOSE PORTIONS OF THE SITE LOCATED IMMEDIATELY ADJACENT TO DELANE AVENUE AS REQUIRED TO PROVIDE RIGHT OF WAY MEASURING, WHERE FEASIBLE, TO TWO FEET BEHIND BACK OF SIDEWALK AS MORE PARTICULARLY DEPICTED ON THE REZONING PLAN, TO THE EXTENT THAT SUCH RIGHT OF WAY DOES NOT ALREADY EXIST.
- ALL REQUIRED TRANSPORTATION IMPROVEMENTS SHALL BE CONSTRUCTED AND APPROVED PRIOR TO USE OF THE PARKING LOT TO BE CONSTRUCTED ON THE SITE.

4. STREETSCAPE/LANDSCAPING/BUFFERS

- BUFFERS SHALL BE ESTABLISHED ON THE SITE AS REQUIRED BY THE ORDINANCE AND AS DEPICTED ON THE REZONING PLAN, AND SUCH BUFFERS SHALL CONFORM TO THE STANDARDS OF SECTION 12.302 OF THE ORDINANCE. THE WIDTH OF ANY REQUIRED BUFFER MAY BE REDUCED BY 25% IF A WALL, FENCE OR BERM IS PROVIDED THAT MEETS THE REQUIREMENTS OF SECTION 12.302(b) OF THE ORDINANCE.

- IN THE EVENT THAT AN ADJACENT PARCEL OF LAND IS EITHER REZONED TO A ZONING DISTRICT OR DEVOTED TO A USE THAT ELIMINATES OR REDUCES THE BUFFER REQUIREMENTS ON THE SITE, PETITIONER MAY REDUCE OR ELIMINATE, AS THE CASE MAY BE, THE RELEVANT BUFFER AREAS ACCORDINGLY.

- SIDEWALKS AND PLANTING STRIPS SHALL BE INSTALLED ALONG THE SITE'S PUBLIC STREET FRONTAGE AS GENERALLY DEPICTED ON THE REZONING PLAN.

5. ENVIRONMENTAL

- DEVELOPMENT OF THE SITE SHALL COMPLY WITH THE CITY OF CHARLOTTE TREE ORDINANCE.

6. LIGHTING

- ANY FREESTANDING LIGHTING FIXTURES INSTALLED ON SITE SHALL HAVE A MAXIMUM HEIGHT OF 21 FEET, AND ALL SUCH FREESTANDING LIGHTING FIXTURES SHALL BE FULLY CAPPED AND SHIELDED AND THE ILLUMINATION DOWNWARDLY DIRECTED SO THAT DIRECT ILLUMINATION DOES NOT EXTEND PAST ANY PROPERTY LINE OF THE SITE.

7. BINDING EFFECT OF THE REZONING DOCUMENTS AND DEFINITIONS


- IF THIS REZONING PETITION IS APPROVED, ALL CONDITIONS APPLICABLE TO THE USE AND DEVELOPMENT OF THE SITE IMPOSED UNDER THESE DEVELOPMENT STANDARDS AND THE REZONING PLAN WILL, UNLESS AMENDED IN THE MANNER PROVIDED UNDER THE ORDINANCE, BE BINDING UPON AND INURE TO THE BENEFIT OF PETITIONER AND THE CURRENT AND SUBSEQUENT OWNERS OF THE SITE AND THEIR RESPECTIVE SUCCESSORS IN INTEREST AND ASSIGNS.
- THROUGHOUT THESE DEVELOPMENT STANDARDS, THE TERM "PETITIONER" SHALL BE DEEMED TO INCLUDE THE HEIRS, DEVISEES, PERSONAL REPRESENTATIVES, SUCCESSORS IN

INTEREST AND ASSIGNS OF PETITIONER OR THE OWNER OR OWNERS OF THE SITE FROM TIME TO TIME WHO MAY BE INVOLVED IN ANY FUTURE DEVELOPMENT THEREOF.

- ANY REFERENCE TO THE ORDINANCE HEREIN SHALL BE DEEMED TO REFER TO THE REQUIREMENTS OF THE ORDINANCE IN EFFECT AS OF THE DATE THIS REZONING PETITION IS APPROVED.



- CONTRACTOR IS RESPONSIBLE FOR PLACEMENT OF ALL BARRICADES, SIGNAGE, FLAGGERS, SHORING, ETC., TO ENSURE THE SAFETY OF WORKERS AND THE PUBLIC.
- ALL PAVEMENT CUTS SHALL BE REPLACED ACCORDING TO NORTH CAROLINA DEPARTMENT OF TRANSPORTATION AND CHARLOTTE WATER.

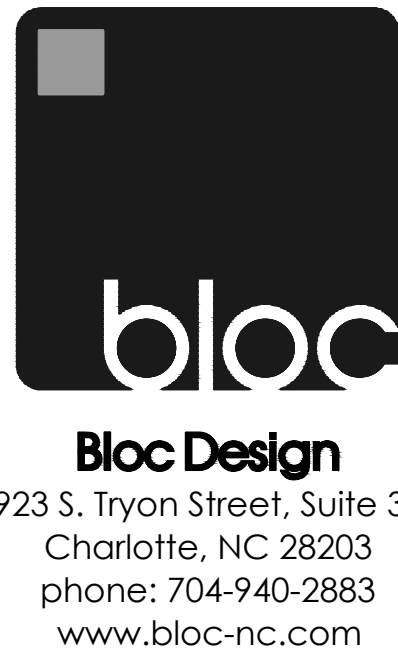


landscape architecture | planning | civil engineering

REVISIONS		
NO.	DATE	DESCRIPTION
1	6/21/18	AMENDED REZONING PLAN
2	12/18/18	REZONING HEARING REVISIONS

Disclaimer ©2017:
Information contained in this document is the property of Bloc Design, PLLC, and the project client listed on this document.
The reproduction, copying, and other use without written consent is prohibited and may be subject to legal action to the fullest extent possible.


stamp / seal:

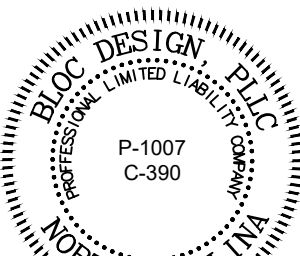

ISSUED FOR CONSTRUCTION	
MANAGING PARTNER (PE):	DATE: _____
MANAGING PARTNER (IA):	DATE: _____
CIVIL ENGINEER/DESIGNER:	DATE: _____
LANDS, ARCHITECT/DESIGNER:	DATE: _____



Craig Ave Rezoning
4101-4113 Craig Ave
Charlotte, NC 28211

REZONING PETITION #:
2018-058

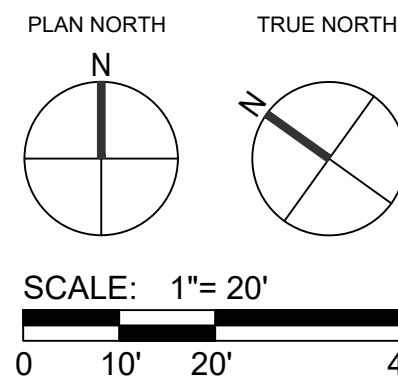

DATE: 04/20/18	MPIC: WLL
DRAWN BY: ESB	CHECKED BY: CCB/HKG
PROJECT NUMBER: 00433.00	
SCALE: 1"=20'	
TITLE: DEVELOPMENT PLAN & DEVELOPMENT STANDARD NOTES	

SHEET NO:
RZ-1.0

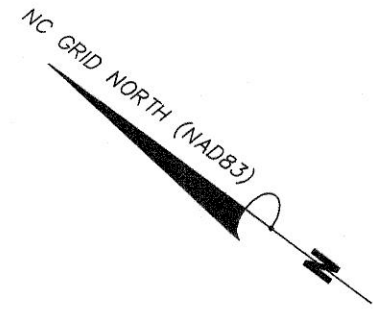
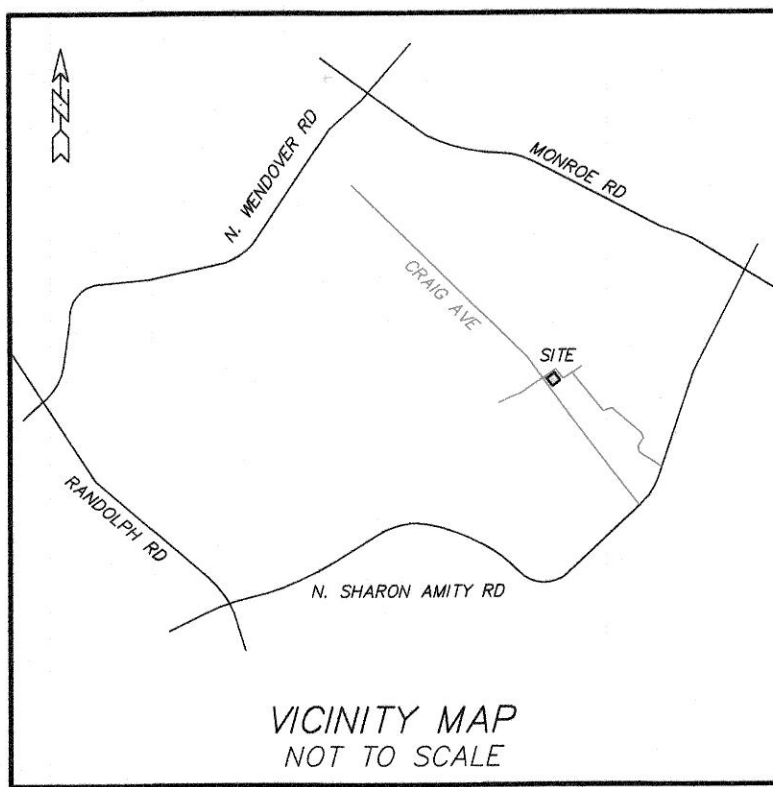


LEGEND:

- EIP = EXISTING IRON PIN
OP = OLD IRON PIPE
SIP = SET IRON PIN
R/W = RIGHT OF WAY
AC = AIR CONDITIONING
PWR = POWER PAD
PM = POWER METER
PP = POWER POLE
LP = LIGHT POLE
GM = GAS METER
TELE = TELEPHONE PEDESTAL
CATV = CABLE TELEVISION
WM = WATER METER
FES = FLARED END SECTION
RCP = REINFORCED CONCRETE PIPE
CMP = CORRUGATED METAL PIPE
CPP = CORRUGATED PLASTIC PIPE
PVC = POLYVINYL CHLORIDE
DU = DESTINATION UNKNOWN
SDE = STORM DRAINAGE EASEMENT
SDMH = STORM DRAIN MANHOLE
CB = CATCH BASIN
YI = YARD INLET
DI = DROP INLET
SSE = SANITARY SEWER EASEMENT
SSMH = SANITARY SEWER MANHOLE
CO = SEWER CLEAN OUT
BC = BACK OF CURB
- SET IRON PIN
EXISTING IRON PIN
CALCULATED POINT
GAS VALVE
WATER VALVE
MAIL BOX
WATER METER
WELL
FIRE HYDRANT
SANITARY SEWER MANHOLE
CORRUGATED METAL PIPE
STORM DRAIN MANHOLE
LOCATED DECIDUOUS TREE
LOCATED EVERGREEN TREE
LIGHT POLE
POWER POLE
BACK FLOW PREVENTOR
GUY WIRE
CATCH BASIN
DROP INLET
- FENCE
STORM DRAIN PIPE
OVERHEAD ELECTRIC
SANITARY SEWER PIPE
UNDERGROUND ELECTRIC
UNDERGROUND GAS
UNDERGROUND TELECOMMUNICATIONS
UNDERGROUND WATER
BOUNDARY LINE
TIE LINE
RIGHT OF WAY
ADJOINING LINE (NOT SURVEYED)


NOTES:

- IRON PINS SET AT ALL CORNERS UNLESS OTHERWISE NOTED.
- PROPERTY ZONED: R-17(MF)
MINIMUM SETBACK 20'
MINIMUM SIDE YARD 5'
MINIMUM REAR YARD 20'
(SETBACKS & ZONING MATTERS ARE SUBJECT TO INTERPRETATION BY LOCAL MUNICIPALITIES)
- TAX PARCEL NUMBERS 15716201, 15716202, 15716203, & 15716204.
- DEED REFERENCE: DB 20010 PG 318, DB 26647 PG 843, DB 26675 PG 14, & DB 30933 PG 305.
- BOUNDARY SURVEY ONLY THROUGH POINTS AS SHOWN.
- THIS PROPERTY IS LOCATED WITHIN AN AREA HAVING A ZONE DESIGNATION X BY THE FEDERAL EMERGENCY MANAGEMENT AGENCY (FEMA), ON FLOOD INSURANCE RATE MAP (FIRM) NO. 370456200K, WITH A DATE OF IDENTIFICATION OF 02/16/2014.
- THIS PROPERTY MAY BE SUBJECT TO ADDITIONAL RECORDED OR UNRECORDED EASEMENTS, RIGHTS-OF-WAY, OR RESTRICTIVE COVENANTS, OTHER THAN SHOWN. SURVEY MADE WITHOUT THE BENEFIT OF A TITLE EXAMINATION.
- AREA COMPUTED BY COORDINATED METHOD.
- NO NCOS MONUMENT FOUND WITHIN 2000'.
- UTILITY LOCATIONS SHOWN ARE LOCATED BASED ON SITE CONDITIONS AND MARKINGS AT THE TIME OF SURVEY. CONTRACTORS ARE TO HAVE ALL UTILITIES ACCURATELY MARKED PRIOR TO CONSTRUCTION.

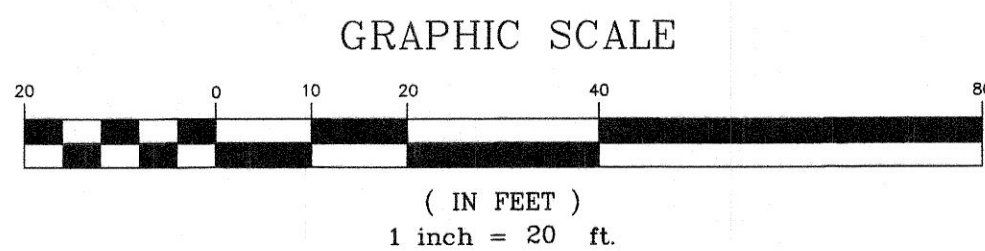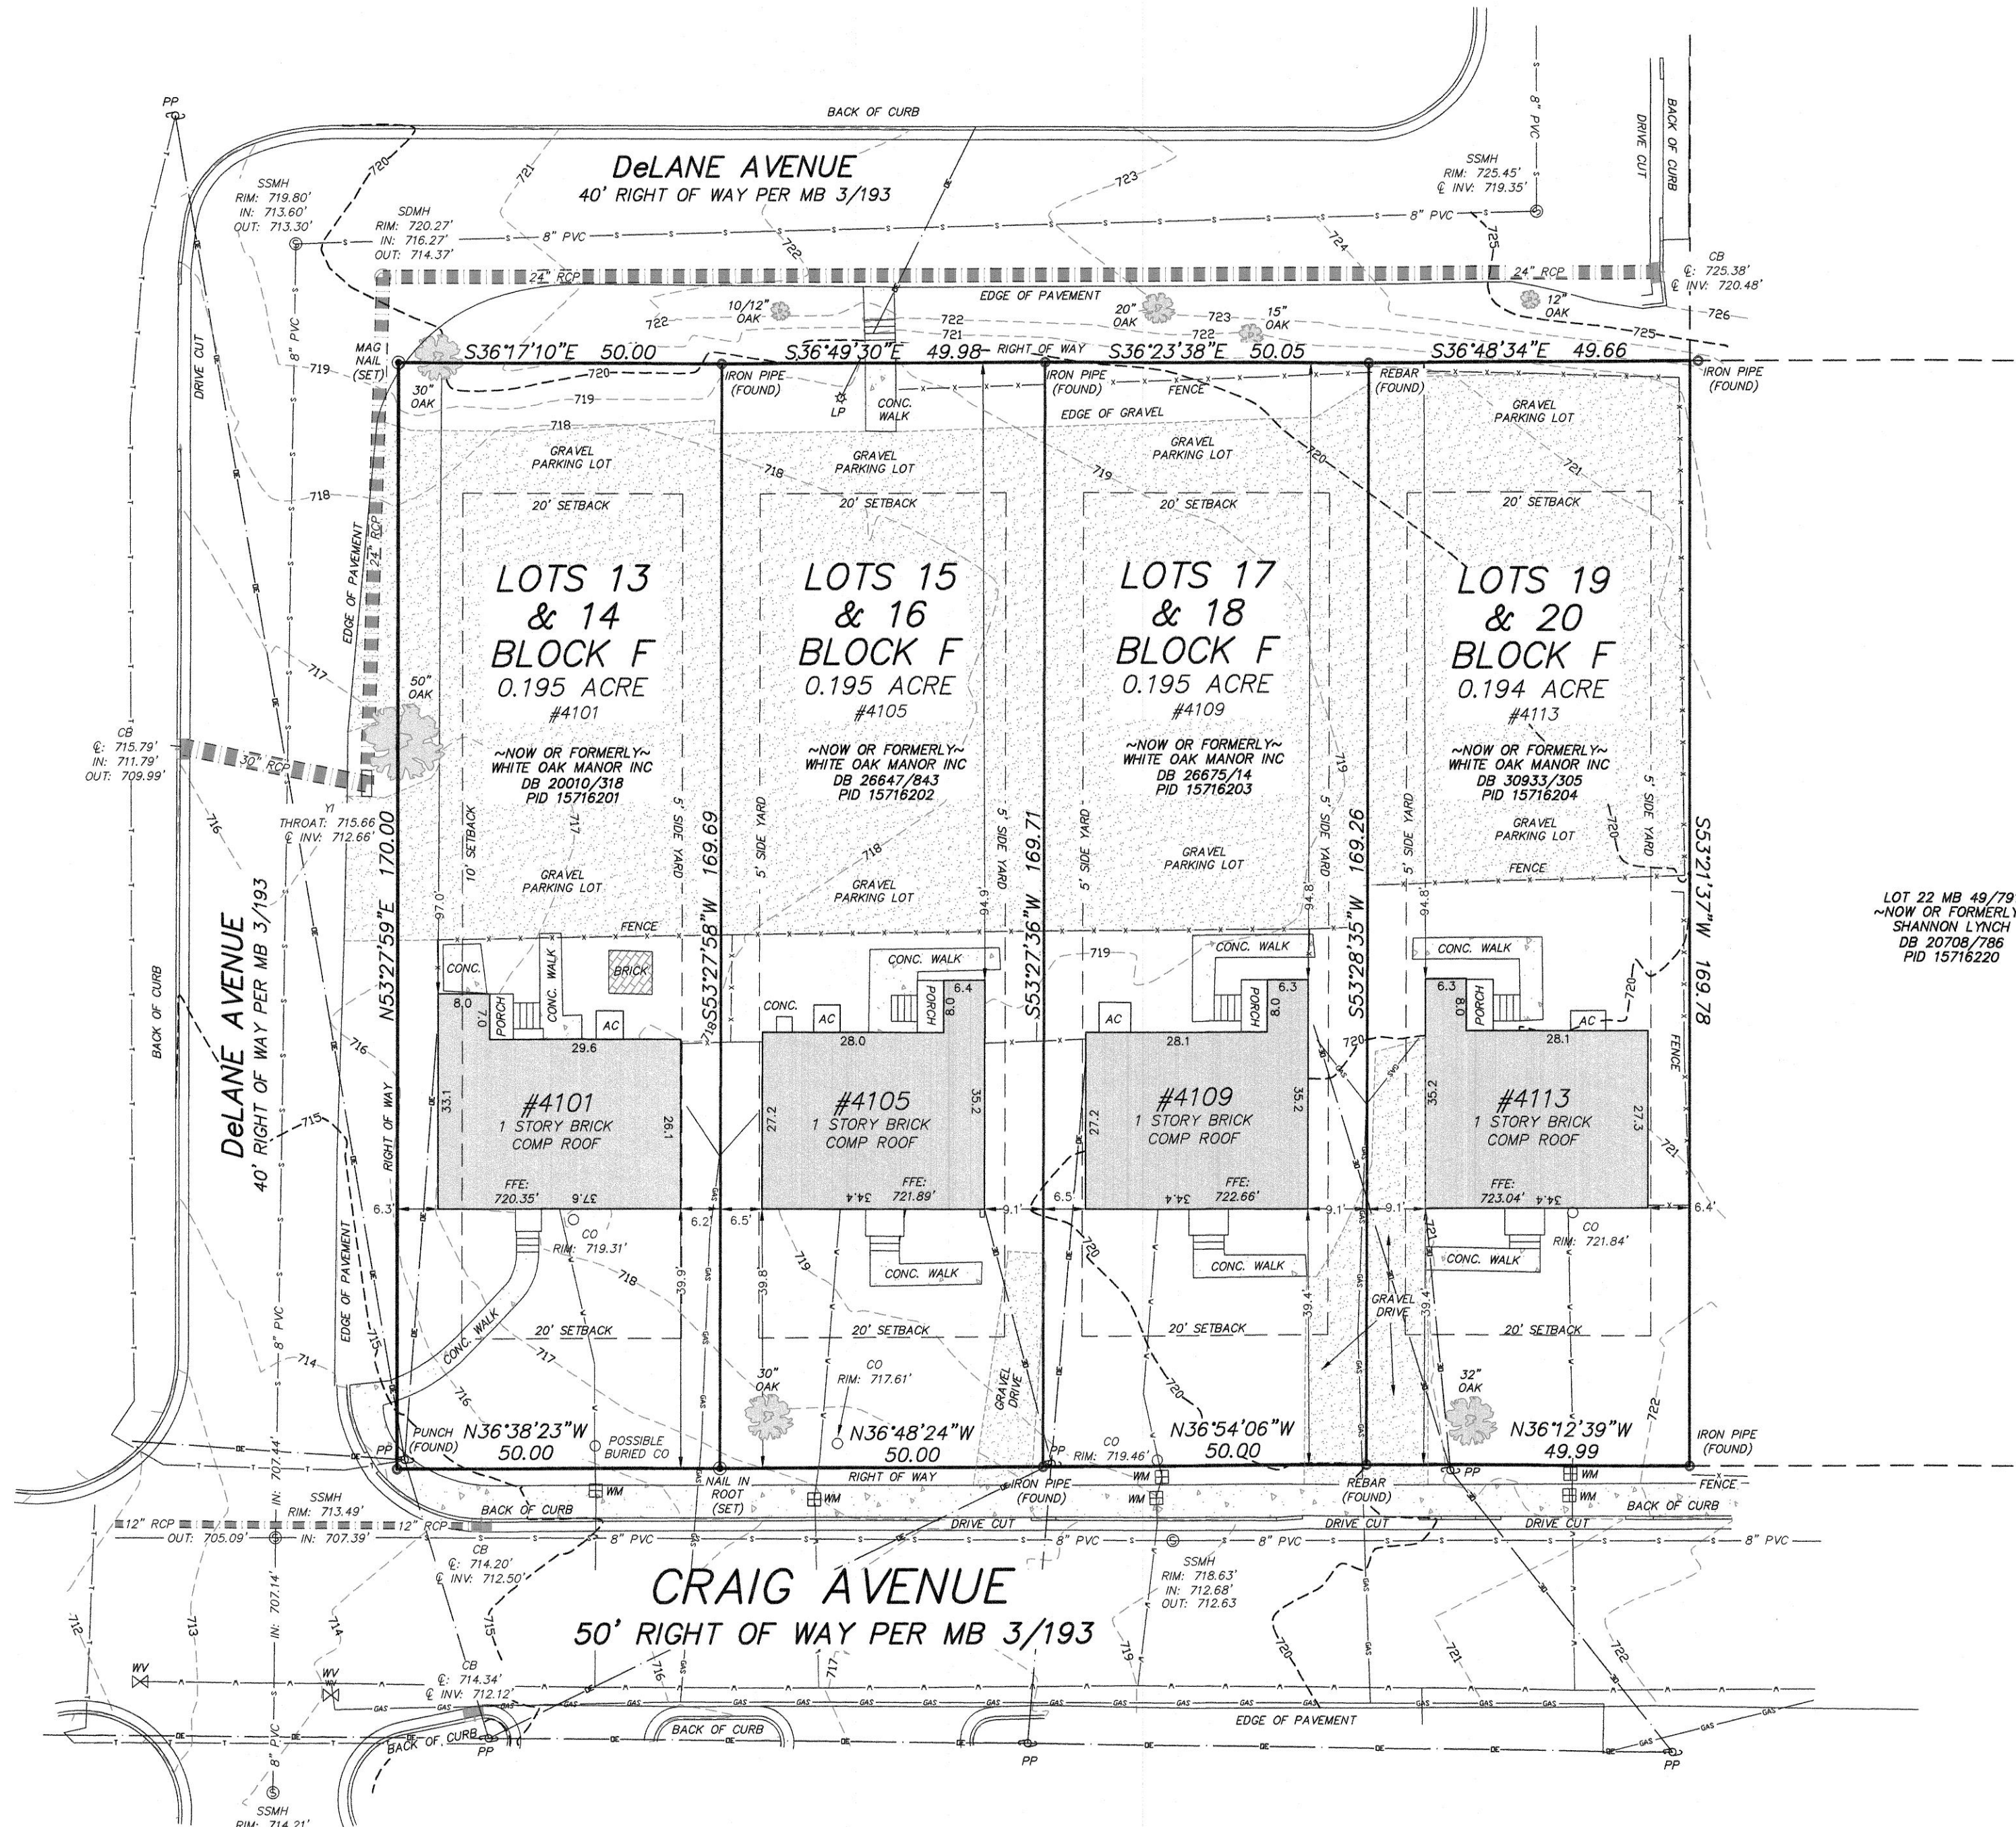

21 NCAC 56.1604- MAP CERTIFICATION

I CERTIFY THAT THIS MAP WAS DRAWN UNDER MY SUPERVISION FROM AN ACTUAL SURVEY MADE UNDER MY SUPERVISION (TITLE REFERENCES AS SHOWN ON PLAT); THAT THE BOUNDARIES NOT SURVEYED ARE INDICATED AS DRAWN FROM TITLE REFERENCES AS SHOWN ON PLAT; THAT THE RATIO OF PRECISION OR POSITIONAL ACCURACY MEETS OR EXCEEDS 1:10,000; AND THAT THIS MAP MEETS THE REQUIREMENTS OF THE STANDARDS OF PRACTICE FOR LAND SURVEYING IN NORTH CAROLINA (21 NCAC 56.1600).
THIS 21 DAY OF MAY 2018
THOMAS E. WHITE
PROFESSIONAL LAND SURVEYOR

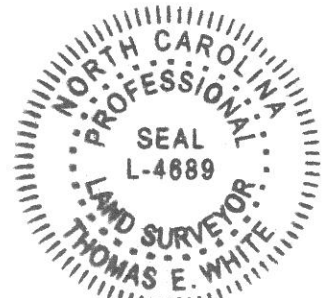

CAROLINA SURVEYORS, INC.
P.O. BOX 267, PINEVILLE, N.C. 28134 - 0267
THOMAS E. WHITE, NCPLS & SCPLS 704-889-7601
CERTIFICATE OF AUTHORIZATION NC-0-1242 8C886

AN AS-BUILT TOPOGRAPHICAL SURVEY SHOWING
LOTS 13-20, BLOCK F of WALKER HILLS
(NEAR THE INTERSECTION OF CRAIG AVENUE & DELANE AVENUE)
SURVEYED FOR: White Oak Management
TOTAL AREA: 0.779 ACRE
CITY OF CHARLOTTE, MECKLENBURG COUNTY, NORTH CAROLINA

UNDERGROUND UTILITIES MARKED BY:
ROL PRIVATE UTILITY LOCATING
6012 BAYFIELD PARKWAY
CONCORD, NC 28027
(704) 492-4841
ROLLOCATING@GMAIL.COM