


APPROVED FOR  
CONSTRUCTION  
CHARLOTTE-MECKLENBURG PLANNING DEPARTMENT  
By: Joshua Weaver 12-21-2012

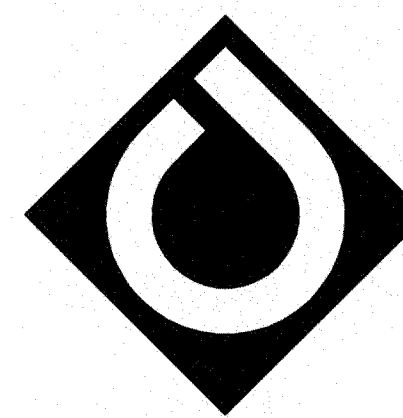

**ColeJenest  
& Stone**

Shaping the Environment  
Realizing the Possibilities

Land Planning  
+  
Landscape Architecture  
+  
Civil Engineering  
+  
Urban Design

200 South Tryon Street, Suite 1400 Charlotte, NC 28202  
p: 704.376.1555 f: 704.376.7851 w: www.colejeneststone.com

**LEVINE  
PROPERTIES**  
P.O. Box 2439  
Matthews  
North Carolina 28284

**THE McALPINES  
"REVISION TO  
APPROVED PLANS"**

Charlotte  
North Carolina 28284



**STAKING AND  
MATERIALS PLAN**

Project No.  
3080

Issued  
04/19/07

Revised

06/26/07 - PER CITY REVIEW COMMENTS  
08/29/07 - PER CITY REVIEW COMMENTS  
11/13/07 - PER CDOT REVIEW COMMENTS  
04/09/12 - STORM DRAINAGE REVISIONS  
11/27/12 - PER CITY REVIEW COMMENTS

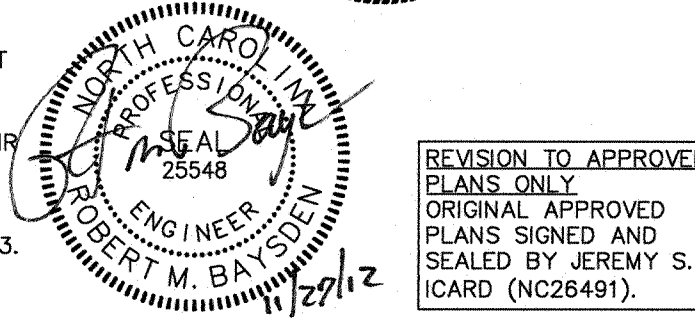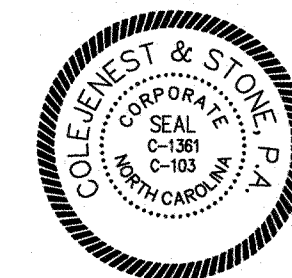


REVISION TO APPROVED  
PLANS ONLY  
ORIGINAL APPROVED  
PLANS SIGNED AND  
SEALED BY JEREMY S.  
ICARD (NC26491)

SCALE: 1"=60'  
0 30 60 120

**CV3.0**

The drawings, the project manual and the design shown  
thereon are instruments of ColeJenest & Stone, P.A. The  
reproduction or unauthorized use of the documents without  
consent of ColeJenest & Stone, P.A. is prohibited.

ColeJenest & Stone, P.A. 2006 ©

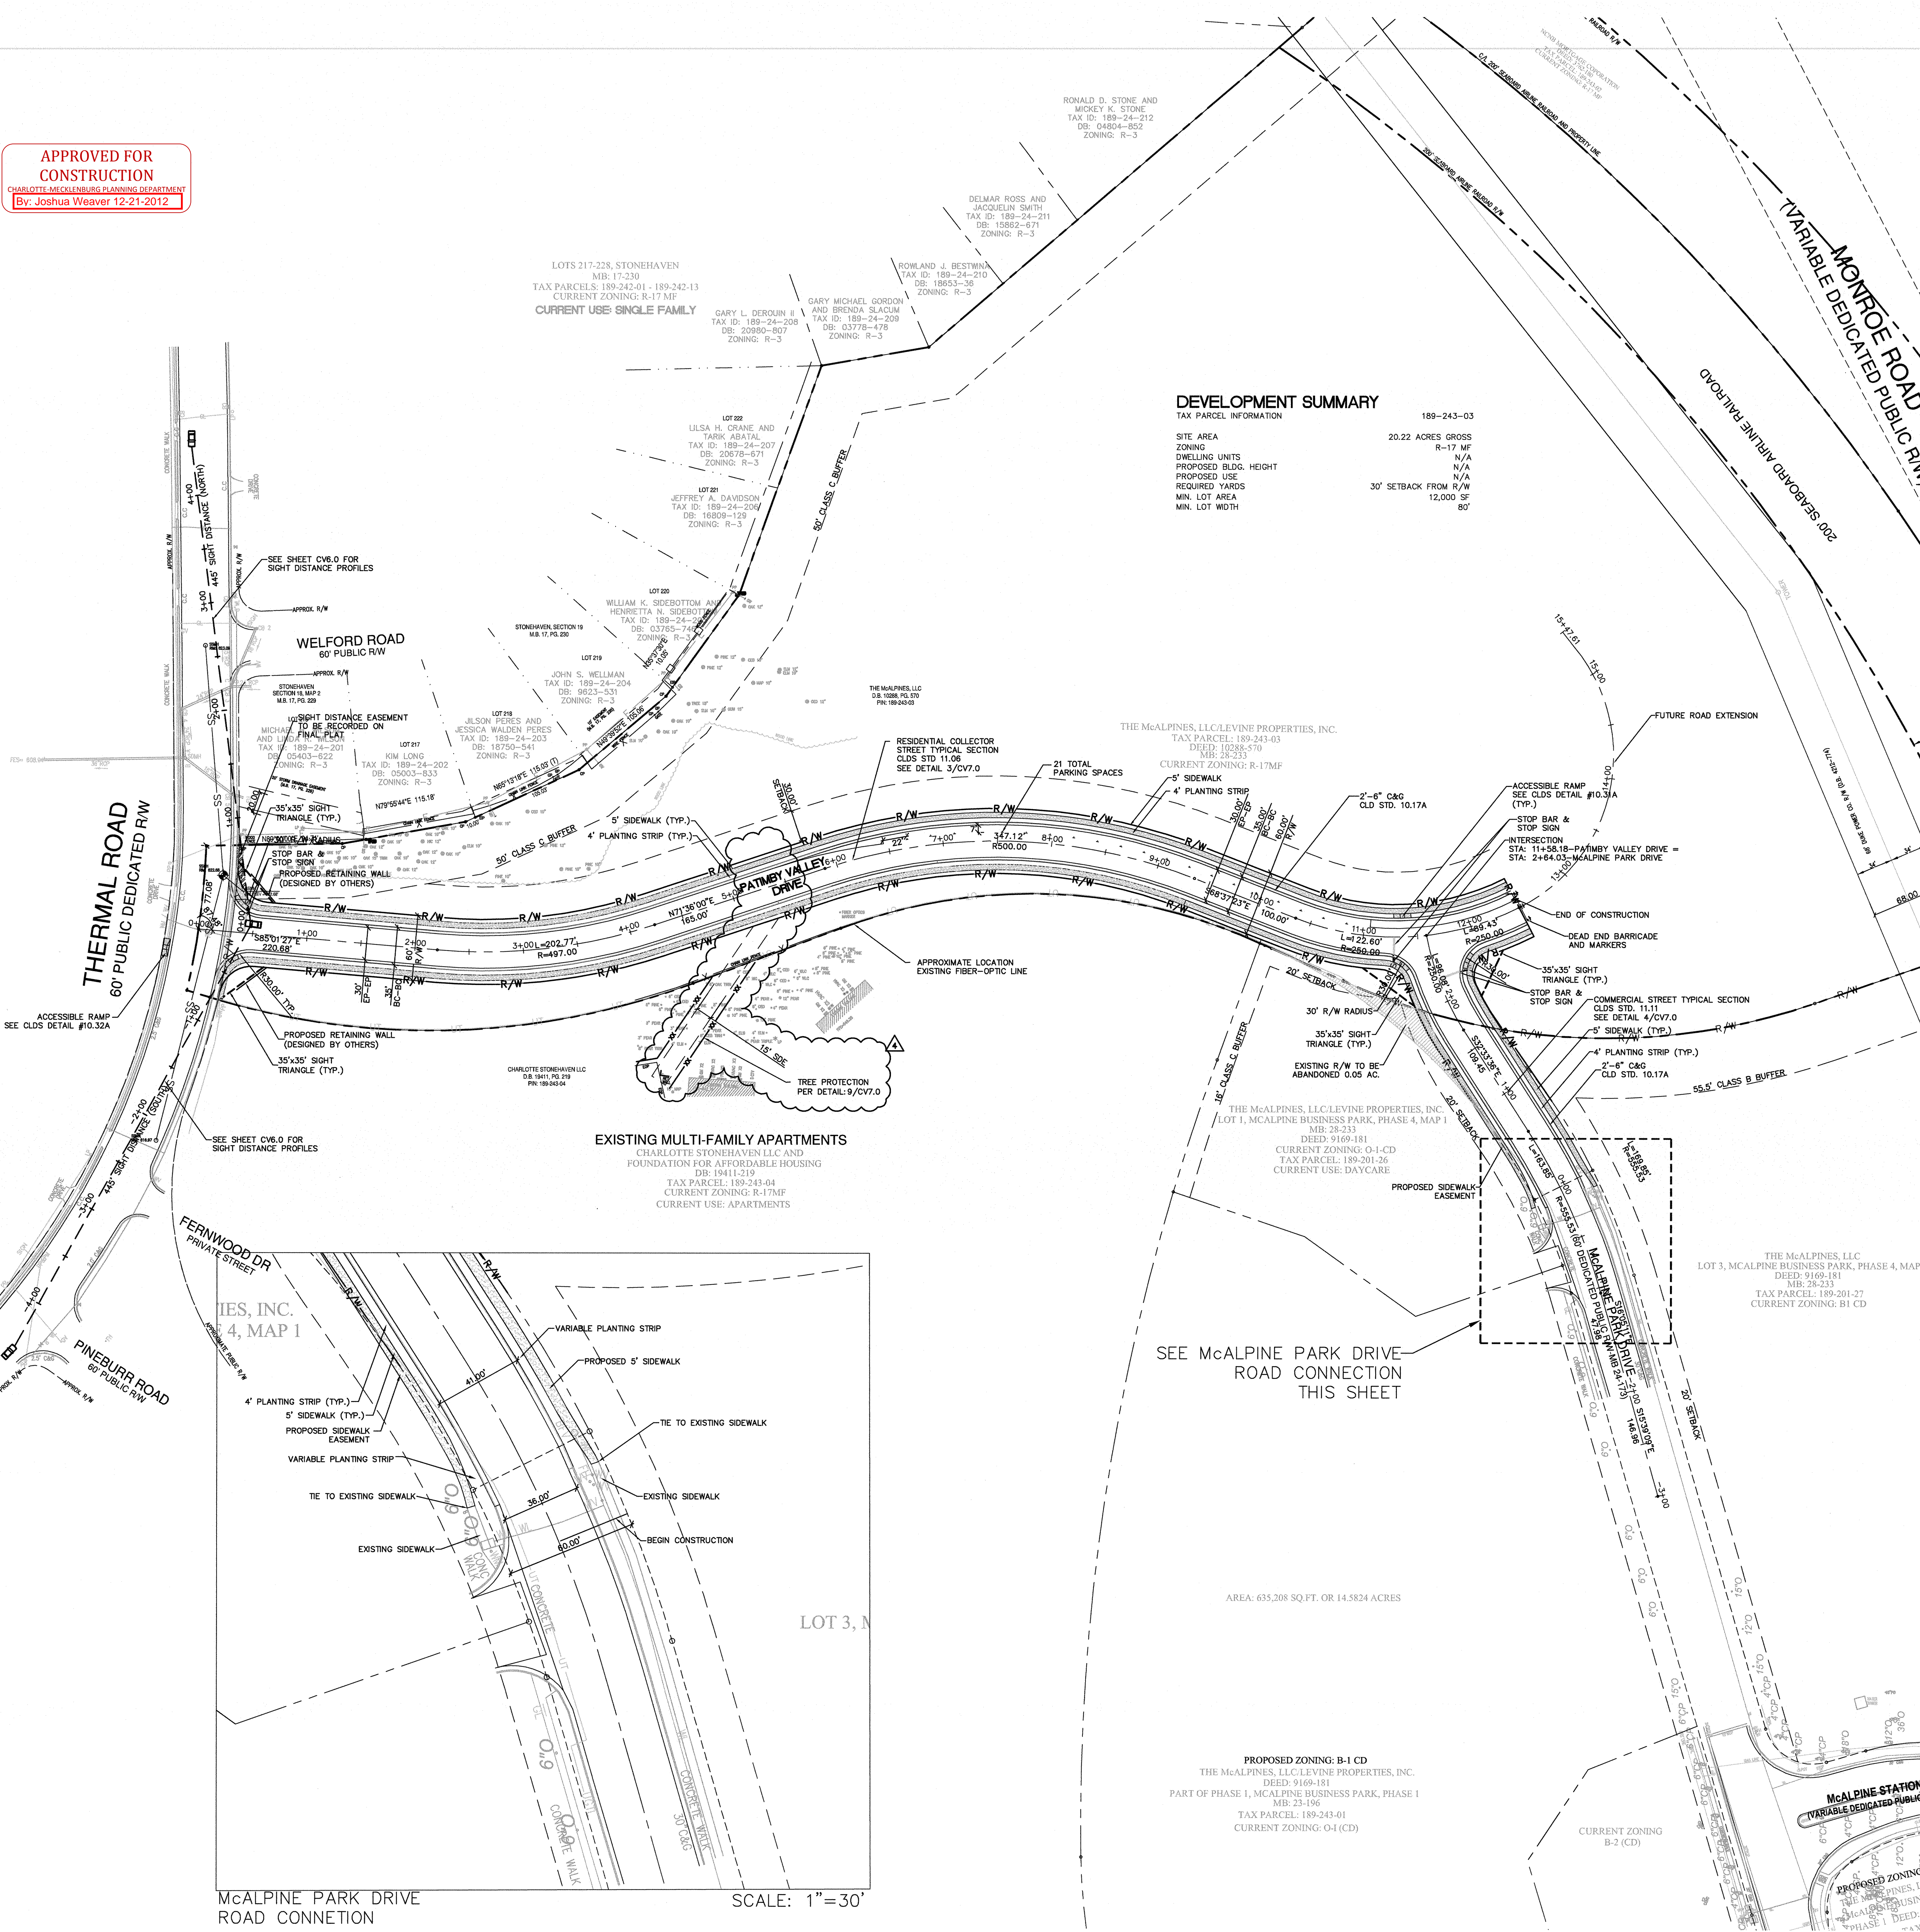

McALPINE PARK DRIVE  
ROAD CONNETION

SCALE: 1"=30'