

GENERAL NOTES:

1. ALL WORK AND MATERIALS SHALL CONFORM TO THE LATEST EDITION OF THE CHARLOTTE LAND DEVELOPMENT STANDARDS MANUAL (CLDSM).
2. ALL WORK AND MATERIALS SHALL CONFORM TO THE LATEST EDITION OF THE NORTH CAROLINA DEPARTMENT OF TRANSPORTATION (NCDOT) STANDARD SPECIFICATIONS FOR ROADS AND STRUCTURES UNLESS OTHERWISE SPECIFIED IN THE CHARLOTTE LAND DEVELOPMENT STANDARDS MANUAL.
3. LAND DEVELOPMENT ENGINEER SHALL BE GIVEN 48 HOURS NOTICE PRIOR TO CONSTRUCTION.
4. SIGHT TRIANGLES SHOWN ARE THE MINIMUM REQUIRED. FURTHER REQUIREMENTS MAY BE MADE BY THE CITY OF CHARLOTTE DEPARTMENT OF TRANSPORTATION (CDOT).
5. NON-STANDARD ITEMS (I.E.: PAVERS, IRRIGATION SYSTEMS, ETC.) IN THE RIGHT-OF-WAY REQUIRE A RIGHT-OF-WAY ENCROACHMENT AGREEMENT WITH THE CHARLOTTE DEPARTMENT OF TRANSPORTATION/NORTH CAROLINA DEPARTMENT OF TRANSPORTATION BEFORE INSTALLATION. FOR CITY OF CHARLOTTE MAINTAINED STREETS, CONTACT CDOT AT (704) 336-3888
6. ALL CONCRETE SHALL HAVE A MINIMUM COMPRESSIVE STRENGTH OF 3600 P.S.I. AT 28 DAYS AND SHALL COMPLY WITH SECTION 1000 OF THE NCDOT STANDARD SPECIFICATIONS.
7. ALL CONCRETE SHALL BE CURED WITH 100% RESIN BASE, WHITE PIGMENTED CURING COMPOUND WHICH MEETS A.S.T.M. SPECIFICATIONS C-309, TYPE 1, APPLIED AT ONE GALLON TO 400 SF WITHIN 24 HOURS OF PLACEMENT OF CONCRETE.
8. ALL CURB AND GUTTER SHALL BE BACKFILLED WITH SOIL APPROVED BY THE INSPECTOR 48 HOURS AFTER CONSTRUCTION TO PREVENT EROSION.
9. ALL BACKFILL SHALL BE NON-PLASTIC IN NATURE, FREE FROM ROOTS, VEGETATIVE MATTER, WASTE, CONSTRUCTION MATERIAL, OR OTHER OBJECTIONABLE MATERIAL. SIAD MATERIAL SHALL BE CAPABLE OF BEING COMPACTED BY MECHANICAL MEANS AND THE MATERIAL SHALL HAVE NO TENDENCY TO FLOW OR BEHAVE IN A PLASTIC MANNER UNDER THE TAMPING BLOWS OR PROOF ROLLING.
10. ALL SUBGRADE FOR ROADS SHALL BE COMPACTED TO 100% OF THE MAXIMUM DENSITY OBTAINABLE WITH THE STANDARD PROCTER TEST.
11. ALL TESTS SHALL BE PERFORMED BY THE DEVELOPER AT NO COST TO THE CITY.
12. CONTRACTOR SHALL MAINTAIN TWO WAY TRAFFIC AT ALL TIMES WHEN WORKING WITHIN EXISTING STREETS. THE CONTRACTOR SHALL PLACE AND MAINTAIN SIGNS, DANGER LIGHTS, BARRICADES, AND FURNISH WATCHMEN OR FLAGMEN TO DIRECT TRAFFIC IN ACCORDANCE WITH THE WORK AREA TRAFFIC CONTROL HANDBOOK (W.A.T.C.H.).
13. SIDEWALKS SHALL BE CONSTRUCTED OF NOT LESS THAN 3600 PSI CONCRETE AND SHALL BE FOUR (4) INCHES THICK, CONSTRUCTED ON AN ADEQUATELY GRADED BASE, EXCEPT WHERE A SIDEWALK CROSSES A DRIVEWAY IT SHALL BE SIX (6) INCHES THICK.
14. SUBGRADE FOR SIDEWALKS SHALL BE COMPACTED TO 95% OF THE MAXIMUM DENSITY OBTAINABLE WITH THE STANDARD PROCTER TEST. THE SURFACE OF THE SIDEWALK SHALL BE STEEL TROWEL AND LIGHT BROOM FINISHED AND CURED WITH AN ACCEPTABLE CURING COMPOUND. TOOLED JOINTS SHALL BE PROVIDED AT AN INTERVAL NOT LESS THAN FIVE (5) FEET AND EXPANSION JOINTS AT INTERVALS NOT MORE THAN 45 FEET. THE SIDEWALK SHALL HAVE A LATERAL SLOPE OF 1/4" PER FOOT.
15. THE ELEVATION OF THE SIDEWALK SHALL BE RELATED TO THE ELEVATION OF THE CROWN OF THE ADJACENT ROADWAY. THE SIDEWALK SHALL BE NO LESS THAN SIX (6) INCHES OR MORE THAN 18 INCHES ABOVE THE ROADWAY CROWN, EXCEPT THAT THE CROSSWALK ELEVATIONS SHALL BE PROPERLY RELATED TO THE EXISTING OR PROPOSED ROADWAY CURB.
16. IN ROLLY AND HILLY TERRAINS, SWEEPING OF THE STONE BASE AND/OR APPLICATION OF A TACK COAT MAY BE REQUIRED NEAR INTERSECTIONS. THESE REQUIREMENTS WILL BE ESTABLISHED BY THE INSPECTOR BASED ON FIELD CONDITIONS.
17. UTILITY INSTALLATIONS MAY ONLY CROSS BUFFER AREAS AT INTERIOR ANGLES MEASURED AT PROPERTY LINES WHICH ARE NOT LESS THAN 75 DEGREES AND, TO THE EXTENT POSSIBLE, PATHS CLEARED FOR SUCH UTILITY LINES SHALL BE REPLANTED WITH PLANT MATERIALS FROM THE ORDINANCES APPROVED PLANT LIST.
18. NO BUILDINGS, PARKING SPACES OR MANEUVERING AREAS MAY BE LOCATED WITHIN ANY BUFFER AREAS.
19. THE DEVELOPER SHALL MAKE A DILIGENT EFFORT TO PRESERVE AREAS OF REQUIRED BUFFERS WHERE SIGNIFICANT VEGETATION EXISTS. THESE AREAS SHALL REMAIN UNDISTURBED EXCEPT TO THE EXTENT NECESSARY TO ACCOMMODATE THE ABOVE ITEMS OF THIS SECTION.
20. UNDER DRAINAGE SHALL BE PROVIDED AS DIRECTED BY GEO-TECHNICAL ENGINEER. DETERMINATION SHALL BE MADE IN THE FIELD. DRAINS TO BE INSTALLED PER CLDSM STD #30.05.
21. SUBSURFACE DRAINAGE FACILITIES MAY BE REQUIRED IN THE STREET RIGHT-OF-WAY IF DEEMED NECESSARY BY THE INSPECTOR.
22. "AS-BUILT" DRAWINGS AND PLANS OF THE STORM DRAINAGE SYSTEM, INCLUDING DESIGNED DITCHES, MUST BE SUBMITTED PRIOR TO SUBDIVISION FINAL INSPECTION TO THE CITY ENGINEERING DEPARTMENT IN ACCORDANCE WITH THE CITY SUBDIVISION ORDINANCE.
23. THE PURPOSE OF THE STORM DRAINAGE EASEMENT (SDE) IS TO PROVIDE STORM WATER CONVEYANCE. BUILDINGS ARE NOT PERMITTED IN THE EASEMENT AREA. ANY OTHER OBJECTS WHICH IMPEDE STORM WATER FLOW OR SYSTEM MAINTENANCE ARE ALSO PROHIBITED.
24. ALL ROAD IMPROVEMENTS ON FORT STREET, COUNTRY CLUB LANE, & MATHESON AVENUE ARE TO BE COORDINATED WITH THE CITY OF CHARLOTTE ENGINEERING DEPARTMENT PRIOR TO CONSTRUCTION.
25. CONTACT THE UTILITY COMPANY TO RELOCATE ANY EXISTING UTILITY POLES. ALL EXISTING FACILITIES WHICH CONFLICT WITH THE IMPROVEMENTS UNDER THE SCOPE OF THIS PROJECT MUST BE RELOCATED AT THE EXPENSE OF THE APPLICANT.
26. ALL DEVELOPMENT CREATING A TOTAL 20,000 SQUARE FEET OF IMPERVIOUS AREA SINCE SEPTEMBER 1978 WILL REQUIRE STORM DRAINAGE DETENTION.
27. TREES WITHIN THE STREET RIGHT-OF-WAY ARE PROTECTED BY LAW. PERMIT REQUIRED FOR REMOVAL BY CITY OF CHARLOTTE LANDSCAPE MANAGEMENT AT 704-336-4262. ALL TREES OVER 8-INCHES IN DIAMETER (4.5-FT ABOVE GROUND) IN SETBACK AREA ARE PROTECTED BY LAW. PERMIT REQUIRED FOR REMOVAL BY CITY ENGINEERING AT 704-336-6692.
28. PE SEALED SHOP DRAWINGS FOR RETAINING WALL MUST BE SUBMITTED TO CITY ENGINEER PRIOR TO CONSTRUCTION.
29. THE DEVELOPER SHALL CONTACT THE CHARLOTTE DEPARTMENT OF TRANSPORTATION (GUS JORDI, 704-336-7086) TO IDENTIFY ANY CONFLICTS WITH TRAFFIC SIGNALIZATION EQUIPMENT. 60-90 DAYS WILL BE REQUIRED TO COORDINATE RELOCATION. DEVELOPER SHALL BE RESPONSIBLE FOR ALL RELATED RELOCATION COST AND/OR ANY REPAIR COST CAUSED BY THE CONTRACTOR/DEVELOPER.
30. CERTIFICATION AND STREET CUT PERMITS ARE REQUIRED FOR UTILITY CUTS ON CITY STREETS. ALLOW 7 DAYS PROCESSING FOR PERMIT. FOR INFORMATION CONTACT CHARLOTTE DEPARTMENT OF TRANSPORTATION (704-336-4025) OR VISIT [HTTP://WWW.CHARMECK.ORG/DEPARTMENTS/TRANSPORTATION/STREET+MAINTENANCE/HOME.HTM](http://www.charmeck.org/departments/transportation/street+maintenance/home.htm)
31. PER SECTION 18-175(E) OF CITY CODE AND SECTION 10.0 OF THE CITY'S POST CONSTRUCTION CONTROLS ADMINISTRATIVE MANUAL, ALL REQUIRED NATURAL AREAS AND/OR POST CONSTRUCTION CONTROLS EASEMENTS (PCEES) MUST BE RECORDED PRIOR TO THE ISSUANCE OF THE CERTIFICATE OF OCCUPANCY.

32. DIRECT VEHICULAR ACCESS IS PROHIBITED TO FORT STREET FROM LOTS 8-9, 21-22, 24-26. DIRECT VEHICULAR ACCESS IS PROHIBITED TO COUNTRY CLUB LANE FROM LOTS 1, 14-15, 36.
33. ANY WORK WITHIN THE CITY'S R/W THAT REQUIRES CLOSURE OF THE SIDEWALK OR TRAVEL LANE FOR LESS THAN 30 DAYS REQUIRES A R/W USE PERMIT. TRAFFIC CONTROL PLANS FOR ANY SIDEWALK OR TRAVEL LANE CLOSURES MUST BE SUBMITTED AS PART OF THE R/W USE PERMIT REQUEST. TRAFFIC CONTROL PLANS MUST BE IN ACCORDANCE WITH CDOT'S WORK AREA TRAFFIC CONTROL HANDBOOK (WATCH) AND MUST BE REVIEWED AND APPROVED. CONTRACTOR SHALL CONTACT CDOT AT LEAST 5 BUSINESS DAYS IN ADVANCE OF BEGINNING OF WORK AT (704) 432-1562.
34. CONSTRUCTION STAGING WITHIN CITY R/W LASTING MORE THAN 30 DAYS REQUIRES A R/W LEASE AGREEMENT. CONTRACTOR SHALL CONTACT CDOT AT (704) 336-8348.
35. RIGHT-OF-WAY CLOSURES LONGER THAN 30 DAYS REQUIRE A R/W LEASE AGREEMENT WHICH WILL INCLUDE THE SUBMITTAL OF A TRAFFIC CONTROL PLAN. TRAFFIC CONTROL PLANS REQUIRED THROUGH A LEASE AGREEMENT MAY BE DIFFERENT FROM THE ONE REQUIRED DURING THE LAND DEVELOPMENT PLAN REVIEW AND ARE SUBJECT TO REVISIONS. THE REVISED TRAFFIC CONTROL PLANS MUST BE SUBMITTED AS PART OF THE LEASE AGREEMENT PROCESS FOR APPROVAL PRIOR TO START OF R/W CLOSURES. CONTRACTOR SHALL CONTACT CDOT AT (704) 336-2562.
36. COORDINATE ALL CURB AND STREET GRADES IN INTERSECTION WITH INSPECTOR.
37. ALL ROAD IMPROVEMENTS AT FORT STREET ARE TO BE COORDINATED WITH THE CITY OF CHARLOTTE ENGINEERING DEPARTMENT PRIOR TO CONSTRUCTION.
38. THE PURPOSE OF THE STORM DRAINAGE EASEMENT (SDE) IS TO PROVIDE STORM WATER CONVEYANCE. BUILDINGS ARE NOT PERMITTED IN THE EASEMENT AREA. ANY OTHER OBJECTS WHICH IMPEDE STORM WATER FLOW OR SYSTEM MAINTENANCE ARE ALSO PROHIBITED.
39. HIGH-DENSITY POLYETHYLENE (HDPE) STORM DRAINAGE PIPE INSTALLED WITHIN EXISTING OR PROPOSED PUBLIC STREET RIGHT-OF-WAY MUST BE APPROVED BY THE CITY'S INSPECTOR PRIOR TO ANY BACKFILL BEING PLACED. BACKFILL MATERIAL MUST BE APPROVED BY THE CITY INSPECTOR PRIOR TO PLACEMENT OF THE MATERIAL WITHIN THE PUBLIC STREET RIGHT-OF-WAY.
40. NO DEMOLITION LANDFILL WILL BE ALLOWED ON SITE. ESTIMATED START DATE IS JUNE 2016. ESTIMATED FINISH DATE IS MARCH 2018.

CONTACT INFORMATION

OWNER:
COUNTRY CLUB LANE, LLC
CONTACT: FRED CALIGIURI
ADDRESS: 1600 CAMDEN ROAD
CHARLOTTE, NC 28203
PHONE: (704) 541-9151

CIVIL ENGINEER & LANDSCAPE ARCHITECT:
URBAN DESIGN PARTNERS
CONTACT: BRIAN D. SMITH, PE
ADDRESS: 1318-E6 CENTRAL AVENUE
CHARLOTTE, NC 28205
PHONE: 704-334-3303 FAX: 704-334-3305

SHEET INDEX

- | | |
|--------|---|
| C-1.0 | COVER SHEET |
| C-2.0 | EXISTING CONDITIONS |
| C-3.0 | SITE PLAN |
| C-3.1 | COMMON OPEN SPACE AND TREE SAVE PLAN |
| C-4.0 | GRADING & STORM DRAINAGE PLAN |
| C-4.1 | DETAIL GRADING - CUL-DE-SACS |
| C-4.2 | ROAD PROFILE - CRAMER POND DRIVE |
| C-4.3 | ROAD PROFILE - MAYMONT PLACE |
| C-4.4 | ROAD PROFILE - FORT STREET |
| C-4.5 | ROAD PROFILE - TINKHAM COURT |
| C-4.6 | POND 1 PLAN & DETAILS |
| C-4.7 | POND 2 PLAN & DETAILS |
| C-4.8 | BMP DETAILS |
| C-4.9 | DRAINAGE AREA MAP - STORM DRAINAGE |
| C-5.0 | UTILITY PLAN |
| C-6.0 | SITE DETAILS & SPECIFICATIONS |
| C-6.1 | SITE DETAILS & SPECIFICATIONS |
| C-6.2 | SITE DETAILS & SPECIFICATIONS |
| C-7.0 | EROSION CONTROL PLAN - PHASE I & DEMOLITION PLAN |
| C-7.1 | EROSION CONTROL PLAN - PHASE II |
| C-7.2 | EROSION CONTROL DETAILS |
| C-7.3 | EROSION CONTROL DETAILS |
| C-7.4 | EROSION CONTROL DETAILS |
| C-8.0 | INTERSECTION SIGHT DISTANCE - CRAMER POND DRIVE-COUNTRY CLUB LANE |
| C-8.1 | INTERSECTION SIGHT DISTANCE - MAYMONT PLACE-COUNTRY CLUB LANE |
| C-8.2 | INTERSECTION SIGHT DISTANCE - CRAMER POND DRIVE-FORT STREET |
| C-8.3 | INTERSECTION SIGHT DISTANCE - MAYMONT PLACE-FORT STREET |
| ===== | |
| LS-1.0 | LANDSCAPE PLAN |
| LS-1.1 | LANDSCAPE ENLARGEMENT |
| LS-2.0 | LANDSCAPE DETAILS & NOTES |



SDRSFR-2017-00001

**FINAL
APPROVAL**

ENGINEERING

PCO / DETENTION / DRAINAGE PLAN

EROSION CONTROL

URBAN FORESTRY

TREE ORDINANCE

CDOT

NOTE: SCHEDULE PRE-CONSTRUCTION MEETING AT LEAST 48 HRS. PRIOR TO ANY LAND DISTURBING ACTIVITY USING THE ONLINE FORM AT <http://development.charmeck.org>

APPROVED

By Emily Chien at 12:53 pm, Aug 30, 2017


APPROVED

APPROVED

Craig Robinson

APPROVED

Kory Hedrick

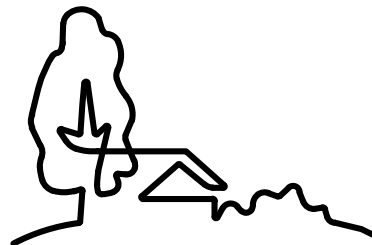

**URBAN
DESIGN
PARTNERS**

1318-e6 central ave. p 704.334.3303
charlotte, nc 28205 f 704.334.3305
urbandesignpartners.com



08.25.17

Country Club
Lane, LLC

1600 Camden Road
Charlotte, NC 28203
704-541-9151

Cramer's Pond

Cover Sheet
Charlotte, North Carolina

NO.	DATE:	BY:	REVISIONS:
1	03.16.16	UDP	PER CITY COMMENTS
2	05.04.16	UDP	PER CITY COMMENTS
3	06.07.16	UDP	PER CITY COMMENTS
4	12.21.16	UDP	SITE MODIFY & POND RESTORATION
5	02.02.17	UDP	PER FORT ST CONNECTION
6	06.09.17	UDP	PER SITE MODIFICATION
7	08.01.17	UDP	PER CITY COMMENTS
8	08.18.17	UDP	PER WETLAND DISTURBANCE
9	08.25.17	UDP	PER CITY COMMENTS

Project No: 15-038
Date: December 21, 2015
Designed by: udp
Drawn by: udp
Scale: 1"=100'
Sheet No:


C-1.0

NOTES:

- BOUNDARY AND TOPOGRAPHIC INFORMATION PROVIDED BY:
RB PHARR & ASSOCIATES
420 HAWTHORNE LANE
CHARLOTTE, NC 28204
(704) 376-2186
- THIS DEVELOPMENT IS BEING EXECUTED UNDER THE CLUSTER DEVELOPMENT PROVISIONS OF SECTION 9.205(5) OF THE ZONING ORDINANCE. THIS ALLOWS FOR REDUCTION OF LOT SIZE AND LOT WIDTH REQUIREMENTS AS SET OUT IN SUBSECTION 9.205(1). LOTS MUST MEET THE MINIMUM LOT AREA AND LOT WIDTH REQUIREMENTS AS SET FORTH IN TABLE 9.205(5).
- CONTACT THE UTILITY COMPANY TO RELOCATE ANY EXISTING UTILITY POLES. ALL EXISTING FACILITIES WHICH CONFLICT WITH THE IMPROVEMENTS UNDER THE SCOPE OF THIS PROJECT MUST BE RELOCATED AT THE EXPENSE OF THE APPLICANT.
- TREES WITHIN THE STREET RIGHT-OF-WAY ARE PROTECTED BY LAW. PERMIT REQUIRED FOR REMOVAL BY CITY OF CHARLOTTE LANDSCAPE MANAGEMENT AT 704-336-4262. ALL TREES OVER 8-INCHES IN DIAMETER (4.5-FT ABOVE GROUND) IN SETBACK AREA ARE PROTECTED BY LAW. PERMIT REQUIRED FOR REMOVAL BY CITY ENGINEERING AT 704-336-6692.
- DIMENSIONS SHOWN ARE TO THE FACE OF CURB UNLESS OTHERWISE NOTED.
- DIRECT VEHICULAR ACCESS IS PROHIBITED TO FORT STREET FROM LOTS 8-9, 21-22, 24-28. DIRECT VEHICULAR ACCESS IS PROHIBITED TO COUNTRY CLUB LANE FROM LOTS 1, 14-15, 37.
- 50' REAR YARD CONSIST OF 20' REAR SETBACK AND 30' LANDSCAPE EASEMENT PER ZONING SECTION 12.308.2C.

Lot	Max B.U.A.
1	4089 sf
2	4226 sf
3	4211 sf
4	4181 sf
5	3749 sf
6	3764 sf
7	3805 sf
8	3771 sf
9	3568 sf
10	3638 sf
11	3935 sf
12	4750 sf
13	3324 sf
14	3048 sf
15	3031 sf
16	3320 sf
17	4000 sf extra
18	4092 sf
19	3993 sf


20	3750 sf
21	3750 sf
22	3850 sf
23	3417 sf
24	3501 sf
25	3508 sf
26	4312 sf
27	4201 sf
28	4995 sf
29	5552 sf
30	6182 sf
31	3199 sf
32	3556 sf
33	4475 sf
34	2985 sf
35	3700 sf
36	4275 sf
37	2963 sf

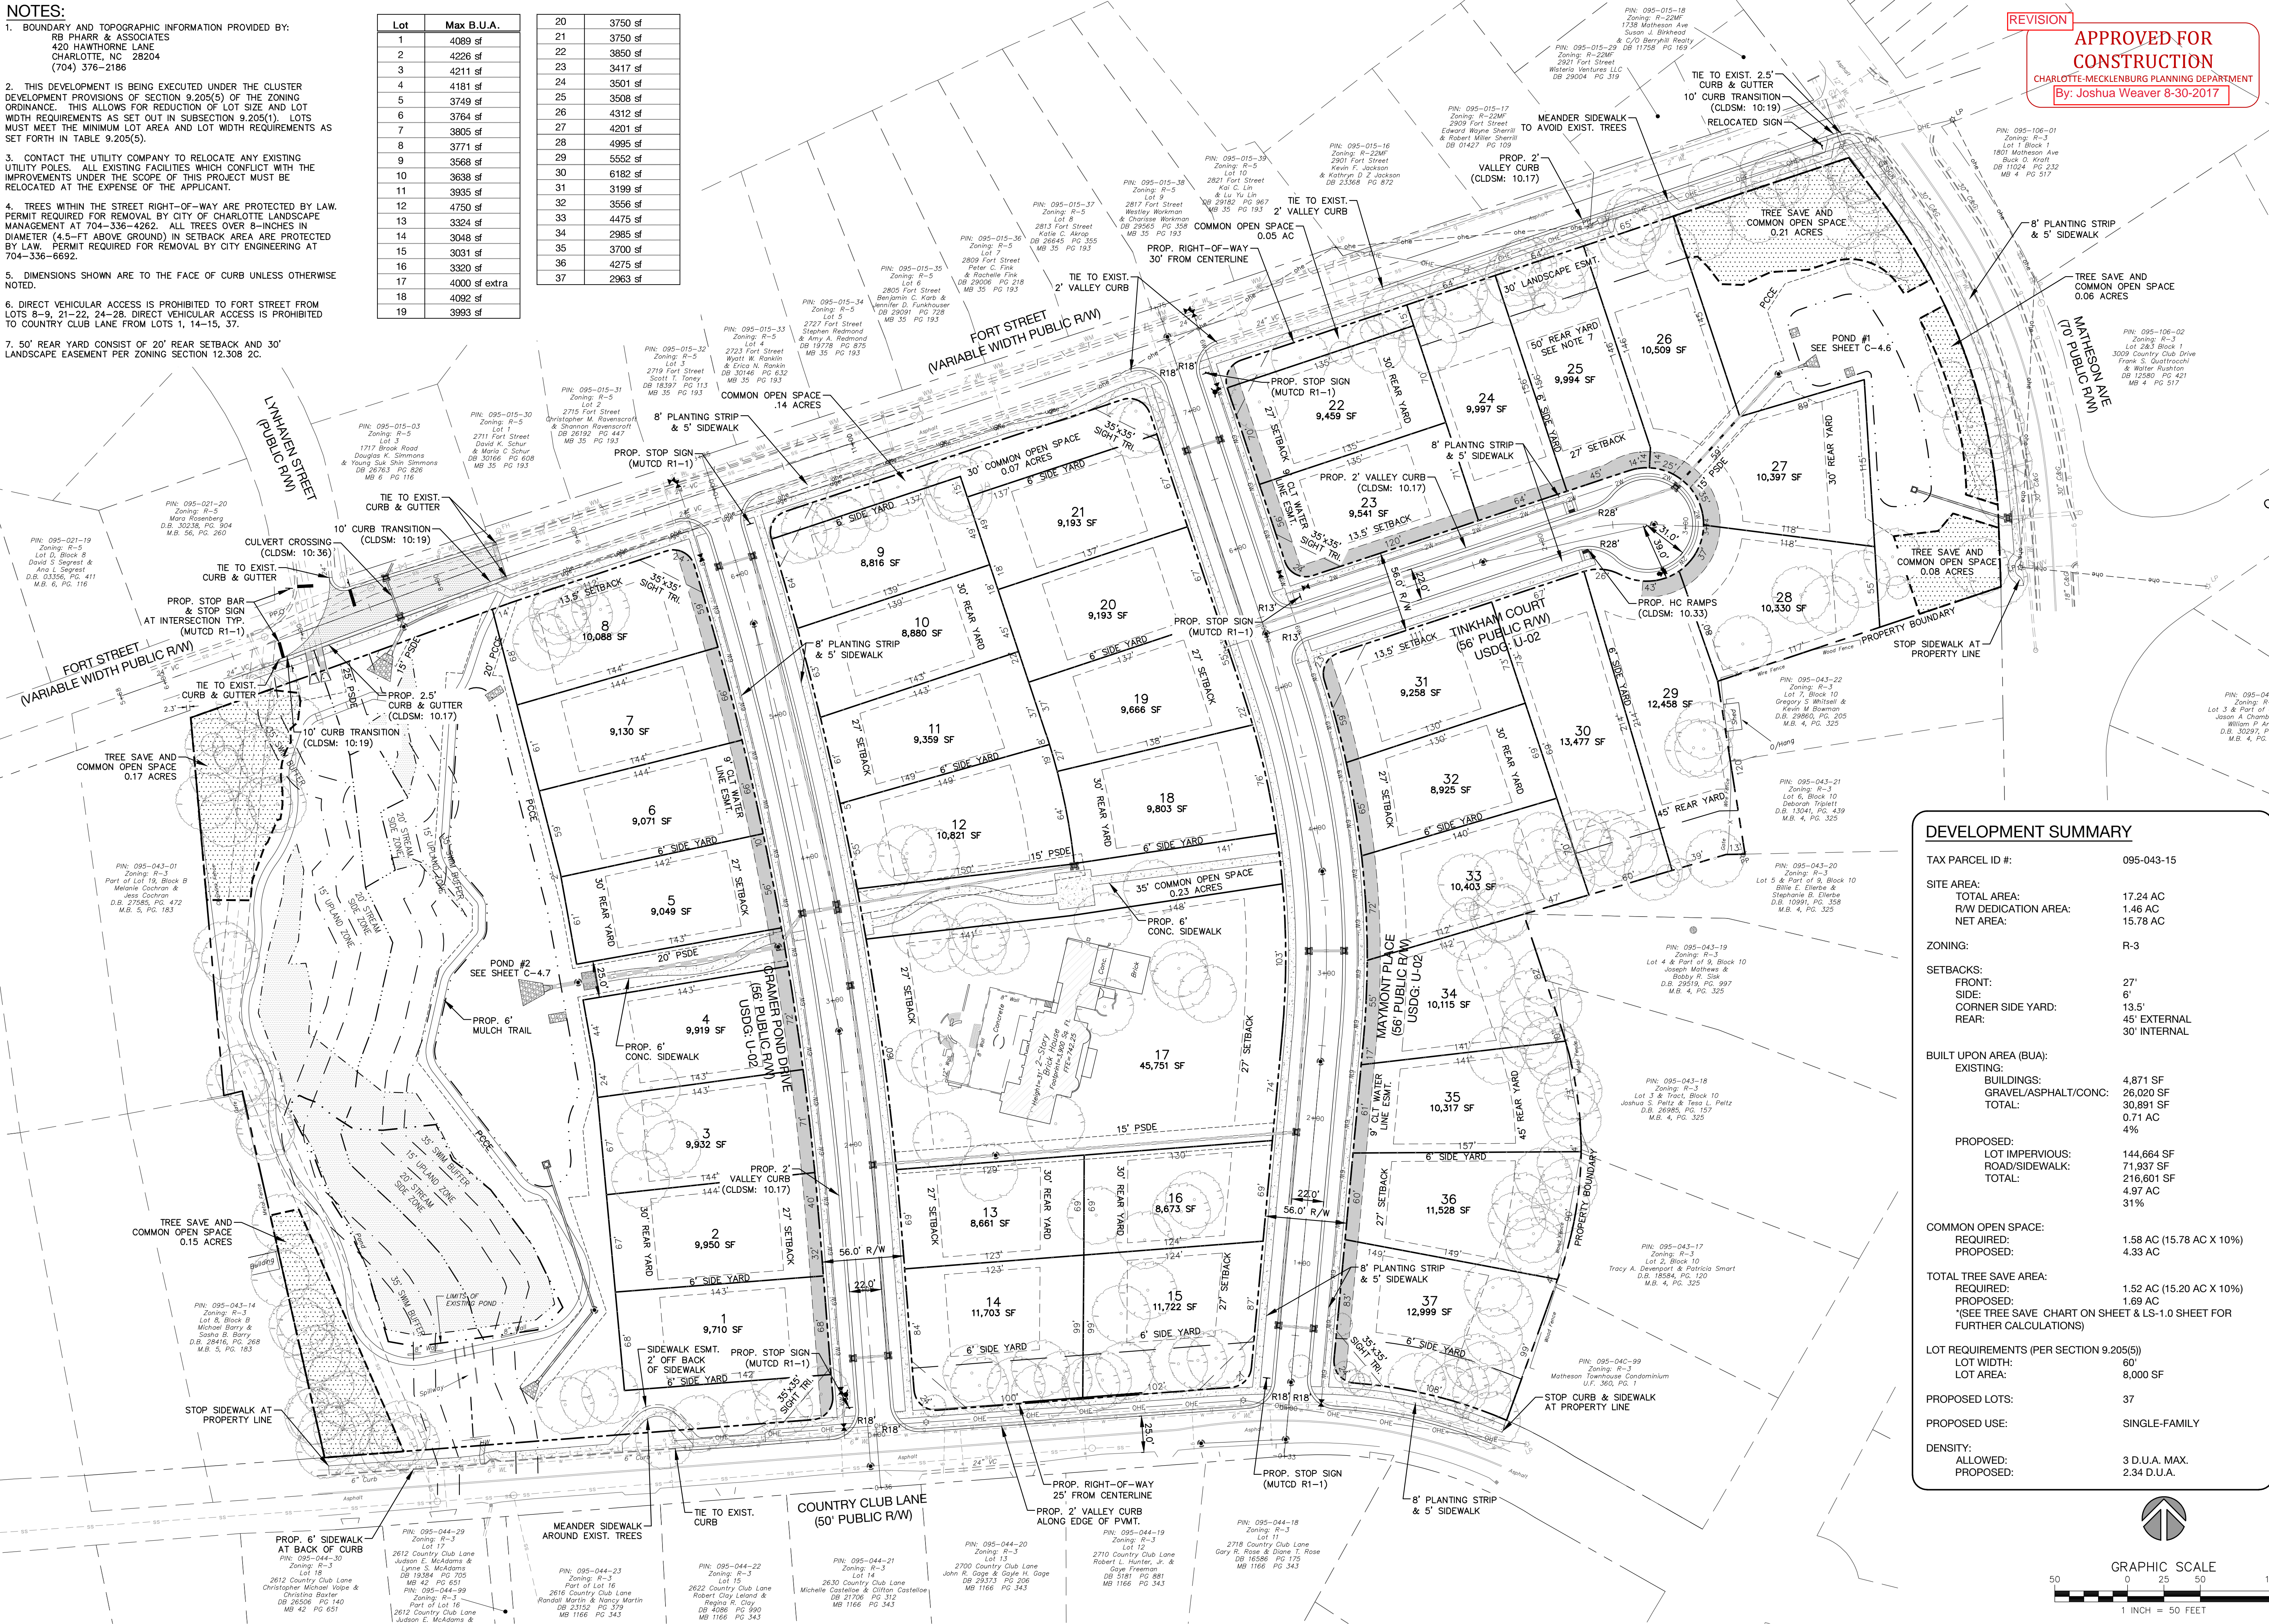

REVISION
APPROVED FOR CONSTRUCTION
CHARLOTTE-MECKLENBURG PLANNING DEPARTMENT
By: Joshua Weaver 8-30-2017

URBAN DESIGN PARTNERS

1318-e6 central ave. p. 704.334.3303
charlotte, nc 28205 f. 704.334.3308
urbandesignpartners.com

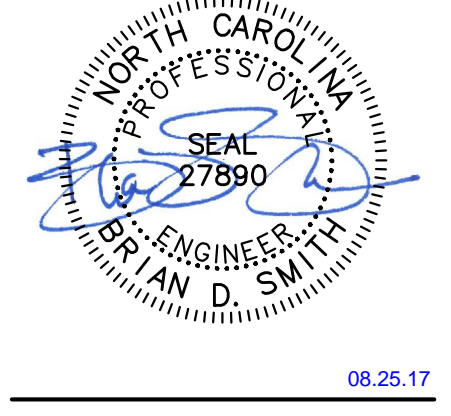

Country Club Lane, LLC


1600 Camden Road
Charlotte, NC 28203
704-541-9151

Cramer's Pond

Site Plan

Charlotte, North Carolina

DEVELOPMENT SUMMARY	
TAX PARCEL ID #:	095-043-15
SITE AREA:	
TOTAL AREA:	17.24 AC
RAW DEDICATION AREA:	1.46 AC
NET AREA:	15.78 AC
ZONING:	R-3
SETBACKS:	
FRONT:	27'
SIDE:	6'
CORNER SIDE YARD:	13.5'
REAR:	45' EXTERNAL 30' INTERNAL
BUILT UPON AREA (BUA):	
EXISTING:	
BUILDINGS:	4,871 SF
GRAVEL/ASPHALT/CONC:	26,020 SF
TOTAL:	30,891 SF 0.71 AC 49%
PROPOSED:	
LOT IMPERVIOUS:	144,664 SF
ROAD/SIDEWALK:	71,937 SF
TOTAL:	216,601 SF 4.97 AC 31%
COMMON OPEN SPACE:	
REQUIRED:	1.58 AC (15.78 AC X 10%)
PROPOSED:	4.33 AC
TOTAL TREE SAVE AREA:	
REQUIRED:	1.52 AC (15.20 AC X 10%)
PROPOSED:	1.69 AC
*SEE TREE SAVE CHART ON SHEET & LS-1.0 SHEET FOR FURTHER CALCULATIONS	
LOT REQUIREMENTS (PER SECTION 9.205(5))	
LOT WIDTH:	60'
LOT AREA:	8,000 SF
PROPOSED LOTS:	37
PROPOSED USE:	SINGLE-FAMILY
DENSITY:	
ALLOWED:	3 D.U.A. MAX.
PROPOSED:	2.34 D.U.A.

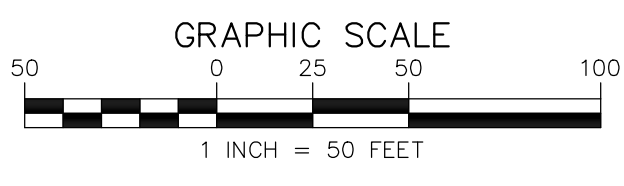

NO.	DATE	BY	REVISIONS:
1	03.16.16	UDP	PER CITY COMMENTS
2	05.04.16	UDP	PER CITY COMMENTS
3	06.07.16	UDP	PER CITY COMMENTS
4	12.21.16	UDP	SITE MODIFY & POND RESTORATION
5	02.02.17	UDP	PER FORT ST CONNECTION
6	06.09.17	UDP	PER SITE MODIFICATION
7	08.01.17	UDP	PER CITY COMMENTS
8	08.18.17	UDP	PER WETLAND DISTURBANCE
9	08.25.17	UDP	PER CITY COMMENTS

Project No: 15-038
Date: December 21, 2015
Designed by: udp
Drawn by: udp
Scale: 1"=50'
Sheet No:
C-3.0