

## CONDITIONAL NOTES


- 1. THE DEVELOPMENT OF THE SITE WILL BE CONTROLLED BY THE STANDARDS DEPICTED ON THE SITE PLAN AND BY THE STANDARDS OF THE CITY OF CHARLOTTE ZONING ORDINANCE. THE DEVELOPMENT DEPICTED BY THIS PLAN IS INTENDED TO REFLECT THE GENERAL ARRANGEMENT OF PROPOSED USES ON THIS SITE, BUT THE EXACT DETAILS OF THIS CONFIGURATION, PLACEMENT, AND SIZE OF THE INDIVIDUAL BUILDINGS AND/OR SITE ELEMENTS MAY BE ALTERED OR MODIFIED WITHIN THE LIMITS PRESCRIBED BY THE ORDINANCE AS SPECIFIED IN SECTION 6.206(2) DURING THE DESIGN DEVELOPMENT AND CONSTRUCTION PHASES. THE PROPOSAL IS INTENDED TO ENABLE THE DEVELOPMENT OF OFFICE/OFFICE PARK AND RELATED ANCILLARY FUNCTION. OTHER USES PERMITTED IN THE NS DISTRICT ARE ALLOWED ALSO. (SEE NOTE 8)
- 2. ALL PROPOSED DEVELOPMENT ON THIS SITE SHALL COMPLY WITH ORDINANCE REQUIREMENTS REGARDING THE NUMBER AND ARRANGEMENT OF OFF-STREET PARKING SPACES, SIGNAGE, YARD DIMENSIONS, BUFFERS, SCREENING, LANDSCAPING, ETC.
- 3. STORM WATER DETENTION FACILITIES SHALL NOT BE LOCATED WITHIN THE FRONT SETBACK OR BUFFER AREAS.
- 4. DUMPSTER/RECYCLING AREAS SHOULD BE ENCLOSED ON ALL FOUR SIDES BY A SOLID FENCE OR WALL WITH ONE SIDE BEING A HINGED GATE.
- 5. WALL PACK LIGHTING SHALL BE PROHIBITED. DETACHED LIGHTING WILL BE LIMITED TO TWENTY FEET IN HEIGHT AND WILL BE DESIGNED AND ERECTED SUCH THAT THE LIGHTING IS FULLY SHEILDED/CAPPED. DOWN LIGHTING WILL BE PERMITTED.
- 6. VEHICULAR ACCESS POINTS SHALL BE LIMITED TO THOSE SHOWN ON THE SITE PLAN. THE EXACT LOCATION MAY VARY SLIGHTLY FROM THAT DEPICTED, BUT SHALL COMPLY WITH ALL APPLICABLE DESIGN REQUIREMENTS OF THE CHARLOTTE DEPARTMENT OF TRANSPORTATION AND/OR N.C.D.O.T.
- 7. MAXIMUM BUILDING HEIGHT SHALL BEE LIMITED TO 2 STORIES.
- 8. ALL USES PERMITTED WITHIN THE NS ZONING DISTRICT SHALL BE PERMITTED EXCEPT THAT RETAIL AND RESTAURANT USES ALLOWED ONLY IN THE B-1 DISTRICT AS PERMITTED WITHIN THE NS DISTRICT SHALL BE LIMITED TO THE GROUND FLOORS OF BUILDINGS No. 1, 5, & 6 WITH A MAXIMUM OF 11,500 SQUARE FEET. MAXIMUM OF 37,800 SQUARE FEET SHALL BE PERMITTED ON THE SITE.
  - 9. ALL BUILDINGS ON THE SITE SHALL BE CONSTRUCTED OF BRICK, STUCCO, STONE AND/OR A COMBINATION OF THOSE OR OTHER MASONRY FINISHING MATERIALS. ALTHOUGH SOME ARCHITECTURAL DIVERSITY AND INDIVIDUAL BRANDING/IDENTITY WILL BE PERMITTED AMONG THE VARIOUS BUILDINGS, THERE WILL BE A REQUIREMENT FOR COMPLIMENTARY BUILDING MATERIALS, ROOF MATERIAL/DESIGN, COLORS, ETC. SUCH THAT AN OVERALL CONSISTENT DESIGN THEME IS ACHIEVED.
  - 10. A MAXIMUM OF 1 FINANCIAL INSTITUTION WITH DRIVE THROUGH WINDOWS SHALL BE PERMITTED. (BUILDING # 2)
  - 11. AS ILLUSTRATED BY THIS SITE PLAN, PARCELS WITHIN THE DEVELOPMENT SHALL BE INTERCONNECTED BY MEANS OF VEHICULAR AND SIDEWALK CONNECTIONS. THIS CONDITION ALSO PERTAINS TO THE EXTENSION OF VEHICULAR AND SIDEWALK CONNECTIONS TO THE ADJACENT PARCEL (029-362-05) PROPOSED FOR A FAST FOOD RESTAURANT AND PARCEL (023-352-06) AN EXISTING GAS STATION/CONVENIENCE STORE.
  - 12. BACKFLOW PREVENTERS ARE NOT PERMITTED ABOVE GROUND IN THE SETBACK AREAS.
- 13. ALL BUILDINGS WITHIN THE SITE SHALL BE DESIGNED SO THAT ALL SIDES OF EACH BUILDING ARE FINISHED WITH THE SAME BUILDING MATERIALS, COLOR, ETC. FURTHERMORE, IF THE BUILDING AT THE CORNER OF MALLARD CREEK ROAD AND DRIWOOD COURT DOES NOT FRONT ON MALLARD CREEK RD, THEN THE BUILDING ELEVATION FACING MALLARD CREEK RD, SHALL NOT BE A BLANK WALL, AT A MINIMUM, THE ELEVATION SIDE FACING MALLARD CREEK ROAD SHALL BE DESIGNED
- 14. DETACHED BUILDING IDENTIFICATION SIGNAGE SHALL BE LIMITED TO A MAXIMUM OF FOUR FEET IN HEIGHT AND THIRTY-TWO SQUARE FEET IN AREA.
- 15. IT IS ANTICIPATED THAT THE PARCELS WILL BE DEVELOPED UNDER ONE OWNERSHIP; HOWEVER THE PLAN IS DESIGNED SO THE PARCELS CAN BE DEVELOPED INDEPENDENT OF ONE ANOTHER (le: REQUIRED STREET FRONTAGE, OFF STREET PARKING, ETC.). IN THIS CASE, CROSS PARKING AND ACCESS EASEMENTS, ETC. SHALL BE ESTABLISHED PRIOR TO THE ISSUANCE OF A BUILDING PERMIT.
- 16. THE PETITIONER/DEVELOPER SHALL TIE-IN TO THE EXISTING STORM WATER SYSTEMS). THE PETITIONER SHALL HAVE THE RECEIVING DRAINAGE SYSTEMS) ANALYZED TO ENSURE THAT IT WILL NOT BE TAKEN OUT OF STANDARD DUE TO THE DEVELOPMENT. IF IT IS FOUND THAT DEVELOPMENT WILL CAUSE THE STORM DRAINAGE SYSTEMS) TO BE TAKEN OUT OF STANDARD, THE PETITIONER SHALL PROVIDE ALTERNATE METHODS TO PREVENT THIS FROM OCCURRING.
- 17. THE PETITIONER/DEVELOPER SHALL EXTEND/RE-ROUTE DRIVOOD COURT TO PROSPERITY CHURCH ROAD AS SHOWN.


  THE PAVEMENT THICKNESS OF REROUTED DRIVOOD COURT SHALL COMPLY WITH COMMERCIAL COLLECTOR PUBLIC STREET STANDARDS. THE PETITIONER/DEVELOPER SHALL DEDICATE RIGHT OF WAY FOR RELOCATED DRIVOOD COURT THROUGH THE SUBDIVISION PROCESS AS REQUIRED.
- 18. BUILDING SETBACK FOR MALLARD CREEK ROAD SHALL BE 20' MEASURED FROM ITS EXISTING R/W. BUILDING SETBACK FOR PROSPERITY CHURCH ROAD SHALL BE 14' MEASURED FROM THE BACK OF CURB OF A FUTURE 14.5' STREET WIDENING. BUILDING SETBACK ALONG DRIWOOD COURT SHALL BE 14' FROM THE PROPOSED BACK OF CURB AT R/W.
- 19. BUILDING FOOTPRINTS WHICH AR ILLUSTRATED ARE GENERAL AND APPROXIMATE WITH RESPECT TO SIZE, SHAPE, ETC.
  MINOR AND INCIDENTAL CHANGES ARE ALLOWED AS A MATTER OF RIGHT BASED UPON FINAL CONSTRUCTION/ENGINEERING
  DRAWINGS, SPECIFIC TENANT NEEDS, ETC. HOWEVER, THIS MODIFICATION ALLOWANCE DOES NOT PERTAIN TO BUILDING
  PLACEMENT ON THE PARCEL.
- 20. THE SETBACK AREA ON PROSPERITY CHURCH ROAD SHALL BE LANDSCAPED WITH A COMBINATION OF NEW TREES AND SHRUBS AS WELL AS THE RETENTION OF EXISTING TREES WITHIN THE SETBACK THAT ARE SIX INCHES IN CALIPER OR GREATER. THE REQUIREMENT TO RETAIN SUCH TREES MAY BE WAIVED FOR THE AREA WITHIN TEN FEET OF PLACEMENT
- 21. AS ILLUSTRATED ON THE PLAN, NO OFF-STREET PARKING SHALL BE PERMITTED WITHIN THE AREA OF THE BUILDING ALONG DRIWOOD COURT AND THE STREET RIGHT OF WAY.
- 22. IF NOT ALREADY CONSTRUCTED, THE ENTRANCE PROVIDING VEHICULAR INGRESS/EGRESS TO PARCEL (029-362-05)
  LOCATED OPPOSITE THE PROPOSED DRIVEWAY FOR THE MULTI FAMILY ACROSS DRIVOOD CT. SHALL BE CONSTRUCTED AS SOON AS POSSIBLE AFTER SUBDIVISION APPROVAL FOR THIS SITE.
- 23. OFF-STREET PARKING SHALL BE PROVIDED IN ACCORDANCE WITH A PARKING RATIO OF DNE SPACE PER 300 SQUARE FEET FOR GENERAL/PROFESSIONAL OFFICES AND DNE SPACE PER 200 SQUARE FEET FOR MEDICAL OFFICE USE AND AT ONE SPACE PER 250 SQUARE FEET FOR NS USES, AND DNE SPACE PER 175 SQUARE FEET FOR RESTAURANT USES.

  PATIO AREAS VILL NOT REQUIRE PARKING IN EXCESS OF THE ADJACENT BUILDING PARKING REQUIREMENT.
- 24. PROPOSED DEVELOPMENT WILL COMPLY WITH ANY BICYCLE STORAGE/PARKING ORDINANCE IN AFFECT AT THE TIME OF
- BUILDING PERMIT SUBMITTALS.

  25. AS SIMILAR SHOWN ALONG DRIVOOD COURT, A 6' SIDEVALK AND 8' PLANTING STRIP SHALL BE CONSTRUCTED ALONG
  THE SITES MALLARD CREEK ROAD AND PROSPERITY CHURCH ROAD FRONTAGES. THE EXISTING 4' PLANTING STRIP AND
  5' SIDEVALK MAY REMAIN IF ACCEPTABLE TO CITY ENGINEERING RELEASING THE DEVELOPER FROM INSTALLING THE 6'
- SIDEWALK AND 8' PLANTING STRIP.

  26. NO DRIVE THROUGH WINDOWS WILL BE PERMITTED EXCEPT FOR THE FINANCIAL INSTITUTION ALLOWED UNDER NOTE 10.

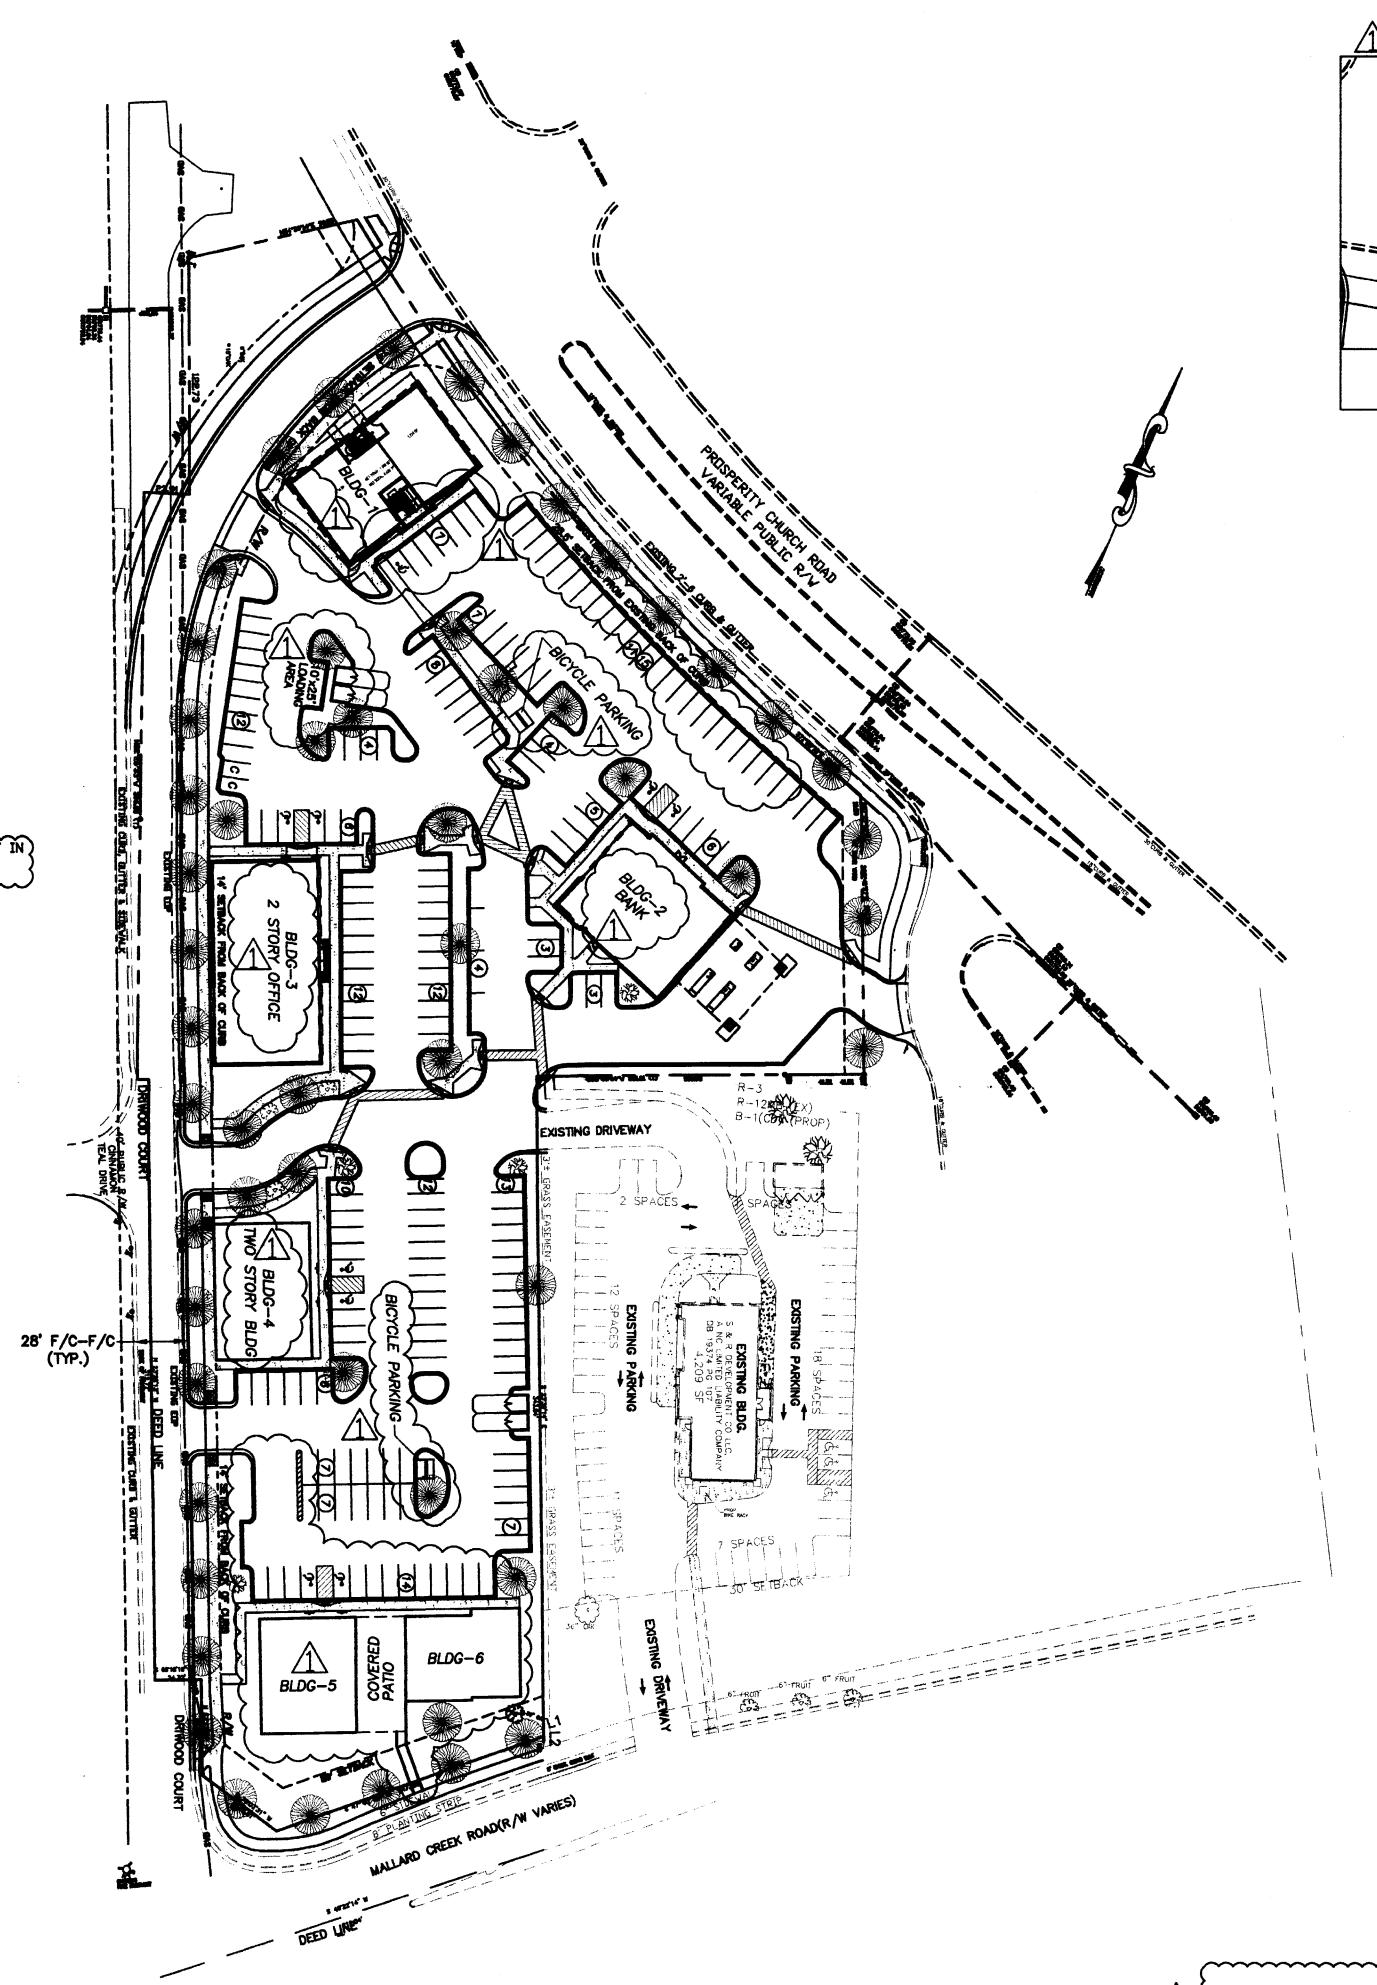

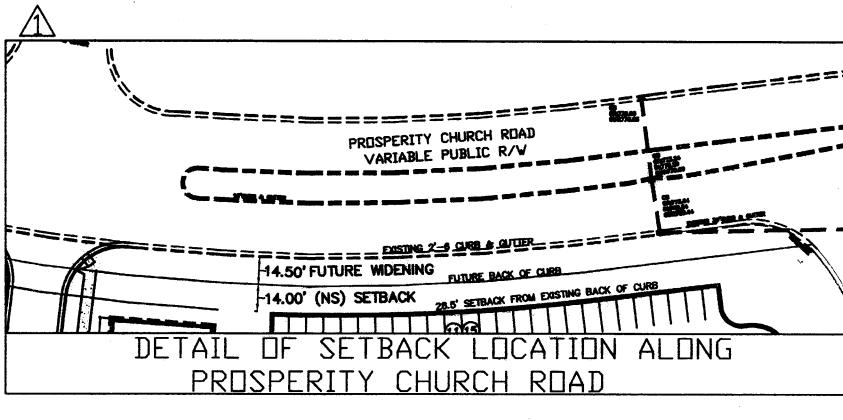

## DOT NOTES:


- 1. THE PROPOSED DRIVEWAY CONNECTION TO DRIWOOD COURT WILL REQUIRE A DRIVEWAY PERMIT TO BE SUBMITTED TO COOT FOR REVIEW AND APPROVAL. THE EXACT DRIVEWAY LOCATION AND TYPE/WIDTH OF THE DRIVEWAY WILL BE DETERMINED BY COOT DURING THE DRIVEWAY PERMIT PROCESS, THE LOCATIONS OF THE DRIVEWAY SHOWN ON THE SITE PLAN ARE SUBJECT TO CHANGE IN ORDER TO COMPLY WITH CITY DRIVEWAY REGULATIONS AND THE CITY TREE ORDINANCE.
- 2. ANY FENCE OR WALL CONSTRUCTED ALONG OR ADJACENT TO ANY SIDEWALK OR STREET RIGHT-OF-WAY REQUIRES A CERTIFICATE ISSUED BY CDOT.
- 3. A RIGHT-OF-WAY ENCROACHMENT AGREEMENT IS REQUIRED FOR THE INSTALLATION OF ANY NONSTANDARD ITEM(S) (IRRIGATION SYSTEMS, DECORATIVE CONCRETE PAVEMENT, BRICK PAVERS, ETC.)
  WITHIN A PROPOSED/EXISTING CITY MAINTAINED STREET RIGHT-OF-WAY BY A PRIVATE INDIVIDUAL,
  GROUP, BUSINESS, OR HOMEOWNER'S/BUSINESS ASSOCIATION. AN ENCROACHMENT AGREEMENT MUST BE
  APPROVED BY NCDOT PRIOR TO THE CONSTRUCTION/INSTALLATION OF THE NON-STANDARD ITEMS(S).
  CONTACT NCDOT FOR ADDITIONAL INFORMATION CONCERNING COST, SUBMITTAL, AND LIABILITY
  INSURANCE COVERAGE REQUIREMENTS.

(4. THE DEVELOPER MUST DEVELOP THE SITE WITH A 28.5 FOOT SETBACK FROM EXISTING BACK OF CURB ALONG PROSPERITY CHURCH ROAD. THIS WILL ALLOW FUTURE 14.5' WIDENING AND 14 FOOT SETBACK (NS) FROM BACK OF FUTURE CURB.

5. DEVELOPER MUST PROVIDE A 14 FOOT SETBACK FROM BACK OF CURB ALONG DRIWOOD COURT.

DEVELOPMENT DATA:

EXISTING ZONING= NS
PROPOSED ZONING= NS SPA
LOT SIZE= 4.74 ACRES
PROPOSED USE= (OFFICE AND OTHER NS USES)
MAX. BUILDING AREA: (TOTAL= 37,800)

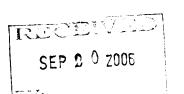

FOR PUBLIC HEARING PETITION # 2006-139

Revision Prosperity Pointe Graphic Scale: PER REVIEW COMMENTS Tom A. Mann TWL 9.17.2006 5.30.2006 Driwood Court Pineville, North Carolina 28134
(704) 880-8200

James McGovern & Associates

Sheet Title Ted W. Lawrence Charlotte. North Carolina roject Number 465.002 (IN FEET) Consulting Engineers Scale: (1"=50") Rezoning Plan C1\jma\_proj\465002 REZDNING\dwg\jma-rezoning-9-20-2006.dwg 9/20/2006 8/25/39 AM \dwa\finalbas