


SITE LEGEND	
EXISTING ZONING	R8
PROPOSED ZONING	UR-2(CD)
PROPOSED USE	MULTI FAMILY HOUSING
SITE ACREAGE	6.7645
TAX PARCEL# FOR UR-2 (CD)	12523428, 12523408, 12523410, 12523417, 12523422, 12523419, 12523415, 12522602, 12522603, 12523425
NUMBER OF TOWN HOMES	74 UNITS
ARE NOT INCLUDED FOR FOR ZONING	
AREA TO BE REZONED	
EXISTING TREES TO REMAIN	

General Notes:

- Development of the site will be controlled by the standards depicted on this site plan by the standards of the city of Charlotte, NC zoning ordinances. The development depicted on this plan is intended to reflect the arrangement of proposed uses on the sites, but the exact configuration, placement, and size of individual site elements may be altered or modified within the limits prescribed by the ordinance during the design development and construction phases per section 6.2 of the Zoning Ordinance.
- Screening will comply with the applicable standards set forth in section 12.303 of the city of Charlotte zoning ordinance.
- Parking meets the standards of the table 12.202 of the city of Charlotte zoning ordinance.
- Maximum building height shall be 40 feet
- The dumpsite's will be screened by a 6' solid wood fence or a solid masonry fence with a solid wood gate.
- All proposed trees, fences and signs will not interfere with sight distance at the entrance of the site. Any fence requiring a certificate will be obtained from the cdot.
- A standard 2'-6" curb and gutter, associated storm drainage along with a 6' sidewalk, 8' feet planting strip, and with out side lighting that will be fully shielded at 15 feet high maximum along Luther st., Avant st., Baxter st., and Main st. will be provided. (A six foot wide sidewalk will be constructed by the petitioner along avant street, luther st., main st., and baxter street. Typical there will be an eight foot planting strip between curb and sidewalk, however, planting strip width may be reduced to protect existing trees along streets, with prior approval from urban forestry staff.)
- All parking spaces will be within enclosed garages.

- No storm water detention in buffer or setbacks.
- The sidewalk may meander and the planting width may vary to save trees 6" in caliper and larger.
- All utilities to be underground.
- Pedestrian scale lighting will be installed and will not exceed feet in height. No "wall pak" lighting will be installed, but architectural lighting on building facades will be permitted. (lighting at 15 feet high maximum.)
- Signage will be permitted in accordance with applicable zoning standards.
- Storm water Quantity Control: The petitioner shall tie-in to the existing storm water system(s). The petitioner shall have the receiving drainage system(s) analyzed to ensure that it will not be taken out of standard due to the development. If it is found that development will cause the storm drainage system(s) to be taken out of standard, the petitioner shall provide alternate methods to prevent this from occurring.
- Storm water quality treatment: for projects with defined watersheds greater than 24% built-upon area, construct water quality best management practices (BMPs) to achieve 85% Total Suspended solid (TSS) removal for the runoff generated from the first 1-inch of rainfall within the proposed parking areas BMPs must be designed and constructed in accordance with the NC Department of Environment and Natural Resources (NCDENR) best management practices Manual, April 1999, section 4.0 (Design Standards shall be met occurring to the city of Charlotte best management practices manual. when available).
- Volume and peak control: for projects with defined watersheds greater than 24% built-upon areas, control the entire volume for the 1 year, 24-hour storm. Runoff volume drawdown time shall be a minimum of 24 hours, but not more than 120 hours.
- The petitioner acknowledges that other standard development requirements imposed by other city ordinances, standards, policies, and appropriate design manuals will exist. Those criteria (for example, those that required buffers, regulate streets, sidewalks, trees, storm water, and site developments, etc.) will apply to the development site. This includes chapters 6, 9, 12, 17, 18, 19, 20, and 21 of the city code. Conditions set forth in this petition are supplemental requirements imposed on the development in addition to other standards. Where conditions on this plan differ from ordinances, standards, policies, and approaches in existence at the time of formal engineering plan review submission, the stricter condition or existing requirements shall apply.
- Throughout this rezoning petition, the terms "Owners", "Owners", "Petitioners" shall, with respect to the site, be deemed to include the heirs, devisees, personal representatives, successors in interest and assignees of the owner or owners of the site who may be involved shall apply.
- There will be under ground storm water detention system put in place

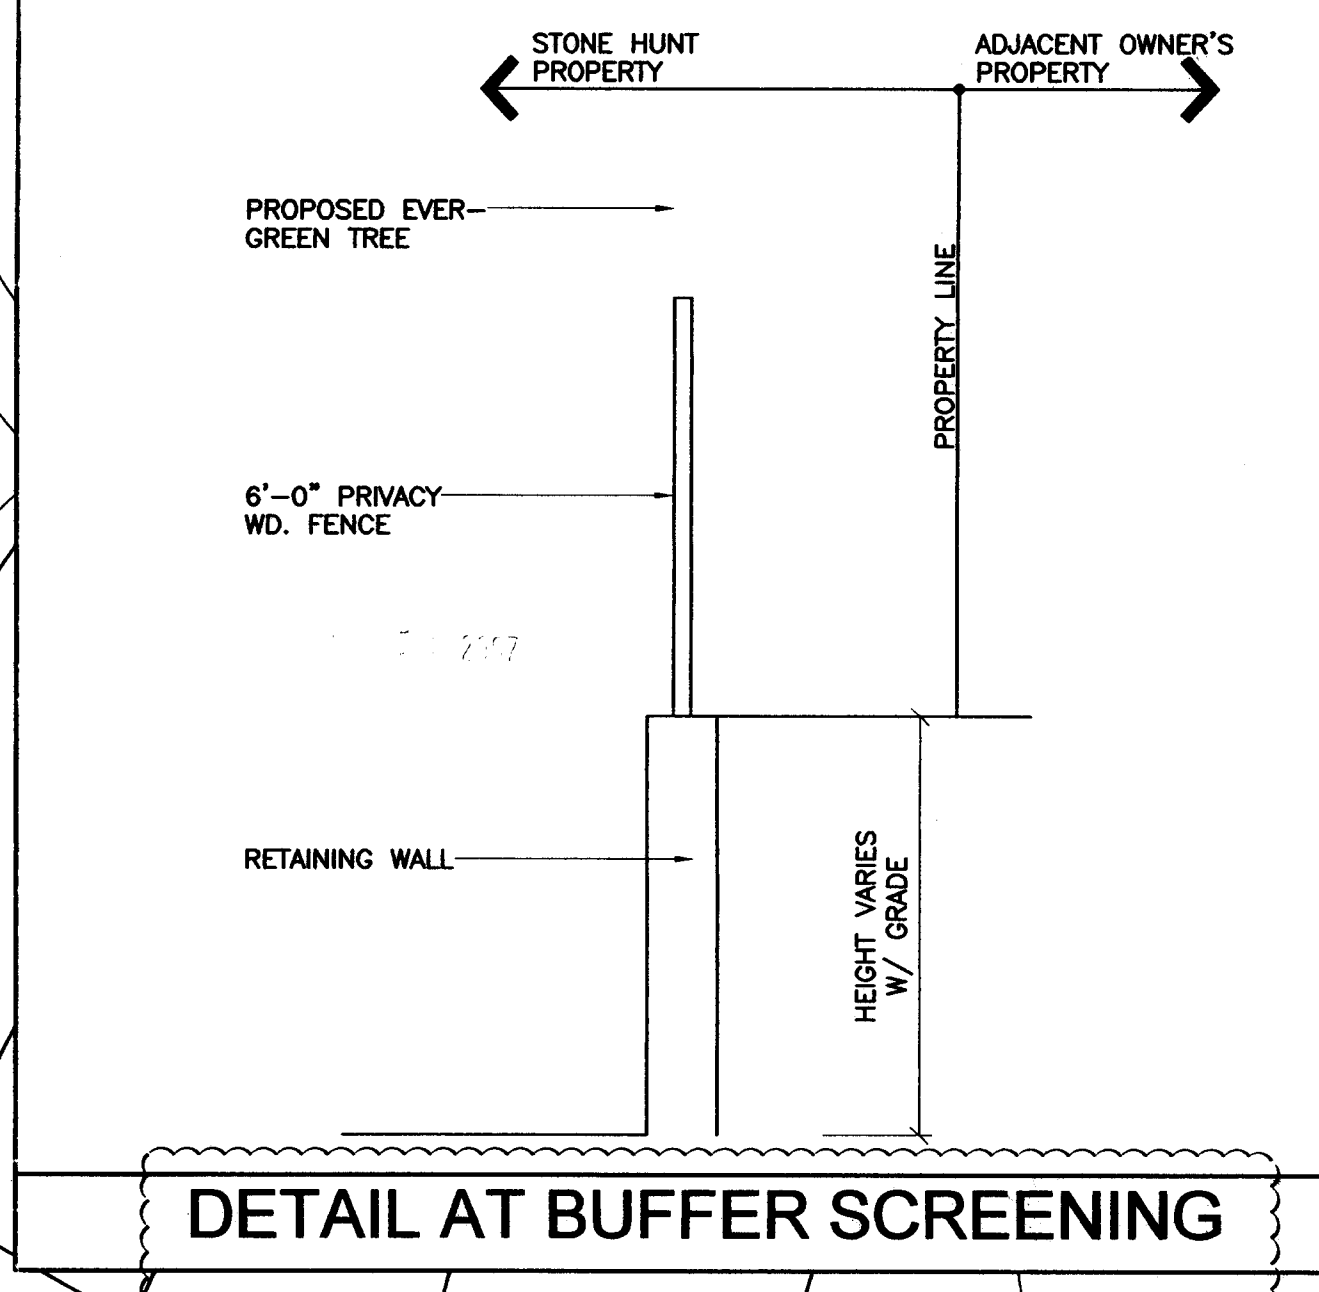

1313 N. Tryon St.
Charlotte, NC 28206
Tel: 704.333.1985
Fax: 704.336.7122

123 W. Main St.
Charlotte, NC 28201
Tel: 919.686.6300
Fax: 919.686.8800

Millennium Design Group
ARCHITECTURE

DESIGNER	ARCHITECT	PLANNING	ENGINEER	LANDSCAPE
DESIGNER	ARCHITECT	PLANNING	ENGINEER	LANDSCAPE

THIS DOCUMENT IS THE PROPERTY OF
MILLENNIUM DESIGN GROUP AND IS NOT
TO BE REPRODUCED IN WHOLE OR IN PART
WITHOUT THE PERMISSION OF THE ARCHITECT.

STONEHUNT (704) 604-4556
THE GROVE AT CHERRY
TOWN HOMES
CHARLOTTE, NC
ZONING PARTITION NUMBER
SITE PLAN

NO.	DATE	DESCRIPTION
1	9-11-07	PLANNING COMMENTS
2		
3		

DATE: 6-20-2007
SCALE: AS NOTED
DRAWN BY: HWJ
CHECKED BY: AVH
JOB NO.:
CAD FILE:
SHEET NO:


FOR PUBLIC HEARING
PETITION: 2007-128

C0100



1 | FRONT ELEVATION

SCALE: 1/4"=1'-0"

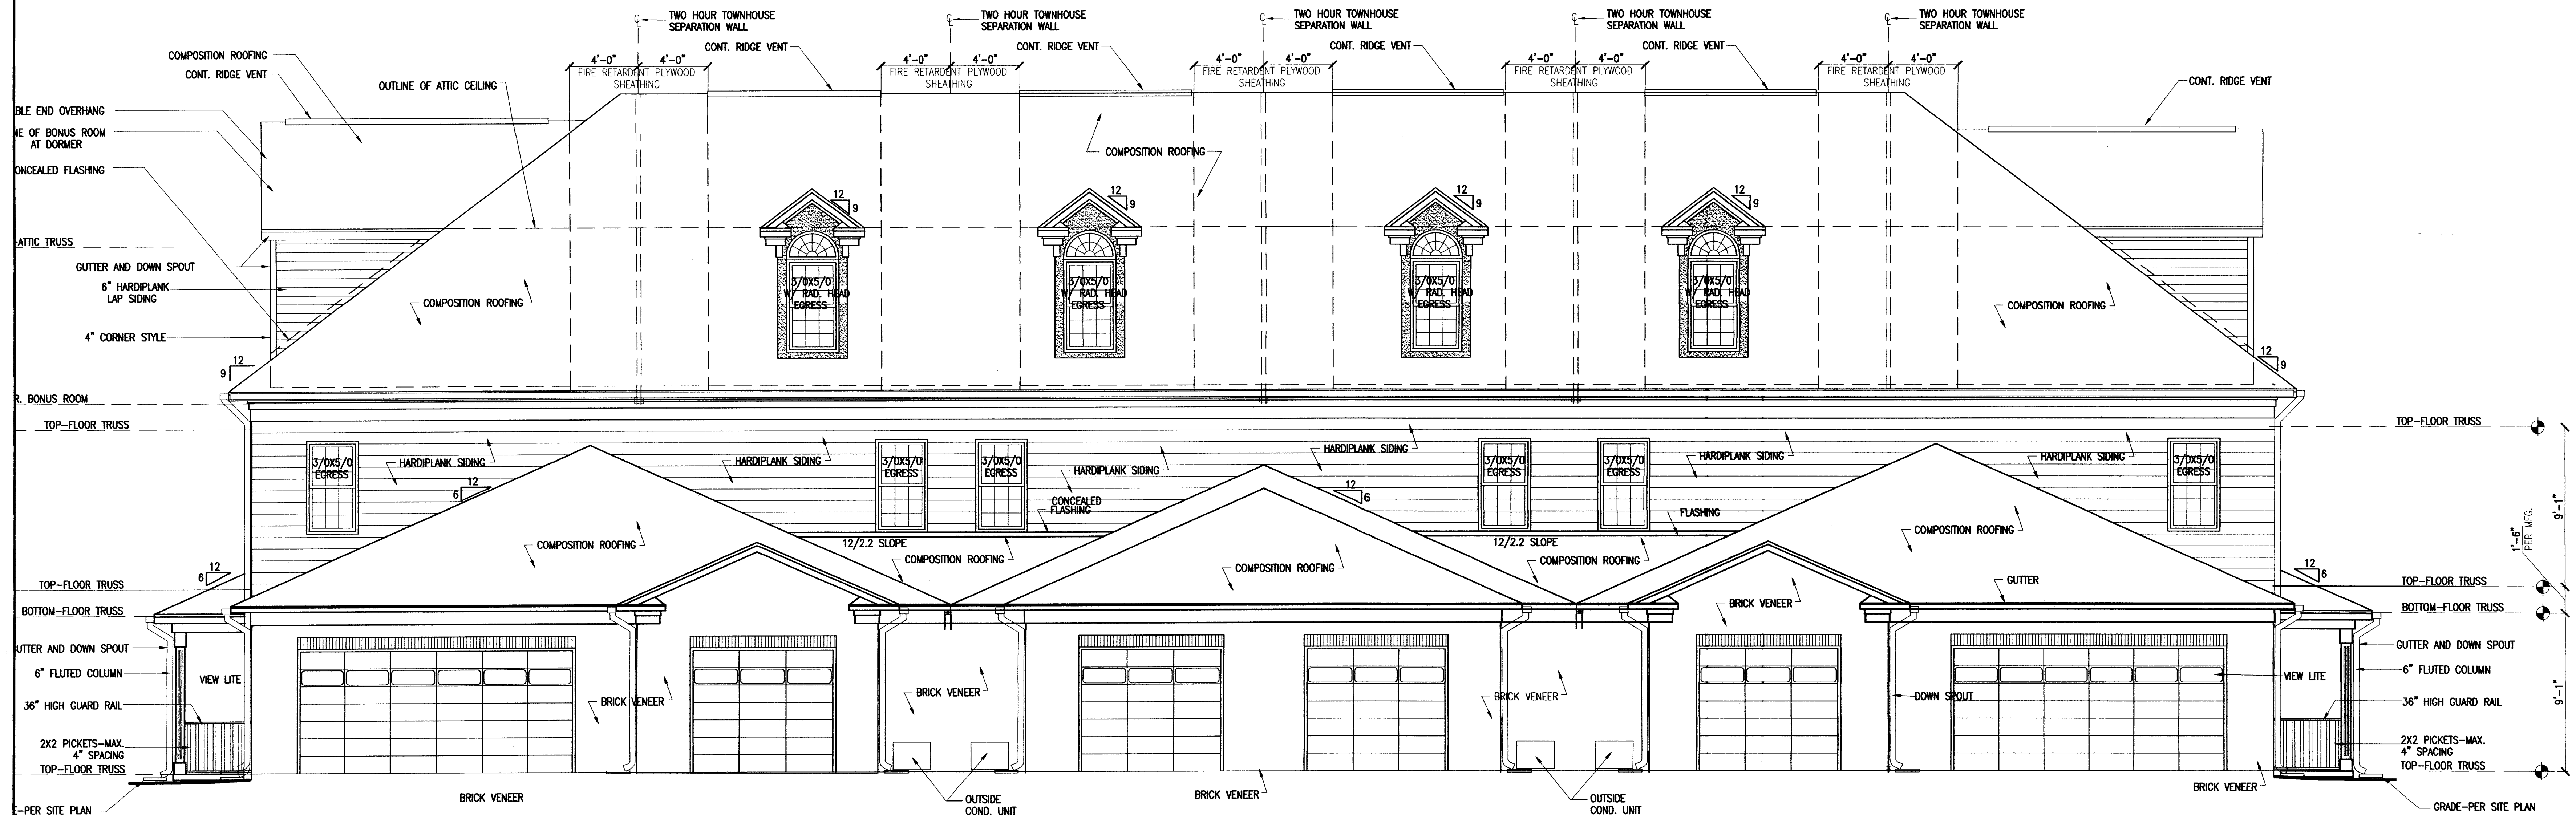

REAR ELEVATION

2 | REAR ELEVATION

SCALE: 1/4"=1'-0"