


NOT TO SCALE

CHARLOTTE PROGRESSIVE  
FIREFIGHTERS ASSOC  
PARCEL ID: 08901202  
PO BOX 16619  
CHARLOTTE NC 28297

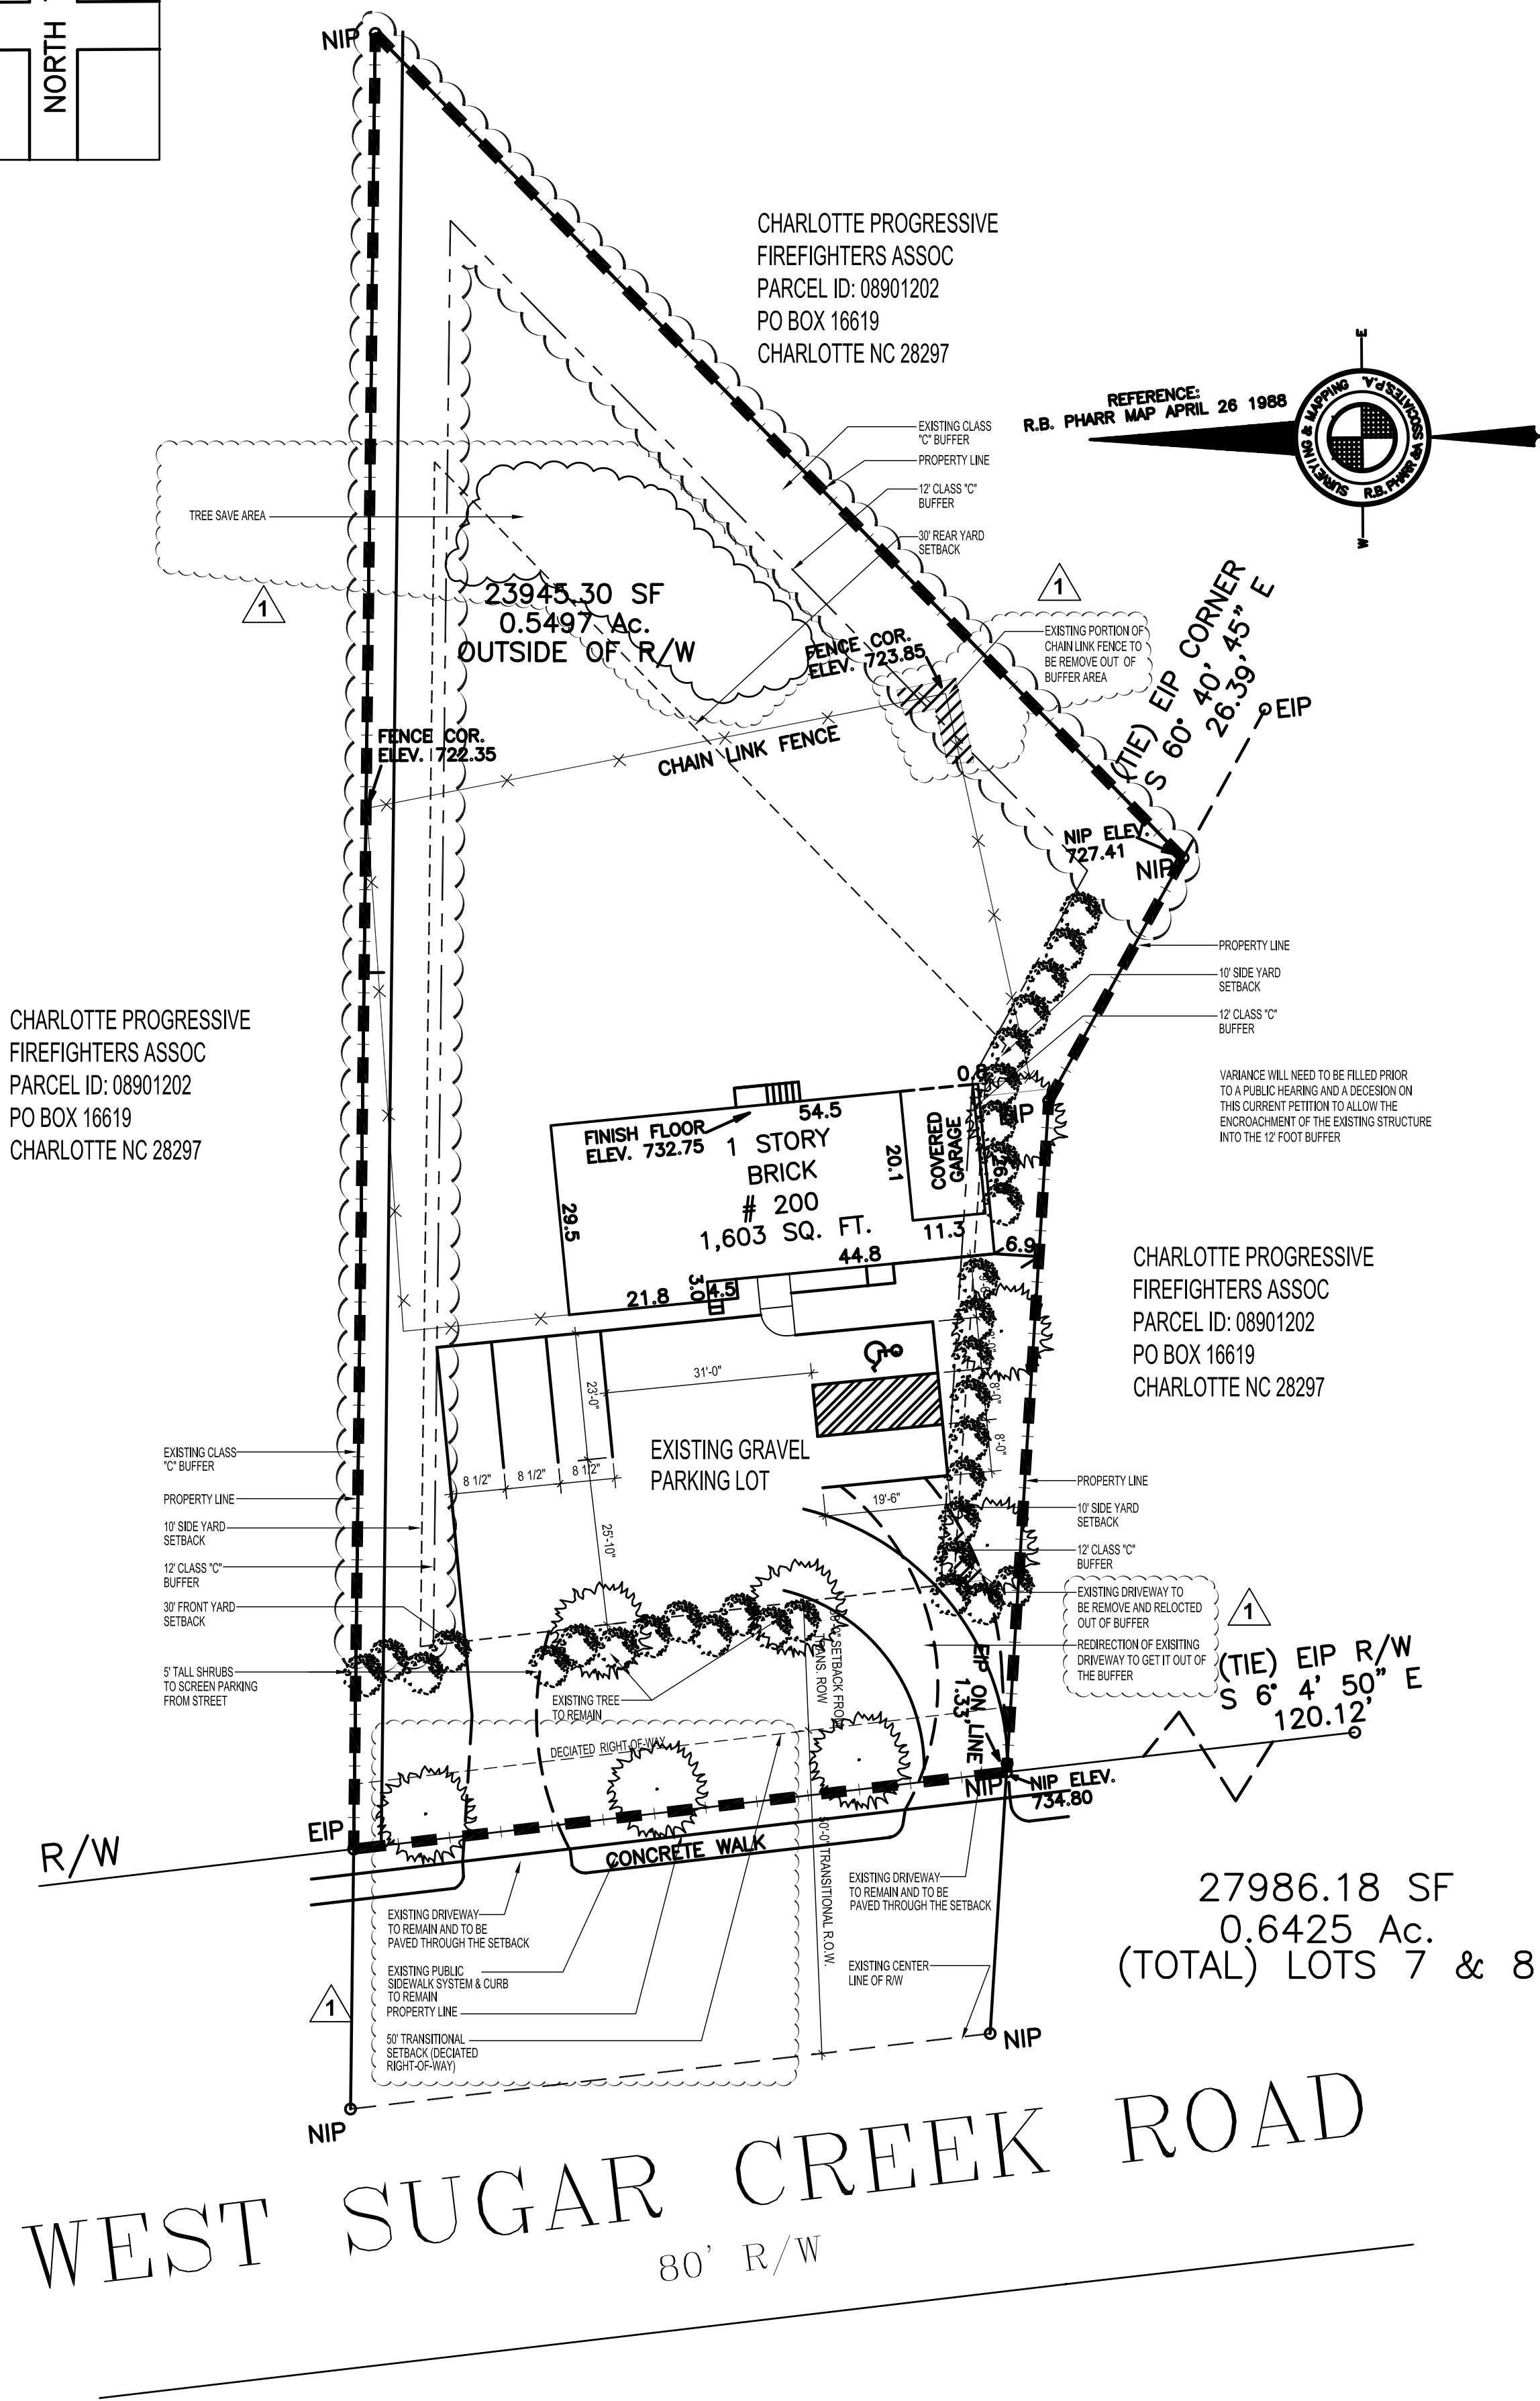

BENCHMARK = 733.68  
RIM OF MANHOLE

SITE DATA PARCEL-ID# 08901203

EXISTING ZONING	R-12 (MULTI-FAMILY)
PROPOSED ZONING	O-1 (GO)
CURRENT USE	OFFICE BUILDING
PROPOSED USE	GENERAL OFFICE

MAXIMUM SQUARE FOOTAGE 47,163 SQ. FT.

SITE ACREAGE 0.6425

AREA TO BE REZONED

EXISTING CHAINLINK FENCE

CENTER LINE OF R/W LINE

BLDG SET BACK LINE

PLANTING STRIP

A FIRE HYDRANT IS LOCATED WITHIN 750' OF THE MOST REMOTE POINT OF A BUILDING AS TRUCK TRAVELS. (NEAREST FIRE HYDRANT IS APPROX. 180' AWAY FROM THE PROPERTY.)

Conditional Notes

1. ANY NEW STRUCTURE WILL BE RESIDENTIAL IN CHARACTER AND THAT THE PROPOSED STRUCTURE WILL HAVE WINDOWS, DOORS, AND BREAK UP LINE EXPANSES OF BLANK WALLS. BLANK WALLS WILL NOT BE LONGER THAN 15 FEET.
2. No storm water detention in buffer or setbacks.
3. All the new utilities to be underground.
4. Throughout this rezoning petition, the terms "Owners/Petitioners" shall, with respect to the site, be deemed to include the heirs, devisees, personal representatives, successors in interest and assignees of the owner or owners of the site who may be involved shall apply.
5. 15 percent of the tree ordinance requires 15 percent for commercial sites.
6. The petitioner acknowledges that other standard development requirements imposed by other city ordinances, standards, policies, and appropriate design manuals will exist. Those criteria (for example, those that require buffers, regulate streets, sidewalks, trees, stormwater, and site development, etc.) will apply to the development site; this includes chapters 6, 9, 12, 17, 18, 19, 20, and 21 of the city code. Conditions set forth in this petition are supplemental requirements imposed on the development in addition to other standards, where conditions on this plan differ from ordinances, standards, policies, and approaches in existence at the time of formal engineering plan review submission, the stricter condition or existing requirements shall apply.
7. If an adjacent property zoning changes to a district that would not require a buffer, the buffer required for this property may be reduced or eliminated to meet the proper requirement for that zoning criteria.
8. The petitioner will comply with the Charlotte City Council approved and adopted Post Construction Controls Ordinance.
9. The Building height will not exceed 40'

10. Ached and detached lighting will be limited to 15 feet and all fixtures will be fully shielded and full cutoff fixture.
11. The development of the site shall be controlled by the standards depicted on this Site Plan and by the standards of the City of Charlotte Zoning Ordinance. The development depicted by this plan is intended to reflect the general arrangement of the proposed use on the site, but the exact details of the configuration and placement of site elements may be altered or modified within the limits prescribed by the ordinance as specified in section 6.206(2) as may be applicable. Minor and incidental changes of detail which do not alter the basic, overall layout and/or the relationships to abutting sites are permitted as a matter of right for the petitioner/developer.
12. All proposed development on the site shall comply with applicable ordinance requirements regarding such things as the number and arrangement of off-street parking, setback/yard dimensions, signage, screening, open space, landscaping, tree ordinance, etc.
13. Vehicular access shall be limited to the two shown on this plan. The exact location may vary from depicted, but shall comply with all applicable design/location requirements of the Charlotte Department of Transportation.
14. No dumpster to be used roll out container.

REZONING PETITION #  
FAMILY OUTREACH &  
COUNSELING CENTER, INC.  
200 W. SUGAR CREEK RD.  
CHARLOTTE, N.C. 28213

REVISIONS:		
NO.	DATE	DESCRIPTION
1	11-12-14	REBENT/CAMER
2		
3		
DATE: SEPT 2, 2014		
SCALE:		
DRAWN BY:		
CHECKED BY:		
JOB NO. 10-0014		
CAD FILE: FAMILY		

AMERICAN ARCHITECTURE  
COLLABORATIVE, LLC  
1313 N. TRYON ST.  
CHARLOTTE, NC 28206  
TEL: 704.383.1965  
FAX: 704.376.7122