


**6 THIS IS A SPA (SITE PLAN AMENDMENT) FOR  
(THE SUBJECT (HIGHLIGHTED) PROPERTY ONLY)**

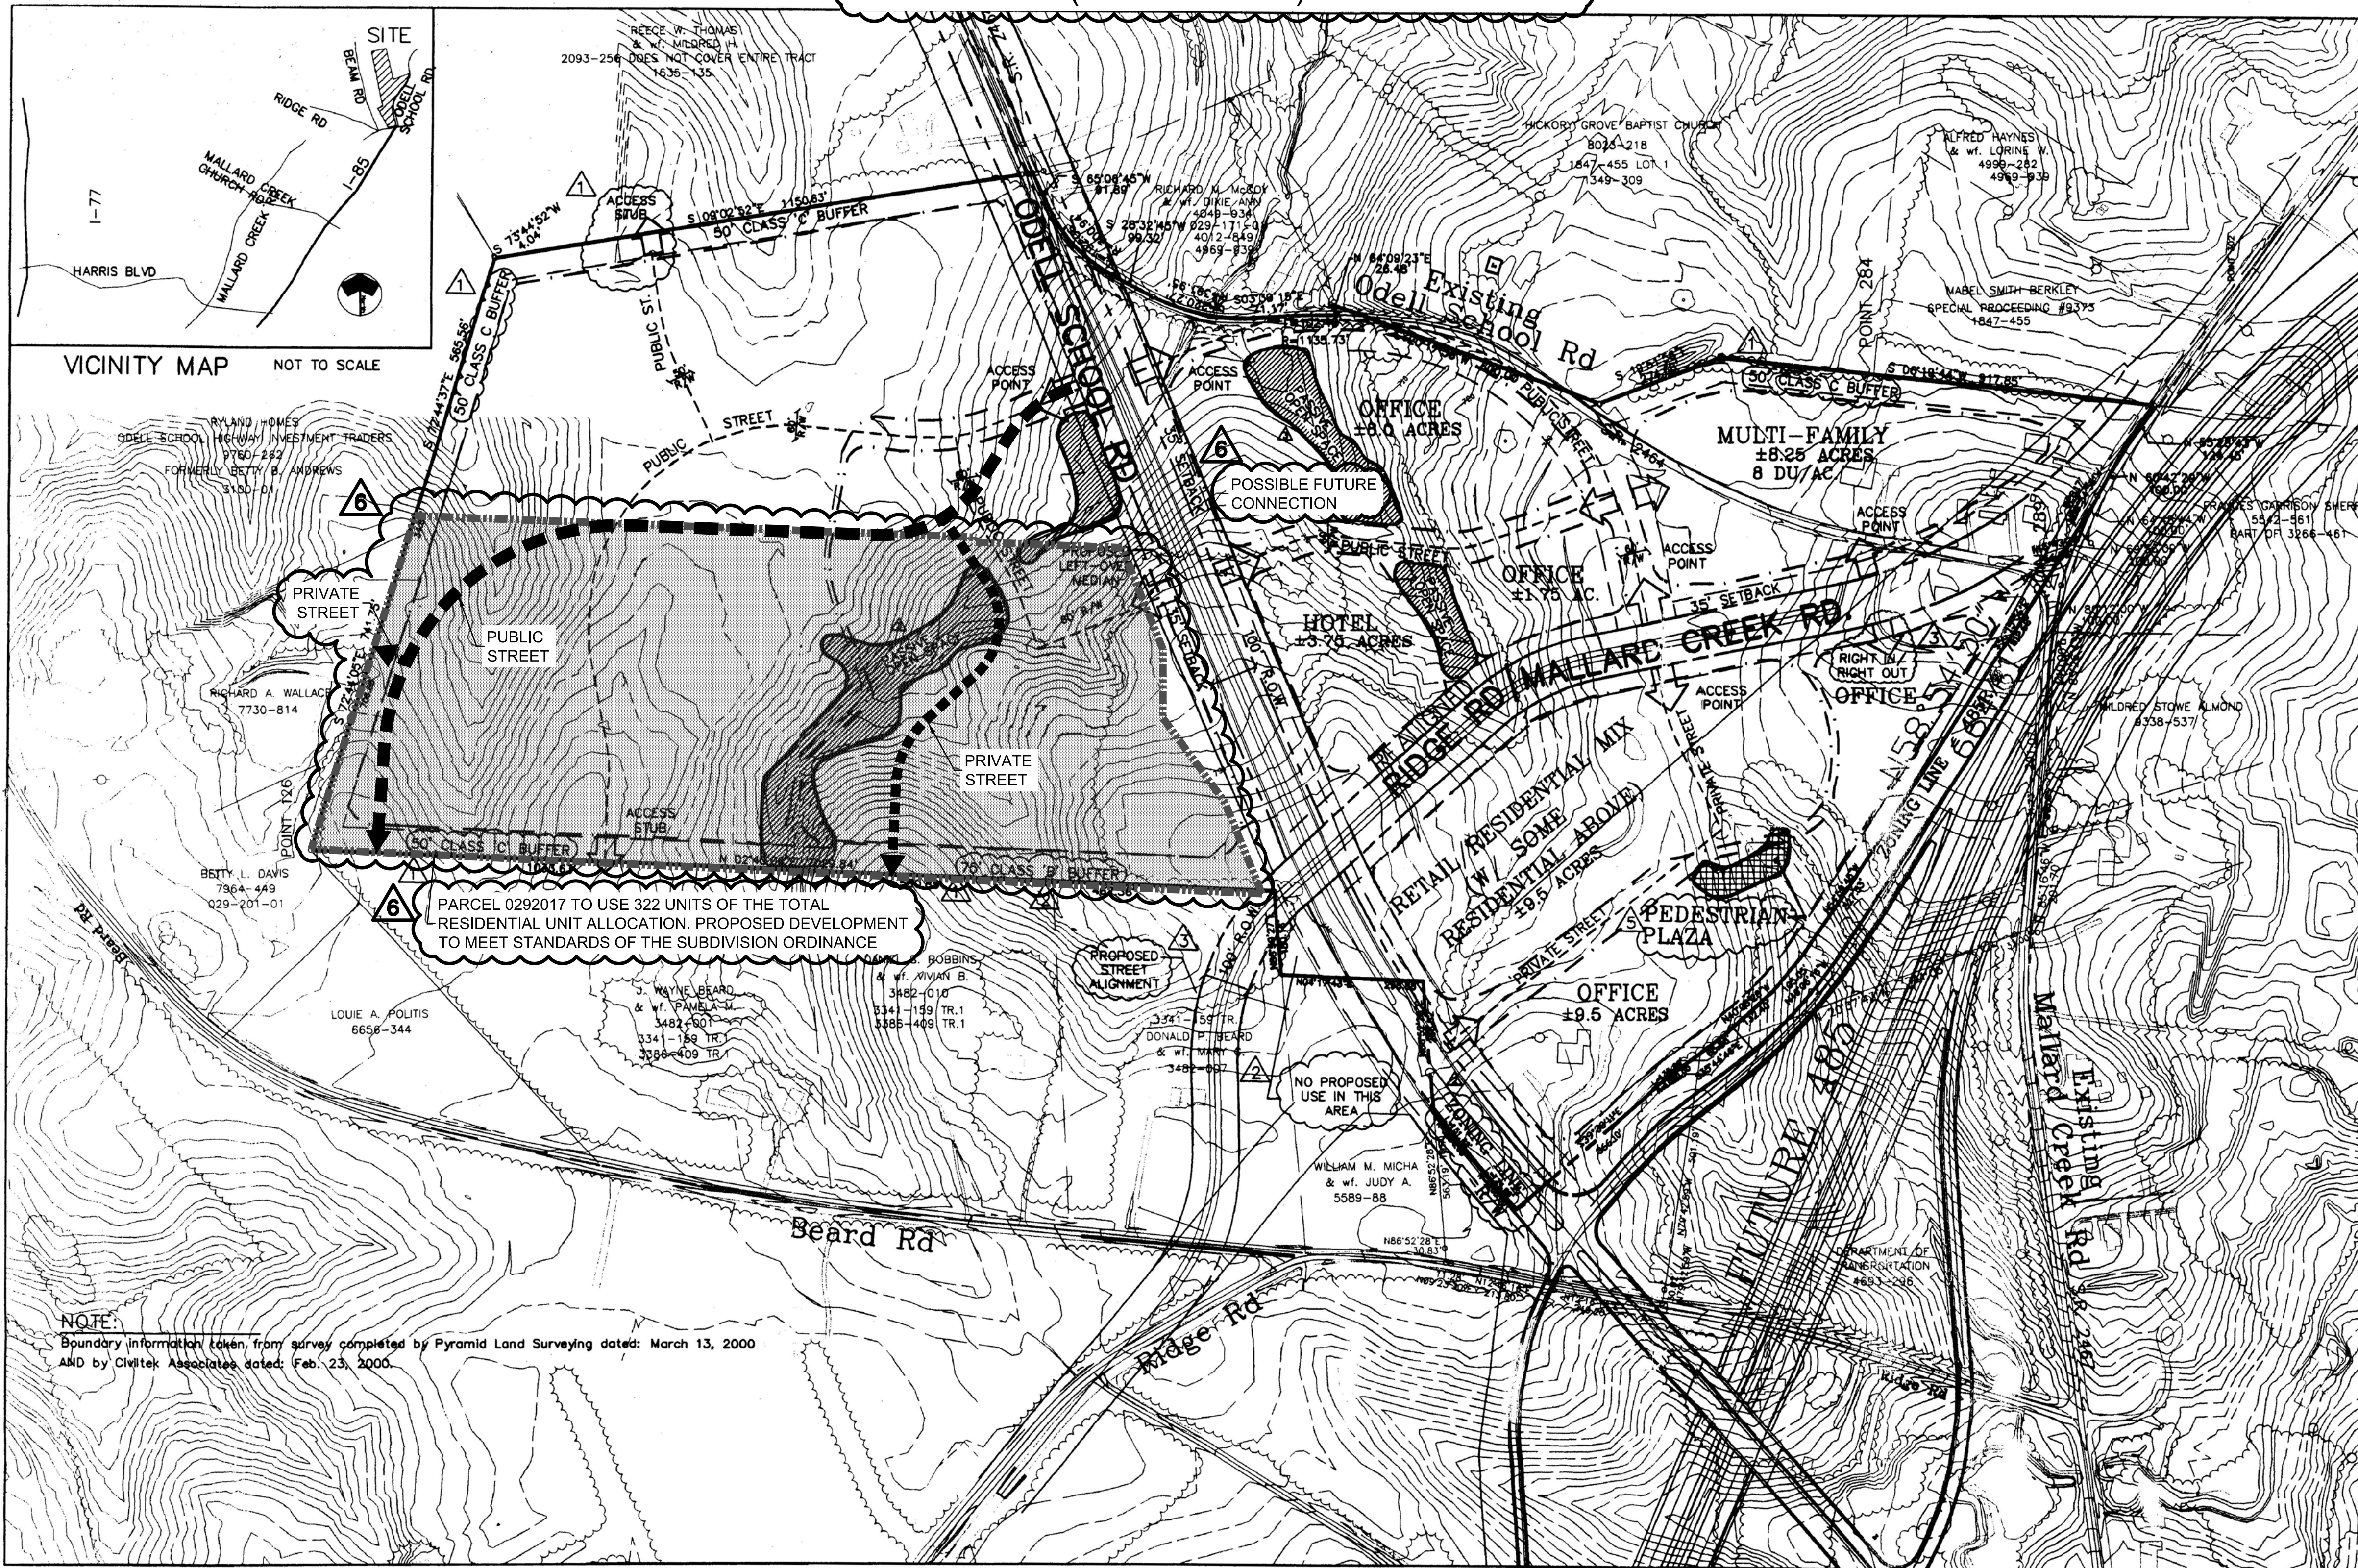

# TECHNICAL DATA SHEET

## PETITION # 00-132

### FOR PUBLIC HEARING

REVISION:  1/22/01       4/10/01       12/19/16  
 1/30/01       6/12/01  
 3/21/01      For

MICHAEL J. FOX & ASSOCIATES  
CHARLOTTE, NORTH CAROLINA

APPROVED BY CITY COUNCIL

DATE 6/18/01


Additional Notes per CDOT:

19. The exact location of driveways and street intersections will be determined during the development review process by NCDOT and/or CDOT which ever has jurisdiction over that determination.

20. Development Note 7 is modified in that only 380 multifamily units may be constructed utilizing existing Odell School Rd. and no office or retail development may be constructed until access to such sites may be provided from realigned Mallard Creek Rd. or realigned Odell School Rd. or portion of either of those roads

21. Building plans in the vicinity of the new intersection of Odell School Rd. and Mallard Creek Rd. will be arranged to allow for wider than standard rights of way and such building plans will be reviewed so as not to conflict with or impede the proposed widening project. This reservation is not intended to establish. These references an undisturbed standard for a total of 130' of asymmetrical right of way in the vicinity of the intersection with 70' from the centerline on each side which will be reserved for the widening project intersection. This reservation will be valid for a period of 10 years from the approval of this request, or until such earlier time as it may be determined by NCDOT or CDOT that right-of-way will not be needed.

Scale: 1" = 200'

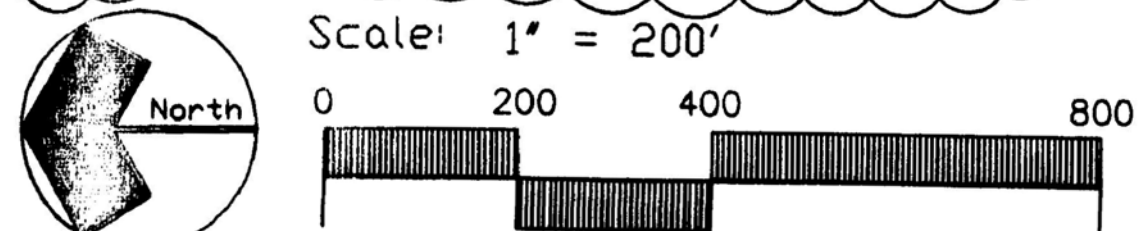

## Development Data:

**SITE AREA = ± 101 ACRES**  
**EXISTING ZONING = R3**  
**PROPOSED ZONING = CC**  
**PROPOSED USES =**  
**MIXED USE TOWN CENTER**  
**MAX. 100,000 s.f. RETAIL**  
**MAX. 600 DWELLING UNITS**  
**MAX. 350,000 s.f. OFFICE**  
**150 ROOM HOTEL**

\* **RAPID TRANSIT ALLOWANCE:**

**ADDITIONAL 150 DWELLING UNITS**  
**ADDITIONAL 87,500 s.f. OFFICE**  
**\* SEE NOTE #10**

### Development Notes:

1. Development of the site will be controlled by the standards depicted on this site plan and by the standards of the City of Charlotte Zoning Ordinance. The development depicted on this plan is intended to reflect the general arrangement of proposed uses on the site, but the exact details of lot configuration, placement and size of individual buildings and other structures within the limits prescribed by the ordinance as specified in Section 6.20A(2)(d) during the design and construction phases. This Proposal is intended to enable the development of a mixed-use community composed of office, multifamily, and neighborhood retail and service uses.
2. The site may be developed for any use allowed in the CC district as allowed by the ordinance in accordance with this site plan. That district and the restrictions of this site plan as noted below, except that no restaurant will be allowed to have drive through windows.
3. The Petitioner will construct a mixed use development in general conformity with the schematic plan which includes additional underground and pedestrian features with a special emphasis on the intersection of Mallard Creek Rd. and Odell School Rd. The site may also be accomplished through the use of reduced setbacks and arrangement of buildings at the intersection to focus attention at the center of the site. Further, the Petitioner will provide pedestrian connections from within the site to other site entrances and use of public transit facilities. The site may be accessed from all directions of access. The Petitioner may place retail uses within office buildings on the site as well as within the retail center in order to further the mixed-use nature of the site. Retail floor area located within office buildings shall not be more than 10% of the total floor area located elsewhere on the site. Any such retail space will be limited to 75% of the square foot area of the building and may only be located in multi-story buildings of at least 20,000 square feet of total floor area.
4. Residential densities may vary in different portions of the site in keeping with the various dwelling types. Residential uses may be located within any portion of the site including retail and office areas ~~uses within the site and office areas~~. Uses within the retail portion of the site may include a neighborhood-oriented retail use such as a supermarket, dry cleaners, personal services, etc. and there will be no direct access to any out parcel to the adjoining public streets. The uses that are permitted for the site and the public streets are designed to be integrated into the surrounding landscape; signage, and architectural style. The site may contain other small groupings of buildings that must have more than one use or type of use within the structure. These uses will not be considered as separate for the site and the public streets. The site may be used for other purposes as designated on the site plan for office or residential uses. Parking areas to serve uses on the site will be sited generally toward the center of development sites so that buildings may appear primarily to be street-fronted. On street parking on internal streets may be utilized to reduce the size of off street parking facilities.
5. Notwithstanding the allowances noted above, the Petitioner reserves the right to substitute residential uses for any part of the site as long as the designated area is in the southeast quadrant of the Mallard Creek Rd./Odell School Rd. intersection, generally referred to as the "retail corner".
6. Access to the site will be provided by connections to the new Mallard Creek Rd. and by connections to both existing and the new Odell School Rd. as shown on the Technical Data Sheet. All driveway and street connections are subject to approval by NCDOT, Mecklenburg County and/or CDOT depending on the location. Until new roadways are constructed, access will be provided to the existing alignments of Mallard Creek Rd., Odell School Rd. and Ridge Rd.
7. Buffer areas will be developed in accordance with Section 6.20.2. Required buffers on the site may be eliminated if the adjoining parcels are rezoned such that buffers are no longer required.
8. Stormwater detention facilities will be designed to meet the applicable standards of Charlotte/Mecklenburg Stormwater Service.
9. The Petitioner will dedicate 10% of right-of-way for the new alignments of Mallard Creek Rd. and for the portion of Odell Rd. that falls within the site as well as providing a connection with a public/private right-of-way for the construction of any or all of these roads. The Petitioner will also dedicate additional right-of-way for any portions of any existing public streets that may remain within or adjoin the site as may be necessary for the site to be developed under the new alignments. The Petitioner reserves the right to seek the abandonment of existing public streets that may fall within the site if those streets are not needed for the development of the site.
10. The Petitioner will construct a portion of Mallard Creek Rd. and Odell School Rd. which falls on the site to a cross section as shown in the plan. The development in connection with a public/private construction to be accomplished in phases as the site develops. The Petitioner's obligation for any such construction will be determined in concert with the Traffic Impact Study submitted as part of this petition. The Petitioner will not be permitted to prohibit a private developer for the construction of any or all of these roads, or will not be permitted to prohibit a private developer from the construction of any or all of these roads, and under such circumstances, the actual construction of the roads may be accomplished by an entity other than the Petitioner. Development of any portion of the site will either use existing public streets or will require the construction of new streets as constructed. Construction of residential uses on the portion of the site between Odell School Rd. and Mallard Creek Rd. is the general goal of this petition. All other development may only commence after contracts have been let for the construction of the portion of the new Odell School Rd. and Mallard Creek Rd. that will provide access to the site. The Petitioner will not receive a Certificate of Occupancy until that portion of the new road is completed and open to traffic.
11. If NCDOT modifies the design of the I-485/Mallard Creek Rd. interchange from a suburban diamond to an urban diamond or other similar, more compact interchange plan, the Petitioner reserves the right to modify the design of the affected portions of the site and, after the appropriate rezoning process, incorporate such areas and appropriate additional development rights into the site administratively.
12. Development on the site may utilize public, private, or a combination of public and private streets within the site. Subsequent to public or private streets within the site may be reduced in accordance with the provisions of the CC district. Development along the portions of existing Odell School Rd. that will remain will observe the standard CC district setback when property across Odell School Rd. is not within the boundaries of this site plan.
13. At the time that this Petition is being considered (January 2001), the Charlotte Area Transit System includes this site. Preliminary studies indicate that there is a high probability that a BRT will pass through the site, suggesting a change in the role of this site to one that should provide for and support rapid transit service at least some time as a rapid transit route is established and at such time that the Charlotte Area Transit Service is established. All of the transit service that is provided to the area of residential units and office floor area may be administratively increased by 25% without the need for transit service and is consistent with the Policy. This additional allowance is in recognition of the availability of transit service and the potential for transit service to be provided to the area of transit service and transit corridors. Further, the Petitioner will coordinate with CATS on the location of transit stop or station location on the site and will not be allowed to exceed any such use for a transit stop or station. The exact location of that site will be agreed to by the Petitioner and the CATS, and the location of that site will be in force until the earlier of the expiration of 5 years from the approval of the rezoning of the site or such time as CATS may determine and notify the Petitioner that such a site is not needed within the area covered by this site plan.
14. Any detached lighting on the multifamily and office portions of the site will be limited to 20 feet in height.

12. Signage will be permitted in accordance with applicable Zoning standards for the type of use for which the signage is proposed. Signage for multifamily use will be that which is allowed in multifamily districts and signage for office uses will be that which is allowed in office districts. Signage for retail uses will be that which is allowed in the UC district, except that detached signs identifying individual sites will be limited to ground mounted signs no more than 50 square feet in area and 4 feet in height.
13. Parking will be provided which will meet or exceed the standards of the Zoning ordinance.
14. Screening will conform to the applicable standards of Sect. 12.303 of the Zoning ordinance.
15. All dumpsters on the site will be screened with a solid enclosure with gates
16. Buildings within the retail portion of the site will be one to three stories in height and buildings within the office portion of the site will range from one to five stories in height. Residential uses may be incorporated within both retail and/or office buildings.
17. Pedestrian walks and paths will be installed within the site as the various components develop to create a network of both public sidewalks and other pedestrian linkages between the site components.
18. Pedestrian lighting will be installed throughout the various components of the site as they develop along public sidewalks and other pedestrian ways within the site.
19. Open space elements will be included within the various components of the site consistent with the uses in that area. Open squares or plazas will be included within the retail and office areas and both passive and active elements will be included within the residential areas.

**DPR**  
DESIGN • PLANNING • RESEARCH

DPR ASSOCIATES, INC.  
Landscape Architects  
Planners & Engineers  
420 Hawthorne Lane  
Charlotte, NC 28204  
704/332-1204

Sheet Number.

# RZ-1