


BLM  
BUREAU OF LAND MANAGEMENT  
U.S. DEPARTMENT OF THE INTERIOR



		DATE
PROJECT:	18016	04/23/2018
ISSUE:	REZONING-1	04/23/2018
	BORING	05/09/2018
	-	-
	-	-
	-	-
REVISIONS:	REV-1	07/09/2018
	-	-
	-	-
DRAWN BY:	JMH, DMA	
CHECKED BY:	PRM	
CONTENT:	CONCEPTUAL SITE PLAN	

## LS1.1

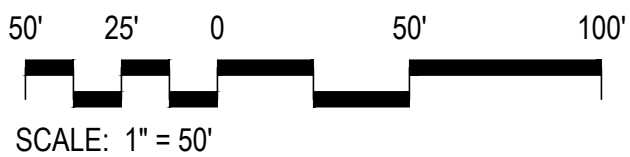

7/10/2018 2:45 PM P:\18016\18016\_Lancaster\_Hwy\_2\_Townhouse\4c\_LAND\Map-LP\18016-SP-05-rev.dwg

<p>PETITION NO. 2018-<del>xxx</del><b>001C</b></p> <p>DEVELOPMENT STANDARDS</p> <p>Northwood Ravin Development</p> <p>47/229/18</p> <p><u>Site Development Data:</u></p> <p>Acreage: ±12 acres Tax Parcels: 22345184 and 22345183 Existing Zoning: R-3 Proposed Zoning: UR-2(CD) Existing Uses: Large Lot Residential Proposed Uses: Up to 145 <del>110</del> Single-Multi Family Attached (Townhome) Units Max. Building Height: Fifty (50) feet, <u>with the exception of units fronting Southerest Lane, which shall be a maximum of forty (40) feet</u></p> <p><b>1. General Provisions</b></p> <p>These Development Standards form part of the Rezoning Plan associated with the Rezoning Petition filed by Northwood Ravin Development (the "Petitioner") to accommodate the development of a residential townhome community on that approximately 12 acre site located at 14624 and unnumbered parcel on Lancaster Highway in unincorporated Mecklenburg County, which is more particularly depicted on the Rezoning Plan (the "Site"). The Site is comprised of Tax Parcel Numbers 22345184 and 22345183.</p> <p>Development of the Site shall be governed by the Rezoning Plan, these Development Standards and the applicable provisions of the <del>City of Charlotte</del>Mecklenburg County Zoning Ordinance (the "Ordinance"). Unless the Rezoning Plan or these Development Standards establish more stringent standards, the regulations established under the Ordinance for the UR-2 Zoning District shall govern all development taking place on the Site.</p> <p><del>Inasmuch as planning for the proposed redevelopment of the Site has not yet advanced beyond the formative stage, the ultimate layouts of the development proposed, the exact alignments of streets and points of access, the configurations and placements of parking areas and the heights and masses of buildings have not yet been determined. As a consequence, the configurations, placements and sizes of the buildings and parking areas depicted on the Rezoning Plan are schematic in nature and therefore are subject to refinements as part of the total design process. They may, therefore, be altered or modified within the limits prescribed by the Ordinance during the design development and construction phases as allowed under the provisions of Section 6.207 of the Ordinance, during design development and construction document phases so long as the maximum parking and building envelope lines established on the Rezoning Plan are not violated and the proposed alterations or modifications do not exceed the parameters established under these Development Standards and under the Ordinance for the UR-2 District.</del></p> <p>301792658 v2</p>	<p><b>2. Permitted Uses and Maximum Development</b></p> <p>The Site may be developed with up to 11045 <del>single</del>multi-family attached dwelling units (townhomes), together with any incidental and accessory uses related thereto that are allowed in the UR-2 zoning district. While the total number of townhome lots shall not exceed 11045 units, the Petitioner may convert townhome unit lots into single family detached lots.</p> <p><b>3. Transportation</b></p> <p>a) Vehicular access will be as generally depicted on the Rezoning Plan. The placement and configuration of the vehicular access point shown on the Rezoning Plan is subject to any minor modifications required to accommodate final site and construction plans and designs and to any adjustments required by NCDOT for approval.</p> <p>b) As depicted on the Rezoning Plan, the Site will be served by public and/or private streets.</p> <p>c) Internal sidewalks and pedestrian connections shall be provided along <u>at least one side of all public and private streets throughout the Site. The internal sidewalks may meander to save existing trees or to provide for utilities. Internal sidewalks shall be a minimum of five (5) feet wide.</u></p> <p><del>e)d) The Petitioner shall install a six (6) foot sidewalk and eight (8) foot planting strip along the Site's frontages of Southerest Lane and Lancaster Highway, as generally depicted on the Rezoning Plan.</del></p> <p><del>e)e) Where necessary, Petitioner shall dedicate and convey in fee simple all rights-of-way to Mecklenburg County before the Site's last building certificate of occupancy is issued or phased per the Site's development plan. The right-of-way shall be set at two (2) feet behind the back of sidewalk where feasible.</del></p> <p><b>4. Architectural Standards</b></p> <p>a) The principal buildings used for residential uses constructed on the Site may use a variety of building materials. The building materials used for buildings will be a combination of the following: glass, brick, stone, simulated stone, pre-cast stone, pre-cast concrete, synthetic stone, stucco, cementitious siding (such as Hardi-plank), vinyl, EIFS or wood.</p> <p><u>1. Vinyl as a building material shall only be used on windows, soffits and on handrails/railings.</u></p> <p>b) Buildings fronting Southerest Lane shall be a maximum of forty (40) feet, or 2.5 stories, and shall not contain more than five (5) units per building.</p> <p>c) <u>To provide privacy, all residential entrances within fifteen (15) feet of the sidewalk shall be raised from the average sidewalk grade a minimum of twenty-four (24) inches.</u></p> <p>301792658 v2</p>	<p><u>d) Pitched roofs, if provided, shall be symmetrically sloped no less than 5:12, except that roofs for porches and attached sheds, if provided, may be no less than 2:12.</u></p> <p><del>e) Petitioner shall provide blank wall provisions that limit the maximum blank wall expanse to 15 feet on all building levels, including but not limited to doors, windows, awnings, change of materials, articulation, change of plane, and/or architectural design elements.</del></p> <p><del>f) All corner/end units that face a public or private street shall have a porch or stoop that wraps a portion of the front and side of the unit or provide blank wall provisions that limit the maximum blank wall expanse to fifteen (15) feet on all building levels.</del></p> <p><del>g) The Petitioner will minimize the visual impact of any garage doors visible from the public or private streets by providing a 12 inch setback from the front wall plane and adding additional architectural treatments such as translucent windows or projecting elements over the garage door opening.</del></p> <p><del>h) Driveways shall either be a minimum of seven (7) feet or at least twenty (20) feet from the proposed back of curb to the proposed face of garage.</del></p> <p><del>a)i) Each attached and detached single-family residential dwelling unit may be provided with a two-car garage.</del></p> <p><del>b) Walkways of a minimum width of five (5) feet will be provided to connect all residential entrances to sidewalks along public and private streets, as generally depicted on the Rezoning Plan.</del></p> <p><del>e)j) Townhouse buildings will be meaningfully differentiated between units, including, but not limited to, forward offsets in the front walls of units, vertical height differences, or architectural differences in elevations (such as windows, doors, bays, trim, or materials).</del></p> <p><b>5. Screening, Landscaping, Amenity Areas, and Lighting</b></p> <p>a) <u>The Petitioner shall provide a minimum 37.5 foot Class C buff and a minimum four (4) foot tall fence along the southern and western boundaries of the Site, as generally depicted on the Rezoning Plan. This proposed fence may be located within one (1) foot of the property line.</u></p> <p><del>b) The Petitioner shall provide landscaping, screening, and/or decorative fencing along the Site's frontage of Lancaster Highway, as generally depicted on in the Rezoning Plan.</del></p> <p>301792658 v2</p>	<p><del>c) The Petitioner shall provide a private amenity area on the Site in the area generally depicted on the Rezoning Plan, which may include, but shall not be limited to, a clubhouse, pool, playground, dog park, fenced garden and/or picnic area.</del></p> <p><del>d) Pedestrian scale lighting will be provided within the Site along public and private streets. The maximum height of any pedestrian scale, freestanding lighting fixture, including its base, shall not exceed twenty one (21) feet.</del></p> <p><b>6. Amendments to Rezoning Plan</b></p> <p>a) Future amendments to the Technical Data Sheet or these Development Standards may be applied for by the then Owner or Owners of the parcel or parcels within the Site involved in accordance with the provisions of Chapter 6 of the Ordinance.</p> <p>b) Further alterations or modifications to the Approved Plan for the proposed development which, in the opinion of the Planning Director, substantially alter the character of the development or significantly alter the approved Technical Data Sheet for the development or any of its conditions or which increase the intensity of development shall not be deemed to be minor and may only be made in accordance with the provisions of Subsections 6.207(1) or (2) of the Ordinance, as applicable.</p> <p><b>7. Binding Effect of the Rezoning Documents and Definitions</b></p> <p>a) If this Site Plan Amendment is approved, all conditions applicable to development of the Site imposed under the Technical Data Sheet will, unless amended in the manner provided under the Ordinance, be binding upon and inure to the benefit of the Petitioner and the current and subsequent owners of the Site and their respective successors in interest and assigns.</p> <p>b) Throughout these Development Standards, the terms, "Petitioner" and "owner" and "owners" shall be deemed to include the heirs, devisees, personal representatives, successors in interest and assigns of the Petitioner or the owners of the Site from time to time who may be involved in any future development thereof.</p> <p>301792658 v2</p>
---	--	--	---

DEVELOPMENT STANDARDS

		DATE
PROJECT:	18016	04.23.2018
	ISSUE:	REZONING-1 04.23.2018
REVIEWS:	BORING	05.09.2018
	.	.
	.	.
	.	.
	REV-1	07.09.2018
	.	.
DRAWN BY:	JMH, DMA	
	CHECKED BY:	PRM
	CONTENT:	DEVELOPMENT STANDARDS
	.	
	.	
	.	

PRELIMINARY

FOR REVIEW ONLY  
NOT FOR  
CONSTRUCTION

NORTHWOOD RAVIN DEVELOPMENT  
14324 Lancaster Highway  
Mecklenburg County, North Carolina



JDAVIS

510 South Wilmington Street | Raleigh, NC 27601 | Tel: 919.835.1500  
1518 Walnut St, Suite 1308 | Philadelphia, PA 19102 | Tel: 215.545.0721

LS1.2

©2018 JDAVIS ARCHITECTS EXPRESSLY RESERVES ITS COMMON LAW COPYRIGHT AND OTHER PROPERTY RIGHTS IN THESE PLANS. THESE PLANS ARE NOT TO BE REPRODUCED, CHANGED OR COPIED IN ANY FORM OR MANNER WHATSOEVER, NOR ARE THEY TO BE ASSIGNED TO ANY THIRD PARTY WITHOUT FIRST OBTAINING THE EXPRESSED WRITTEN PERMISSION AND CONSENT OF JDAVIS ARCHITECTS, PLLC.