


REMOVED FUTURE AMENITY LOCATION
ADDED LOTS 239-241 WHERE AMENITY WAS ORIGINALLY LOCATED
REVISED SIZE OF LOTS 75-86, RELOCATED LOTS 218 AND 219
ADDED POCKET PARK BETWEEN LOTS 149 AND 150
TOTAL NUMBER OF LOTS INCREASED FROM 238 TO 241

- [illegible]

	PROPOSED LINE OF PAVEMENT	-/-
	PROPOSED S. SIDEWALK	8/11/1
	PROPOSED ACCESSIBLE RAMP	13/14/1
	PROPOSED STREET SIGN	9/10/1/1
	PROPOSED STOP SIGN	9/10/1/1
	2'-6" STD. CURB & GUTTER	-/-
	10' TRANSITION 2'-6" STD. TO 2'-0" VALET	-/-
	8' PEDESTRIAN PATH MAINTAINED BY MDC, COUNTY ORDINANCES	6/11/2
	8' PEDESTRIAN PATH MAINTAINED BY HOA	12/1/1,3

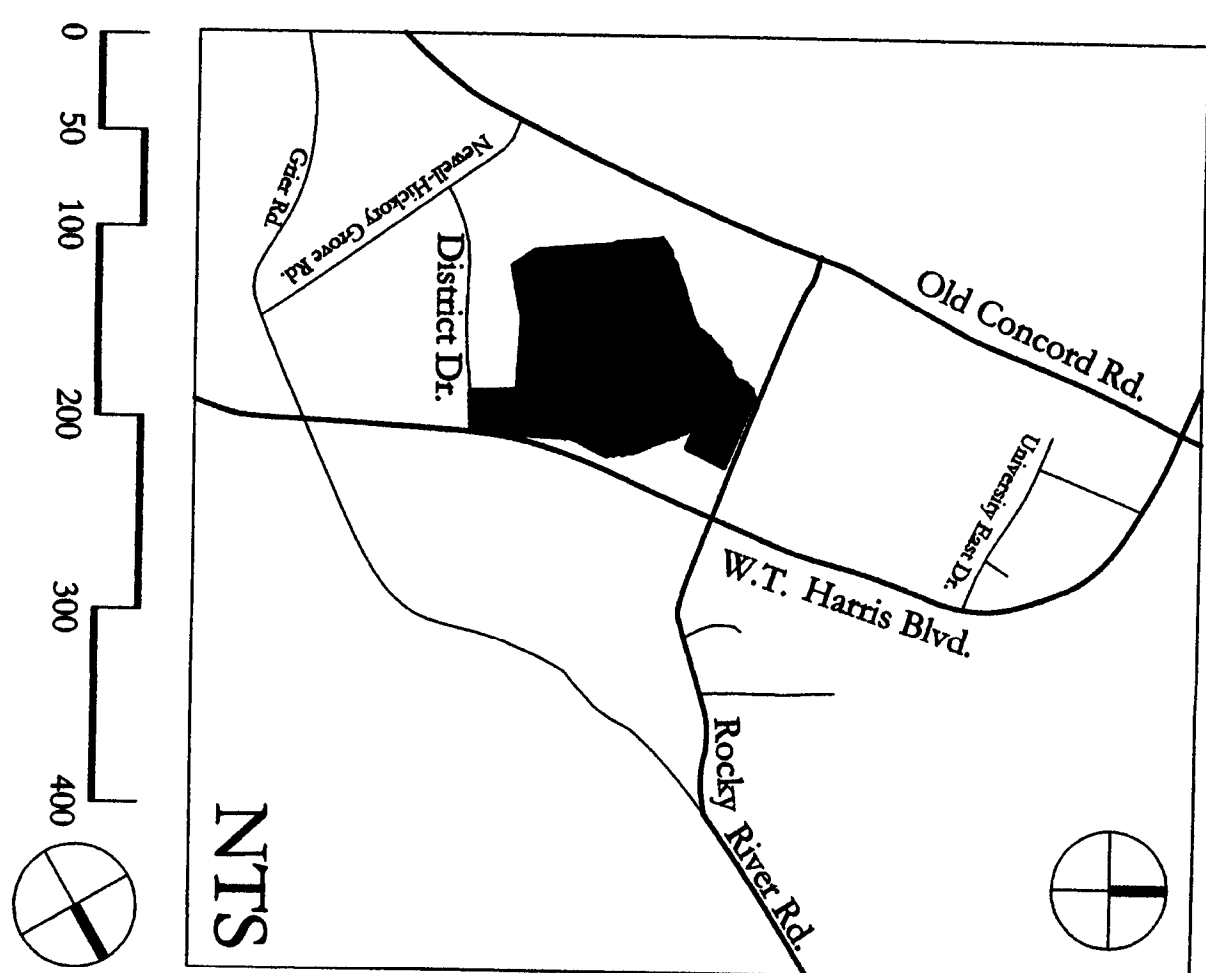

151119

TURNBULL

ETZLER DESIGN

P.A. IS PROH

ATED. 20

©

9335 HARRIS CORNERS PARKWAY
SUITE 100
CHARLOTTE, NC 28269

APPROVED FOR
CONSTRUCTION
CMPC
2-4-2011

**CITY OF CHARLOTTE
NORTH CAROLINA**

Site Plan

PROJECT NUMBER: 09-026	
DRAWN BY:	RLF
DESIGNED BY:	SRT
ISSUE DATE:	12/9/05

NO.	DATE	BY	REVISIONS
1	01/26/11	EEP	PER CITY REVIEW COMMENTS
2	11/27/10	EEP	PER CITY REVIEW COMMENTS
3	11/27/10	EEP	REVISIONS PER CLIENT COMMENTS
4	7/27/06	EEP	3rd REVIEW COMMENTS
5	6/28/06	AJF	2nd REVIEW COMMENTS
6	5/30/05	AJF	1st REVIEW COMMENTS