


LEGEND
● BOUNDARY CORNER
SIRON = SET IRON ROD
FIRON = FOUND IRON ROD
X28" OAK = TREE SHOT

I, DAVID E. GRIFFIN, certify that this plot was drawn under my supervision from an actual survey made under my supervision. The purpose of this survey was for as-built information only, no boundary survey was performed.
Witness my original signature this -- day of --, 2008 A.D.

DAVID E. GRIFFIN L-3858
REGISTRATION No.

PRELIMINARY PLAT
NOT FOR RECORDATION
CONVEYANCE OF SALES

WESTOVER HILLS PRESBYTERIAN
LOTS 6-8 OF MAP BOOK 5, PAGE 125
PARCEL ID: 11911405
DEED BOOK: 2308, PAGE 589
AREA = 1.593 ACRES

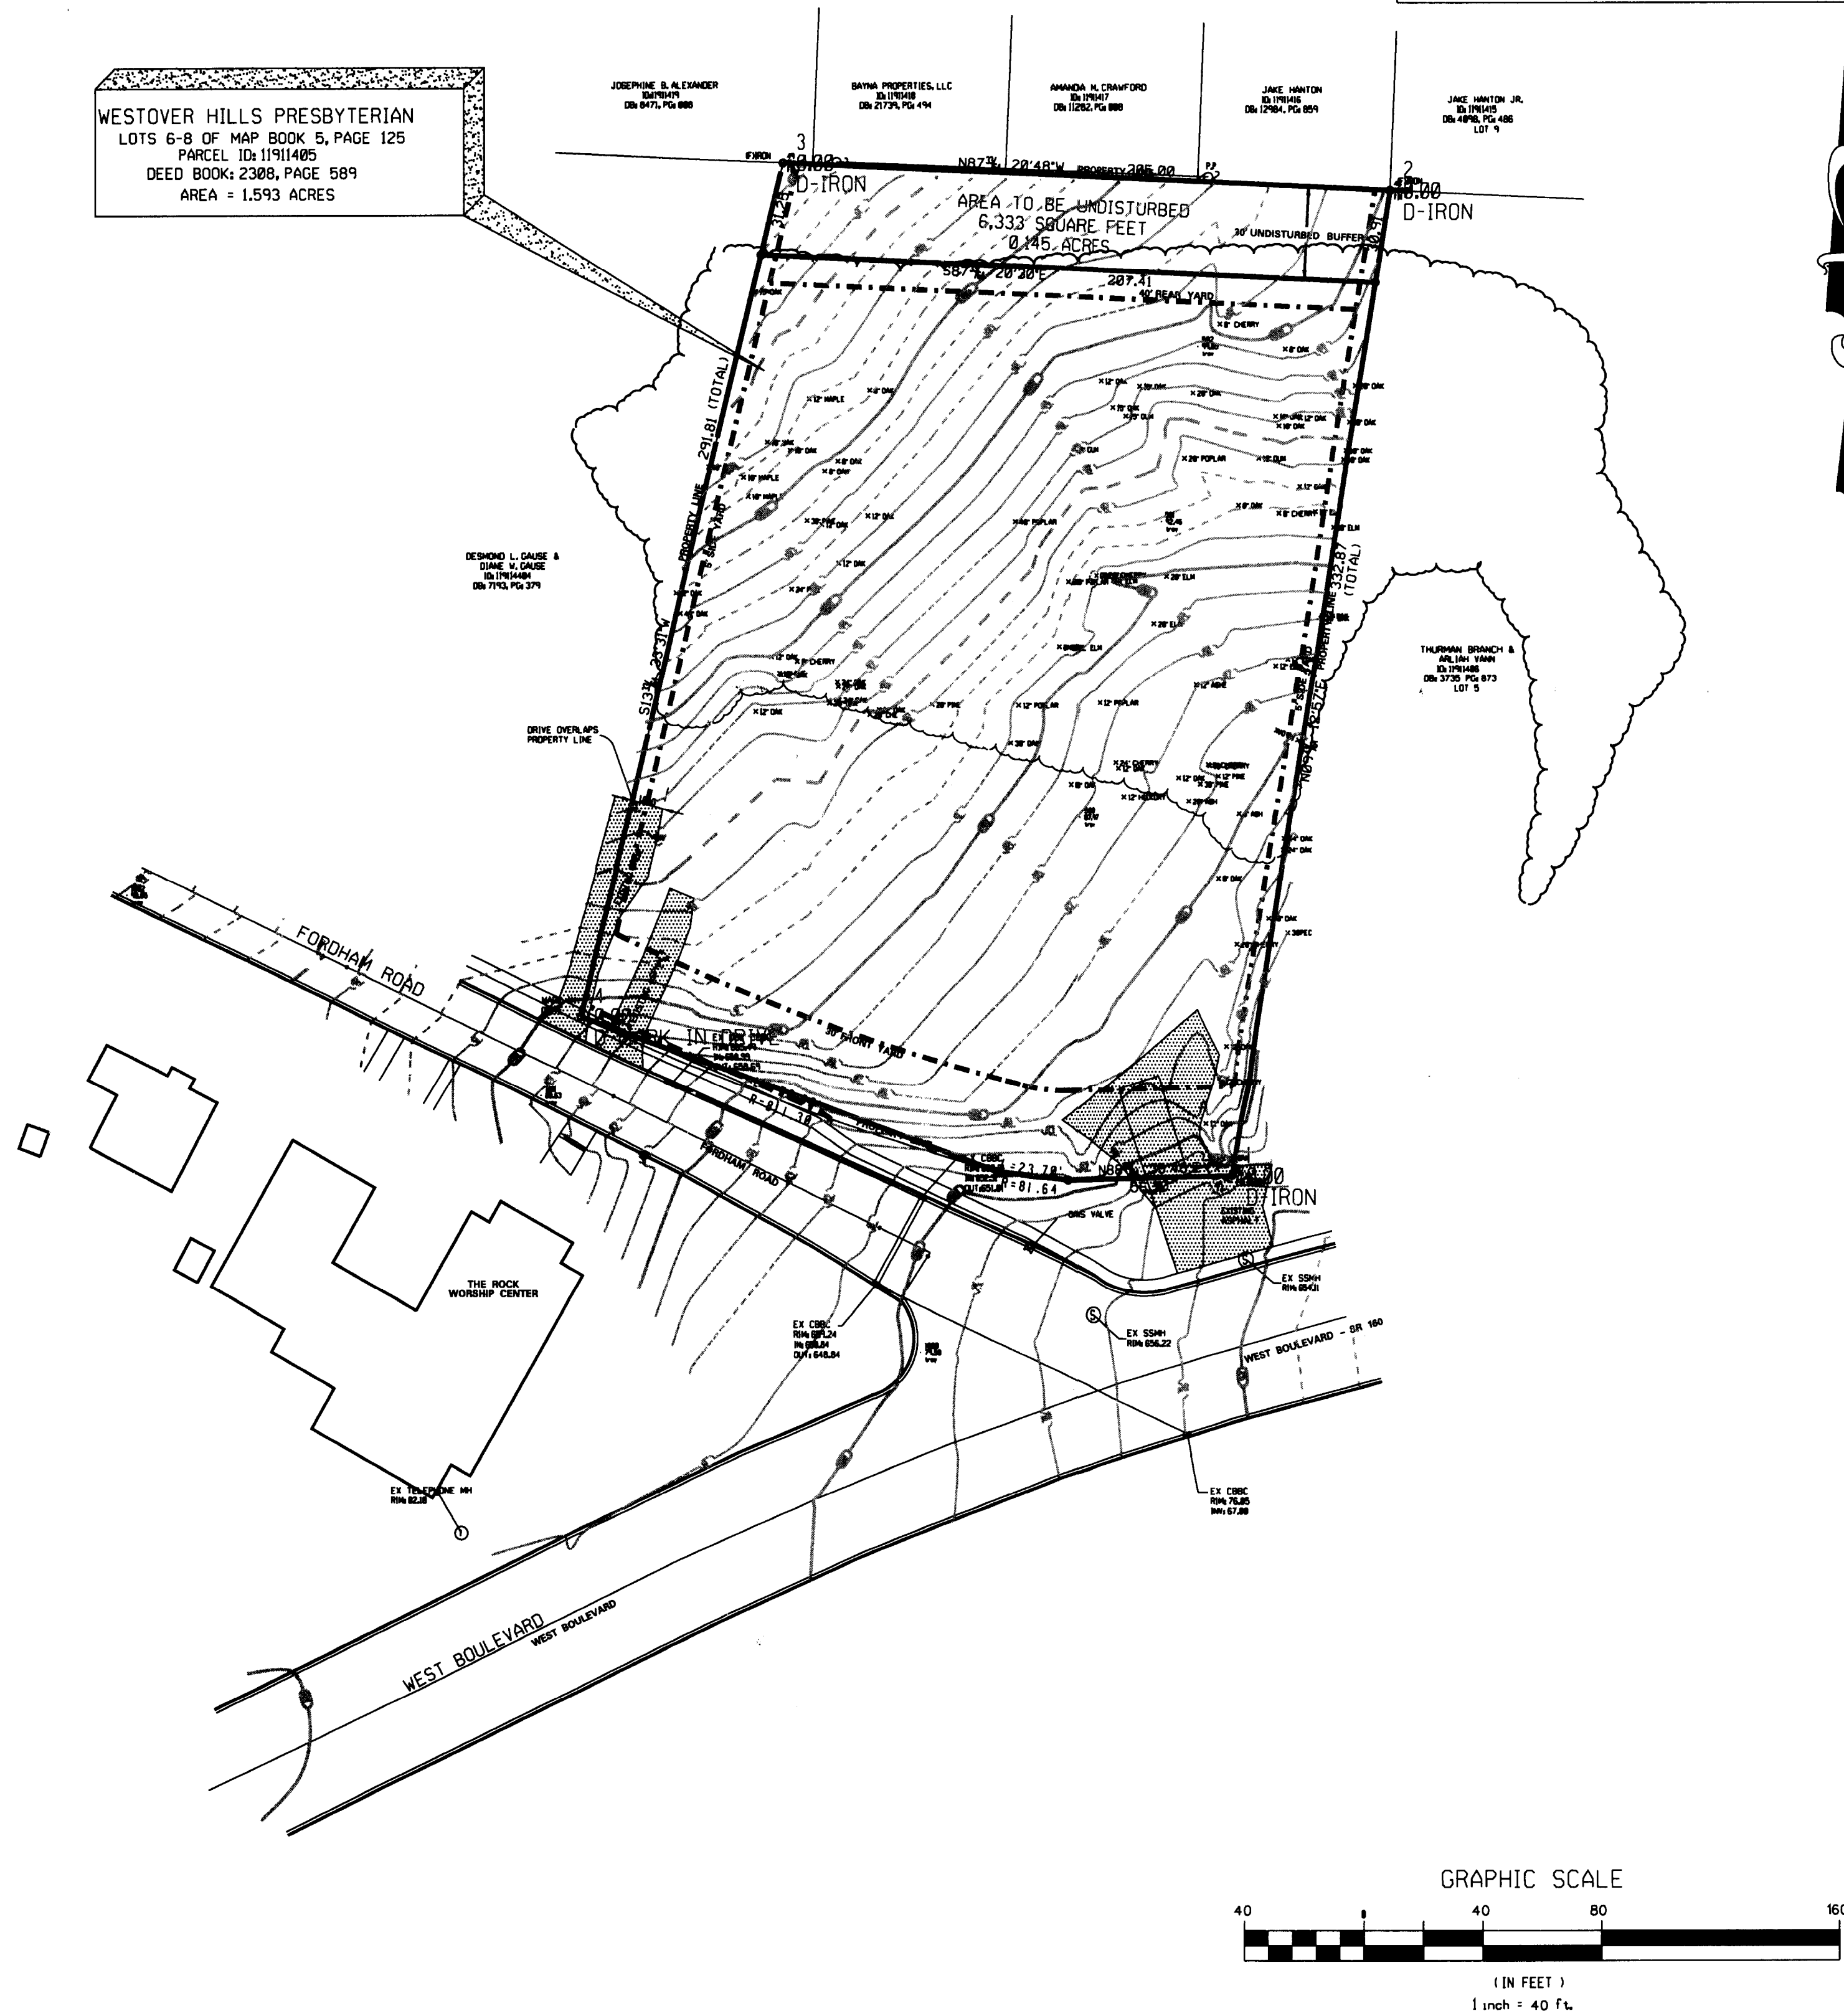

GRIFFIN SURVEYING SERVICES, PA

P.O. Box 98 Monroe, NC 28111-0098
QUALITY IS OUR PRIORITY

PH: (784) 753-5888 E-MAIL: DAVID@SSMACHES.NET FAX: (784) 753-9841

TOPOGRAPHICAL SURVEY:

PARCEL ID: 11911405

CITY TOWNSHIP MECKLENBURG COUNTY, NORTH CAROLINA
PREPARED FOR

WESTOVER HILLS PRESBYTERIAN
CHARLOTTE, NC

DRAWING NAME: 10-08 R38
SCALE: 1" = 40'
TAX ID: 11911405
SURVEYED BY: MC/WC
DRAWN BY: JW
CHECKED BY: DG
DATE: 10/28/08

JAN 28 2010

2010-032

FOR
REFERENCE
ONLY

THE ROCK WORSHIP CENTER
PARKING LOT ADDITION
FORDHAM ROAD & WEST BOULEVARD
CHARLOTTE, NORTH CAROLINA

PROJECT NO.:
COS REVIEW: 12-19-2008
REVISIONS:
DESIGNED BY:
P. LEO COOPER
REVIEWED BY:
HOLLIS ELLIS, P.E.

EXISTING
SURVEY
C0.0

GATC CONTRACTING
9635 Southern Pine Blvd, Ste. 108
Charlotte, NC 28273
(704) 771-1222 Phone, (704) 771-1223 Fax
www.gatcontracting.com
SolarGreen
DEVELOPMENT
410 Oakman Crescent, Ste. 201
Virginia Beach, VA 23062-4235
(757) 471-1070
(757) 471-1085 (Fax)
WWW.SOLARGREENCAE.COM
CAE, Inc.