ENTER-001

ETAIL No. 20

#### SITE DEVELOPMENT DATA

Site Acreage: Tax Parcels:

82.0 Ac.

199-241-03, 199-241-13, 199-241-15, 199-241-34, 199-241-44, 199-251-01

Proposed Zoning:

MUDD-O (LLW-PA); CC (LLW-PA); CC

(SPA) LLW-PA

**Existing Zoning:** CC (LLW-PA); CC SPA (LLW-PA); I-1

(CD) (LLW-PA - by Rezoning Petition No. 2010-11); and R-3 (LLW-PA)

Existing Uses: Proposed Uses:

Vacant and two single family homes Uses permitted by right and under prescribed conditions together with accessory uses, as allowed in the CC

and MUDD zoning districts.

Maximum Gross Development: Up to 525,000 square feet of gross floor area and a hotel with up to 120 rooms

(see Development Standards for detail)

Maximum Building Height:

As allowed by the Ordinance in the area zoned CC. In the area Zoned MUDD-O building height will be limited to 50 feet except for certain architectural features such as towers, gallery roofs and similar structures which may be up to 65 feet in height. Height to be measured as defined

by the Ordinance.

Parking:

As required by the Ordinance for the portion of the Site zoned CC and a minimum of one space per 250 gross s.f. of building area for the portion of the Site

zoned MUDD-O

Open Space:

A minimum of 15% of the Site will be established as open space as defined by

2

the Ordinance.







PUBLIC STREET

**BUILDING EDGE** 

LOW WALL/ LANDSCAPE EDGE

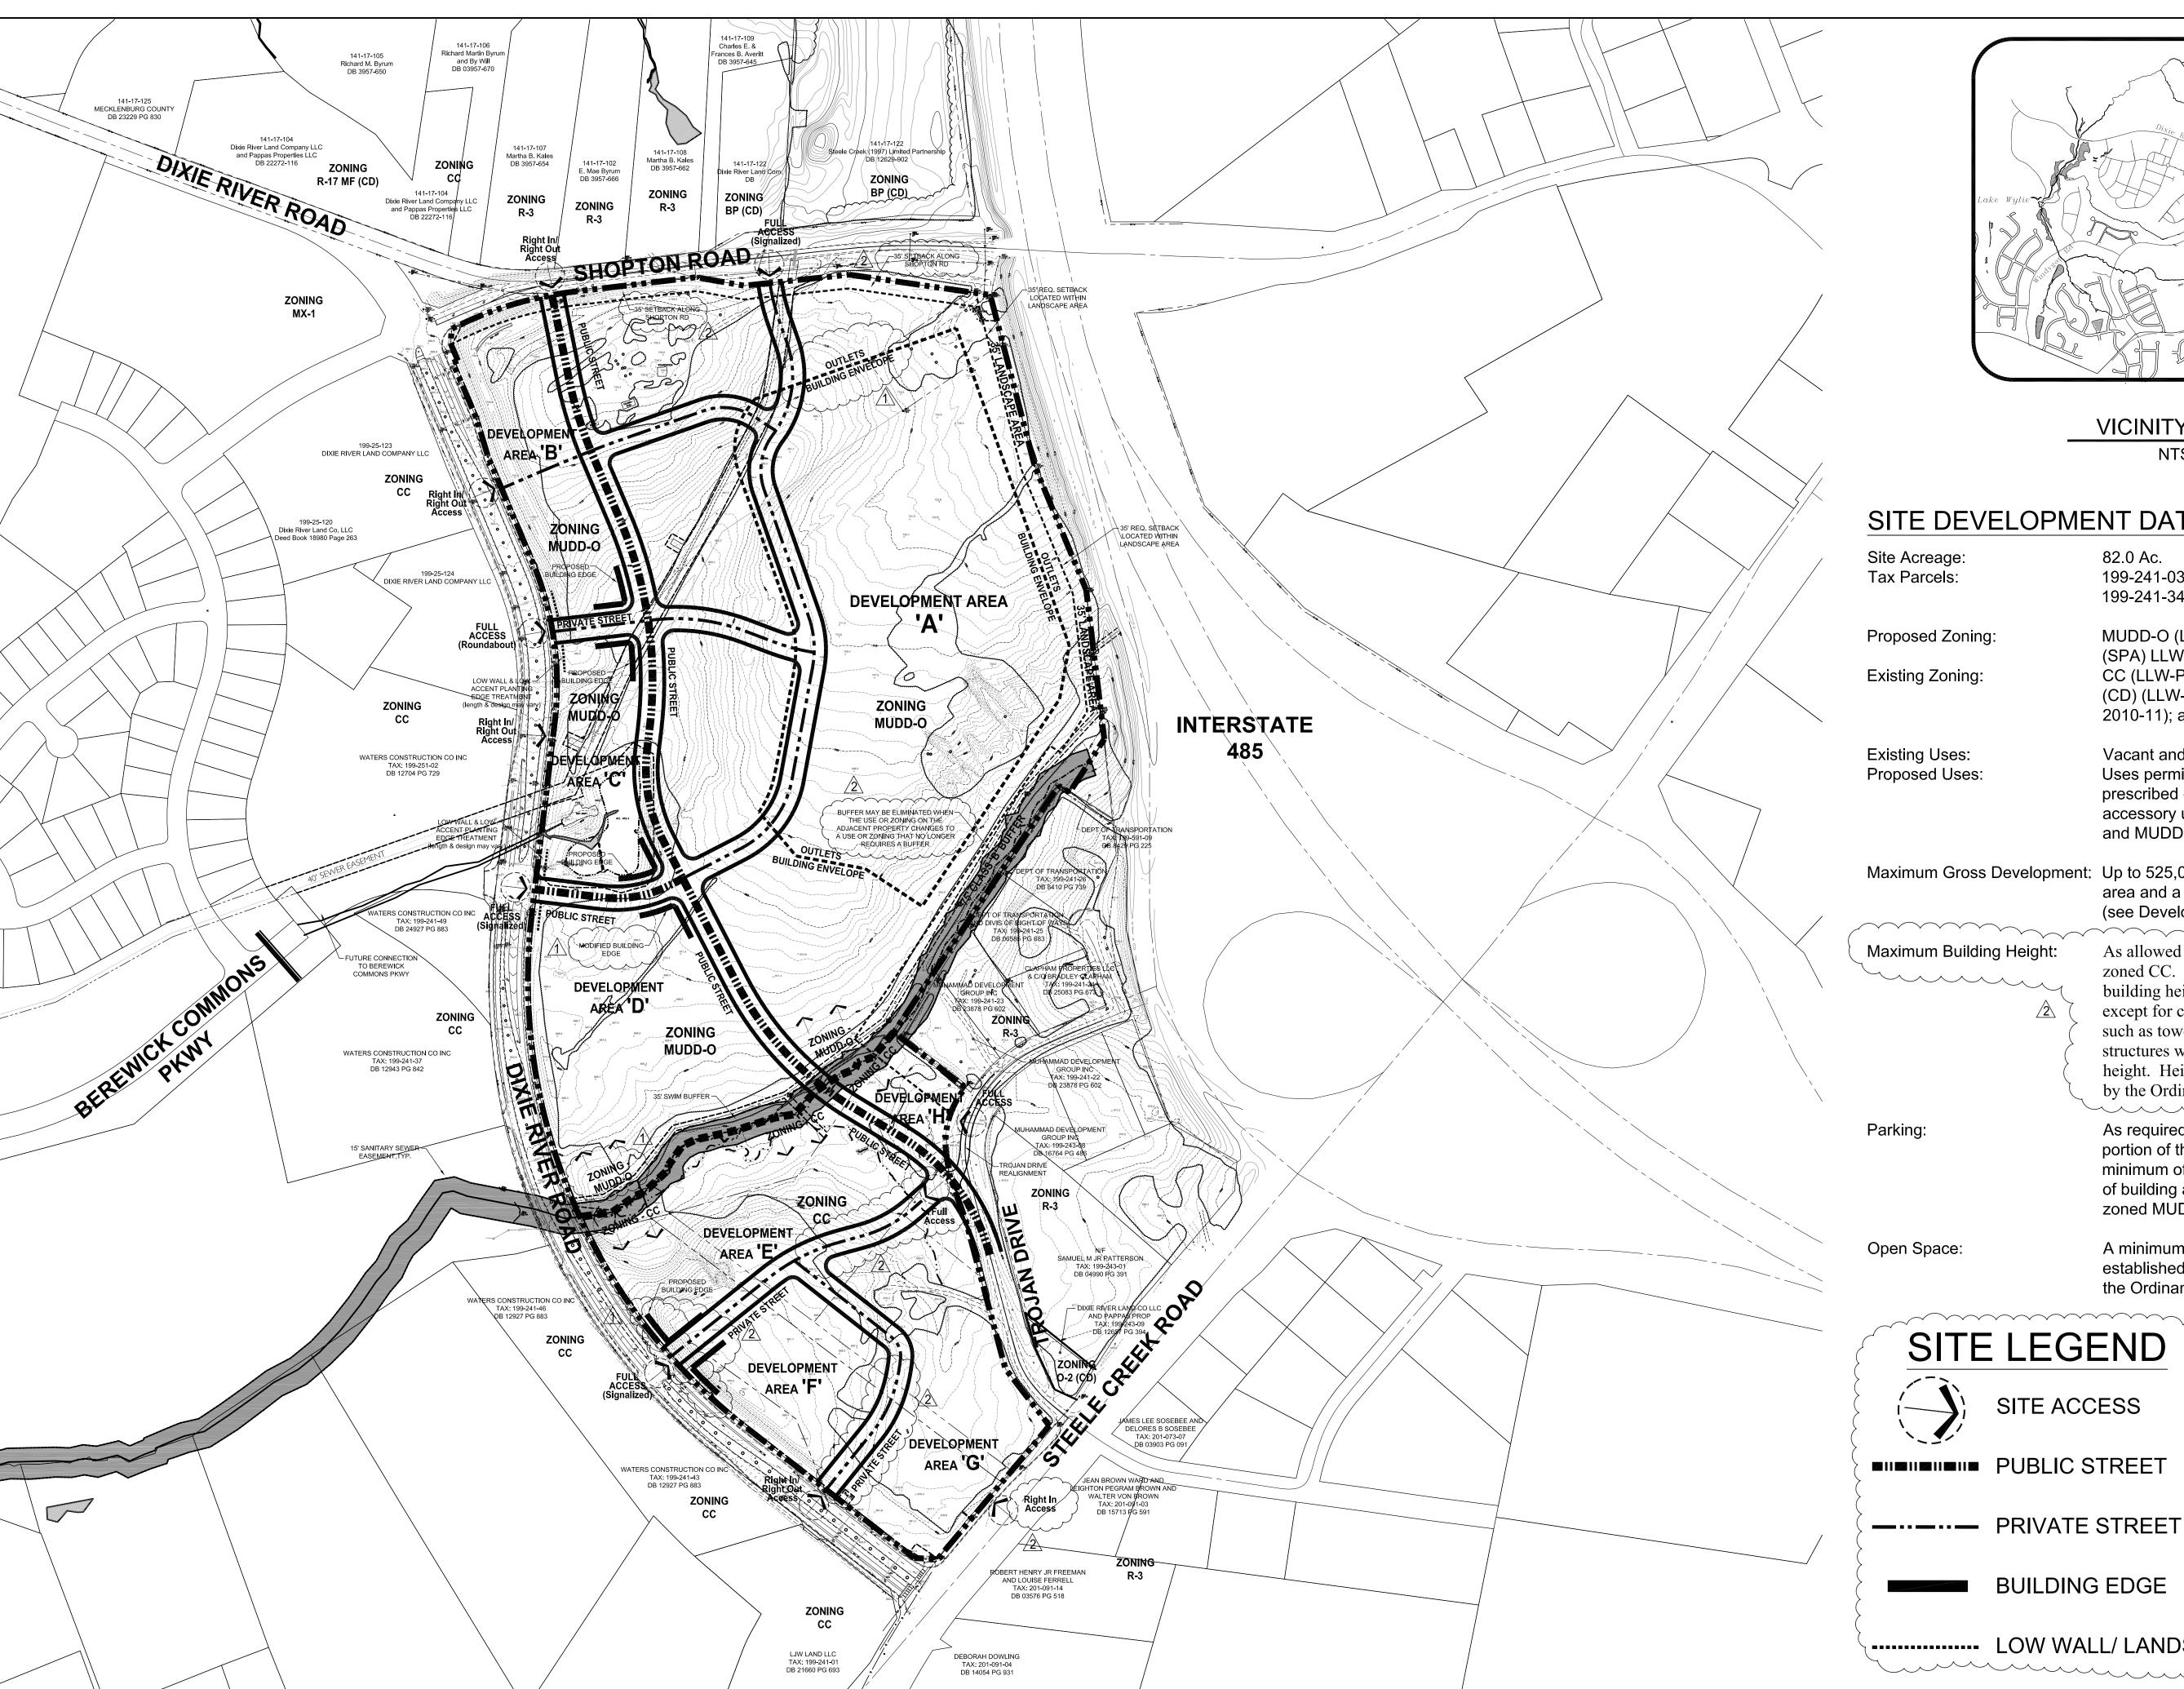

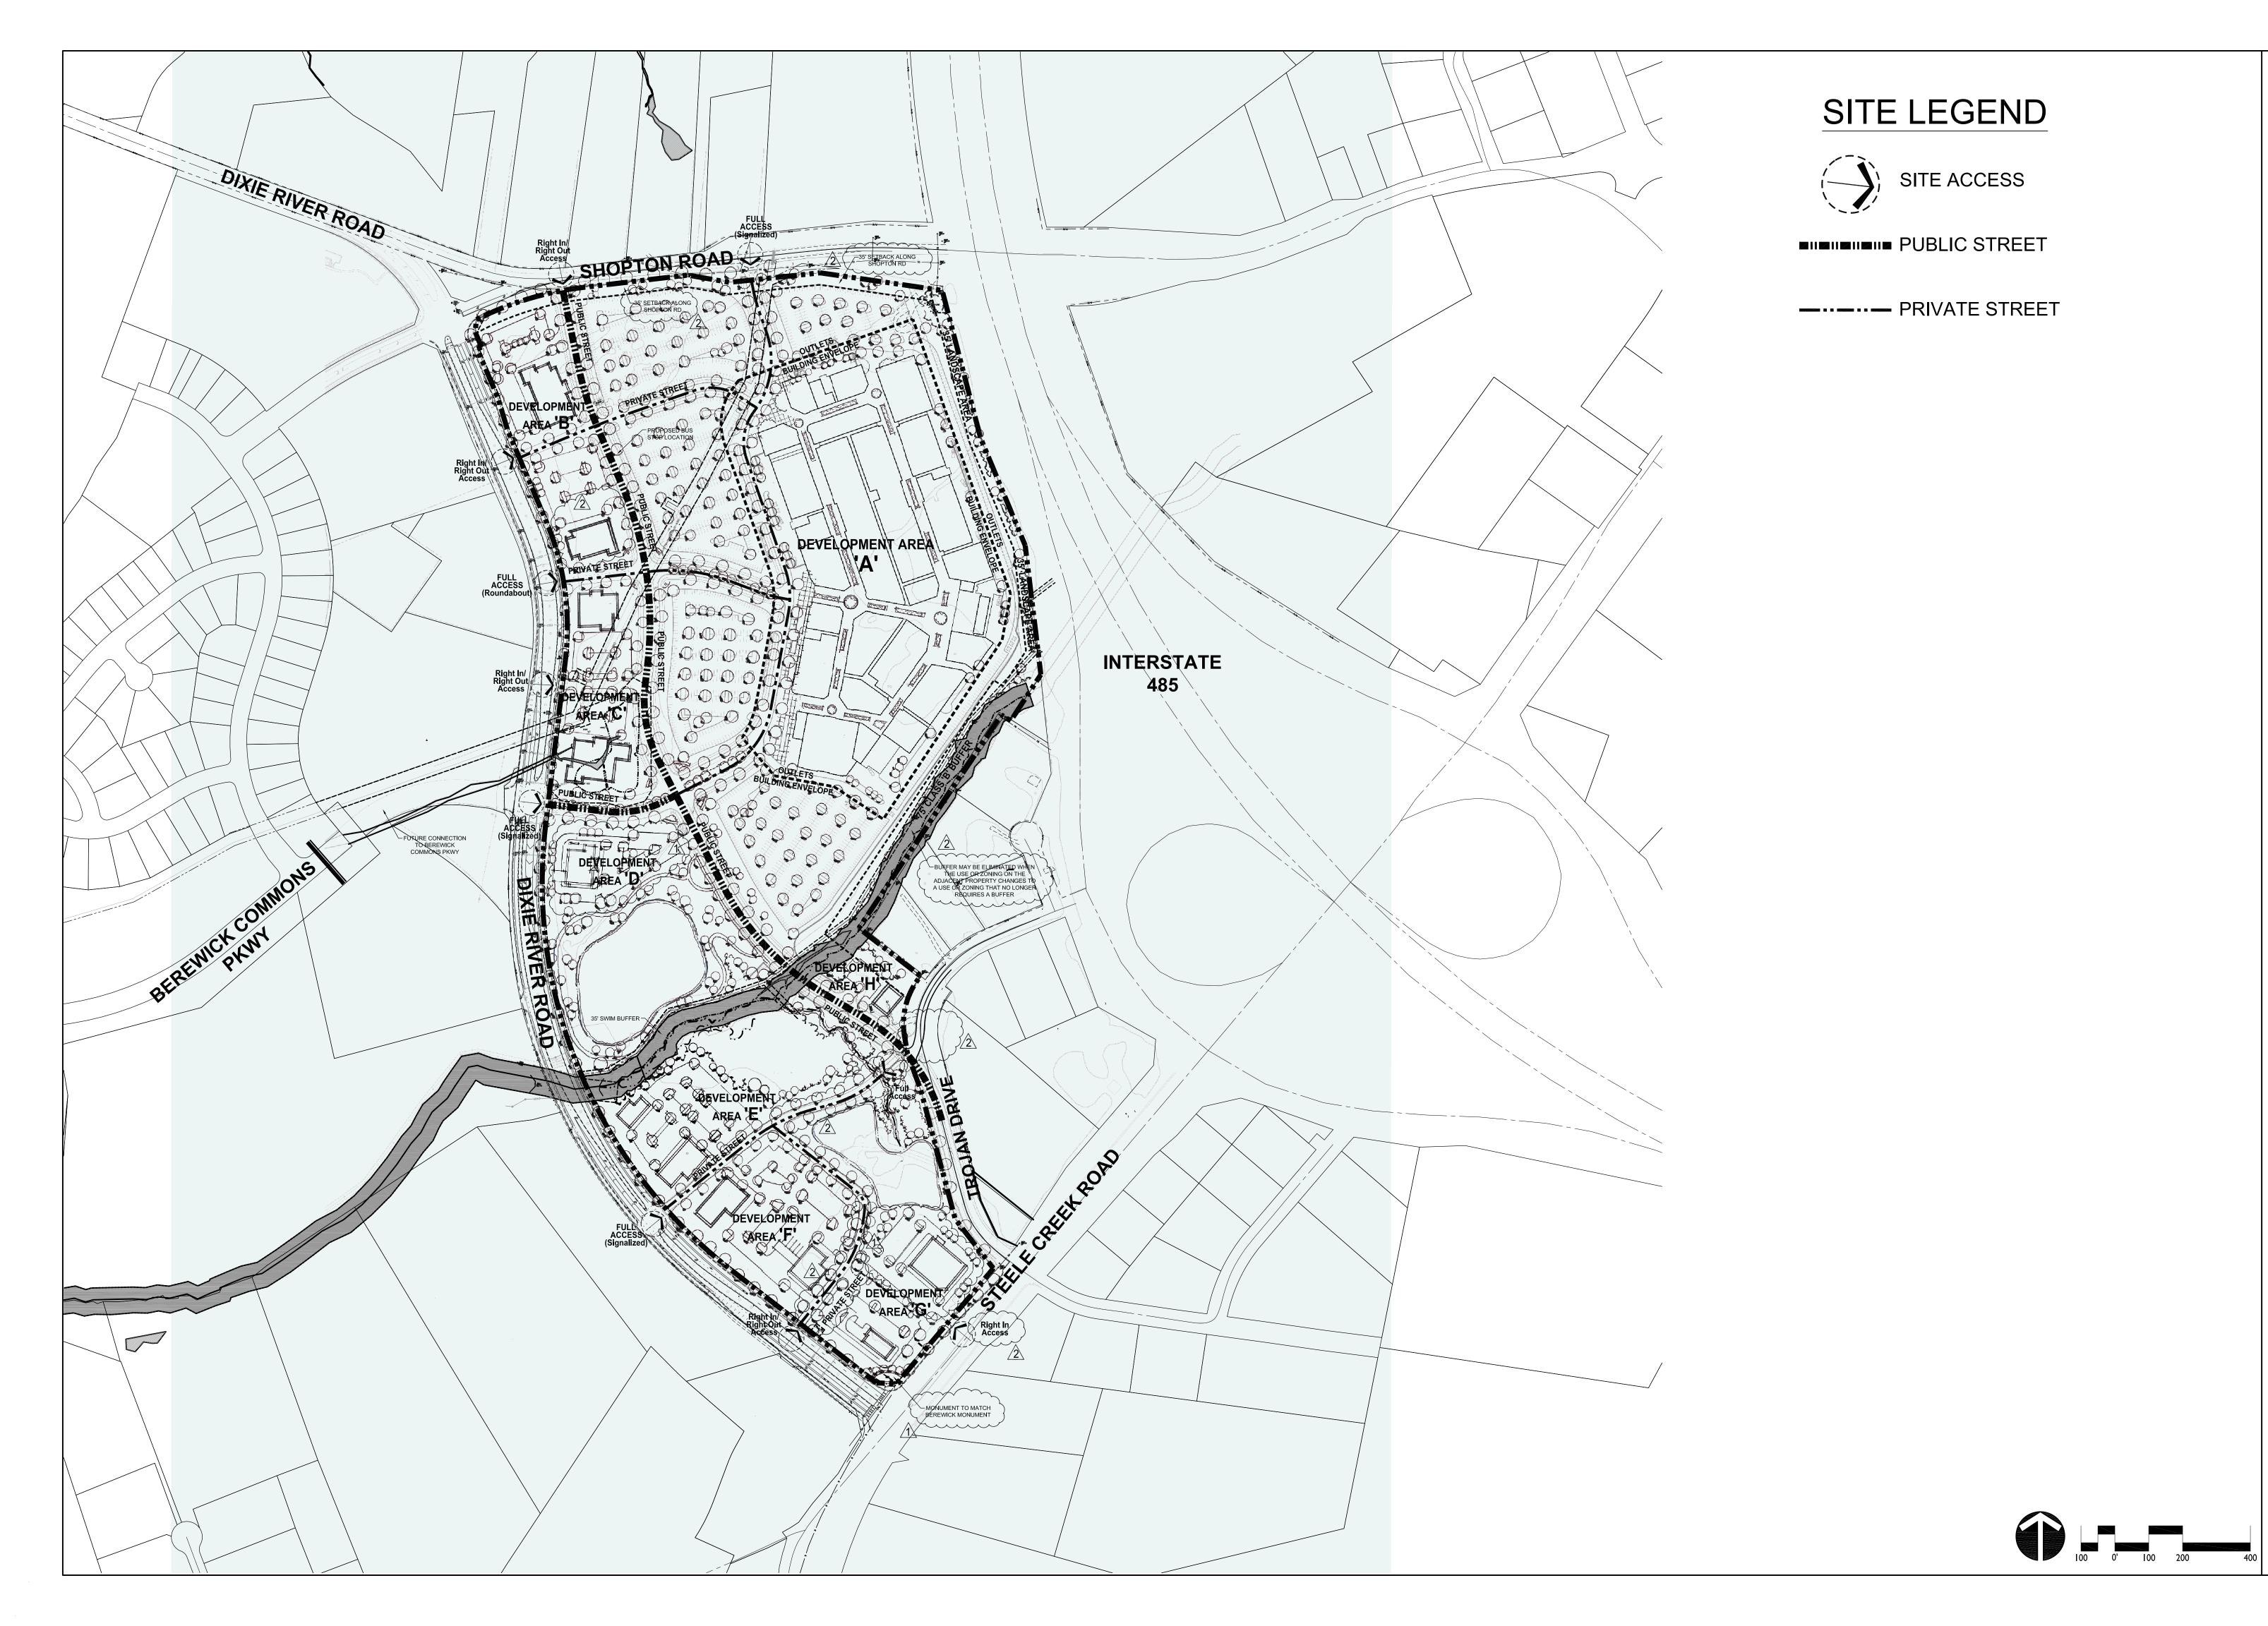

designation of the No.28

223 N Graham Street Charlotte, NC V: 704.333.0325 F: 704.332.3246

STEELE CREEK RETAIL CENTEI REZONING PETITION No. 2013-001

SCHEMATIC SITE PLAN

ST
21.12 REVISE PER STAFF COMMENTS
06.13 - REVISE PER STAFF COMMENTS
15.13 - REVISE PER STAFF COMMENTS
RECIE

DESIGNED BY: KST
DRAWN BY: KST
CHECKED BY: MRC
Q.C. BY: MRC
SCALE: 1"=200'
PROJECT #: 1012048

Steele Creek 1997 Limited Partnership

Rezoning Petition No. 2013-001 (Tanger Retail Center)

creage: ± 82.0 --Tax Parcel #: 199-241-03, 13, 15, 34 and 44; 199-251-01

-Existing Zoning: CC (LLW-PA); CC SPA (LLW-PA); I-1(CD) LLW-PA (by Rezoning Petition No. 2010-11) and R-3 LLW-PA -Proposed Zoning: MUDD-O LLW-PA, CC LLW-PA and CC (SPA) LLW-PA

-- Existing Uses: Vacant and two single-family homes --Proposed Uses: Uses permitted by right and under prescribed conditions together with accessory uses, as allowed in the CC and MUDD zoning districts (as more specifically described --Maximum Gross Square feet of Development: Up to 525,000 square feet of gross floor area and a hotel with up to 120 rooms.

-Maximum Building Height: As allowed by the Ordinance in the area zoned CC. In the area Zoned MUDD-O building height will be limited to 50 feet except for certain architectural features such as towers, gallery roofs and similar structures which may be up to 65 feet in height. Height to be measured as defined by the Ordinance. --Parking: As required by the Ordinance for the portion of the Site zoned CC and a minimum of one space per 250 gross square feet of building area for the portion of the Site zoned

**-Open Space:** A minimum of 15% of the Site will be established as open space as defined by the Ordinance. 1. General Provisions:

a. These Development Standards form a part of the Rezoning Plan associated with the Rezoning Petition filed by Steele Creek 1997 Limited Partnership to accommodate development of an upscale outlet retail center and accompanying retail, office and hotel uses on an approximately 82.0 acre site located south of Shopton Road, east of Dixie River Road, north of Steele

b. Development of the Site will be governed by the Rezoning Plan as well as the applicable provisions of the City of Charlotte Zoning Ordinance (the "Ordinance"). Unless the ezoning Plan establishes more stringent standards, the regulations established under the Ordinance for the CC classification for portions of the Site so designated on the Rezoning Plan, and the MUDD zoning district classification for the portions of the Site so designated on the Rezoning Plan (subject to the Optional Provisions provided below), shall govern all development taking place on the Site.

c. The schematic depictions of the uses, parking areas, sidewalks, structures and buildings, and other site elements set forth on the Rezoning Plan should be reviewed in conjunction with the provisions of these Development Standards. The ultimate layout, locations and sizes of the development and site elements depicted on the Rezoning Plan as well as any schematic building elevations are graphic representations of the development and site elements proposed, and they may be altered or modified in accordance with the setback, yard and buffer rements set forth on this Rezoning Plan and the Development Standards, provided, however, any such alterations and modifications shall not materially change the overall design intent depicted on the Rezoning Plan. Changes to the Rezoning Plan not permitted by the Rezoning Plan will be reviewed and approved as allowed by Section 6.207 of the Ordinance Notwithstanding the number of buildings shown on the Rezoning Plan, the total number of principal buildings to be developed on the Site shall not exceed 28. Accessory buildings and structures located on the Site shall not be considered in any limitation on the number of buildings on the Site. Accessory buildings and structures will be constructed utilizing similar building materials, colors, architectural elements and designs as the principal building(s) located within the same Development Area as the accessory structure/building. Other than parking structures, the size of accessory structures/buildings located within Development Area A will be limited to 20% of the building area of the principal buildings constructed within Permitted Uses & Development Area Limitation: ~~~~

a. Subject to the restrictions and limitations listed below, the Principal buildings constructed on the Site may be developed with up to 525,000 square feet of gross floor area of uses permitted by right and under prescribed conditions and a hotel with up to 120 years (sabject to conversion rights set forth below), together with accessory uses and uses under prescribed onditions in the Commercial Center (CC) and MUDD-O zoning districts, as applicable. For purposes of the development limitations set forth in these Development Standards (but not to be construed as a limitation on FAR requirements), the term "grossfloor area" or "GFA"

shall mean and refer to the sum of the gross horizontal areas of eachfloor of a principal building on the Site measured from the outside of the exterior walls or from the center line of party walls; provided, however, such term shall exclude any surface or structured parking facilities, areas used for building and equipment access (such as stairs, elevator shafts and naintenance crawl spaces), all loading dock areas (open or enclosed), and outdoor dining areas whether on the roof of the building(s) or at street level (parking for outdoor dining areas .... or promised as regain ea by the Gramanice). b. For ease of reference, the Rezoning Plan sets forth eight (8) development areas as generally depicted on the Technical Data Sheet as Development Areas A, B, C, D, E. F. G and H

c. Within Development Areas E, F, G and H the total allowed square footage of the Principal buildings will be limited to 55,000 square feet of gross floor area and a hotel with up to 120 rooms (subject to the conversion rights set forth below). Of the allowed 55,000 square feet of gross floor area within Development Areas E, F, G and H, a maximum of 27,500 square feet may be utilized for retail and/or restaurant uses. Up to three (3) uses, in total, with an accessory drive-through window may be developed within Development Areas E, F, G and H. A gas station with or without a convenience store may be substituted for one of the three allowed uses with an accessory drive-through window (e.g. if a gas station with or without a convenience store is constructed on one of the Development Areas referenced in this Section, then only two uses with accessory drive through windows will be allowed on the remaining Development

(each a "Development Area" and collectively the "Development Areas"). Development Areas A, B, C and D will be zoned MUDD-O (LLWPA), and Development Areas E, F, G and H

d. Up to two (2) uses, in total, with an accessory drive-through window will be allowed within Development Areas B, C and D. One gas station with or without a convenience store may be constructed on Development Area B.

The number of allowed hotel rooms may be increased by up to 30 rooms by reducing the amount of commercial uses at the rate of 500 square feet for each hotel room added. "Building Edges" have been provided within portions of Development Areas B and C as generally depicted on the Technical Data Sheet. [Note: The Building Edges shown consist of (wo (2) edges, one for each abutting street]. The buildings constructed within Development Areas B and C must adhere to the Building Edges to which they abut as generally depicted on the Technical Data Sheet (plaza/outdoor dining areas will be considered part of the buildings for the purposes of compliance with this provision) such that vehicular parking and maneuvering may not be located between the proposed buildings and the Building Edges indicated; other buildings constructed within these Development Areas that do not abut the Building Edges indicated shall not have to comply with this restriction. Without limiting the provisions of Sections 1 and 2 above, the schematic representations of the design treatment for

"Modified Building Edges" have been provided within Development Area D as generally depicted on the Technical Data Sheet. The Petitioner will provide along the Modified building Edges an improved open space area that will contain seating, concrete and/or masonry walls, landscaping and specialty pavers; if the Petitioner is able to locate a building along the Modified Building Edges these requirements shall not apply.

the development within Development Areas B and C generally depicted on Sheet RZ-2 are merely schematic in nature and may be altered in a manner consistent with the Building Edge(s)

provisions described above. In addition, the provisions of this Section may be altered to permit greater flexibility in development as allowed by the Administrative Amendment provisions

"Building Edges" have been provided within portions of Development Areas E and F as generally depicted on the Technical Data Sheet. The buildings constructed within Development Areas E and F must adhere to one of the two Building Edges generally depicted on the Technical Data Sheet but not both (plaza/outdoor dining areas will be considered part of the buildings for the purposes of compliance with this provision), such that vehicular parking and maneuvering may not be located between the proposed buildings and one of the two Building Edges indicated. Along the other Building Edge vehicular parking and maneuvering may be located between the proposed building and such Building Edge, provided that: (i) the ering allowed between the building and the Building Edge will be limited to one row of parking and/or one drive thru lane: (ii) a low wall (2.0' t 2.5' feet high) and low accent planting will be provided between the drive thru lane or parking area and the adjacent street; and (iii) such wall will be constructed of building materials nerally compatible with the buildings within the applicable Development Area. Other buildings constructed within Development Areas E and F that do not abut a Building Edge shall not have to comply with these restrictions. Without limiting the provisions of Sections 1 and 2 above, the schematic representations of the design treatment for the development within Development Areas E and F generally depicted on Sheet RZ-2 are merely schematic in nature and may be altered in a manner consistent with the Building Edges provisions described above. In addition, the provisions of this Section may be altered to permit greater flexibility in development as allowed by the Administrative Amendment provisions of the Ordinance.

Buildings constructed within Development Area G abutting Dixie River Road, Steele Creek Road or Trojan Drive, and the portion of Development Area F abutting Dixie River Road that does not have a Building Edge requirement, will limit the amount of parking between the proposed building and these streets to one row of parking and/or to a drive thru lane. A low wall (2.0' to 2.5' feet high) and low accent planting will be provided between the drive thru lane or parking area and the adjacent street, and such wall will be constructed of building aterials generally compatible with the buildings within Development Area G and F as applicable.

3. Optional Provisions for MUDD-O Areas. The following optional provisions shall apply to the portions of the Site designated MUDD-O on the Technical Data Sheet (i.e. Development Areas A, B, C and D) as more particularly 

To allow vehicular parking, maneuvering and service between the proposed buildings and: (i) I-485; (ii) Dixie River Road; (iii) Shopton Road; and (iv) the interior public streets, in the manner generally depicted on the Rezoning Plan and in accordance with the "Building Edge(s) provisions set forth above in Sections 2(f) and (g). b. To allow up to two (2) uses with an accessory drive-through window within Development Areas B, C, or D. 

To allow two (2) detached, project identification signs along I-485 within Development Area A. Each of these two (2) signs may be up to 50 feet high and may contain up to 300 square feet of sign area. To allow along the internal public street (i.e. the extension of Trojan Drive through the Site to Shopton Road) up to three (3) ground mounted signs identifying the shopping center within Development Area A, but not the individual tenants; these signs will be generally located at the intersection of the internal private streets and Trojan Drive extension and will be up to eight (8) feet high and may contain up to 64 square feet of sign area, the overall width of the allowed sign plus any structural supports or other none sign face features of

To allow along the other public street frontages of Development Areas A, B, C, and D, one (1) shopping center sign per street front, these signs may be up to 30 feet high and contain up to 150 square feet of sign area. e. To allow one (1) detached identification sign for each building located within Development Areas B, C and D. These detached identification signs may be up to four (4) feet high and

f. To allow wall signs to have up to 200 square feet of sign surface area per wall or 10% of the wall area to which they are attached, whichever is less, within Development Areas A, B,

To allow any of the detached signs allowed by the Ordinance or these Optional Provisions to be placed within the setbacks or landscape areas indicated on the Rezoning Plan ovided, however, such the detached signs are located a minimum of 14 feet behind the back of curb of the abutting public street o allow tenant identification signs within Development Area A to be located on exterior building walls and certain architectural features (e.g. tower elements and other such

features) that are not part of the leasable area of the tenant indentified. The total amount of signage on these architectural features will not exceed 25% of the wall area, and the signs located on the exterior building walls will not exceed 10% of the wall area to which the signs are attached i. To allow the buildings constructed within Development Area A to provide alternative blank wall treatments for the building walls that face I-485. Dixie River Road, Shopton Road and the interior public street. Examples of these alternative treatments are generally depicted on Sheets RZ-5a and RZ-5b of the Rezoning Plan, but other similar treatments may be allowed.

To not require doorways to be recessed into the face of the building(s) with Do Note: The optional provisions regarding signs are additions to the standards for the are additions to the standards for signs in the MUDD district and should be used in conjunction with and in addition to the normal MUDD

sign regulations.

4. Access: a. Access to the Site will be from Steele Creek Road, Dixie River Road, Trojan Drive and Shopton Road as generally depicted on the Rezoning Plan.

The number and location of access points to the internal public streets will be determined during the building permit process. The private streets generally depicted on the Technical Data Sheet will be designed to meet the "Office-Narrow" cross-section as defined in City of Charlotte Subdivision Ordinar The state of the s d. A sidewalk network as generally depicted by the pedestrian circulation plan set forth on Sheet RZ-4 of the Rezoning Plan will be provided. The minimum width of the sidewalks

e. The alignment of the internal public and private Streets, vehicular circulation and driveways may be modified by the Petitioner to accommodate changes in traffic patterns, parking layouts and any adjustments required for approval by the Charlotte Department of Transportation (CDOT) in accordance with published standards.

Proposed Improvements

The Petitioner plans to provide or cause to be provided on its own or in cooperation with other parties who may implement portions of the improvements, the improvements set forth below to benefit overall traffic patterns throughout the area in accordance with the following implementation provisio

The following Transportation Improvements are also illustrated on Figure 11a and 11b on Sheet RZ-4 of the Rezoning Plan. The figures on Sheet RZ-4 are to be used in conjunction with

the following notes to determine the extent of the proposed improvements (reference to a number or letter when describing an improvement corresponds to the number or letter found on figure 11a and 11b for the proposed improvement) Improve Dixie River between Steele Creek Road (NC 160) and Shopton Road as follows:

Construct a second westbound through lane on Dixie River Road within the existing cross-section (median reduction/pavement marking modifications) for the majority of its length commences as a combined through-right turn lane at Proposed Access "B" and terminates as the existing westbound left turn lane at Shopton Road; and Construct a second eastbound through lane on Dixie River Road within the existing cross-section (median reduction/pavement marking modifications) for the majority of its length commences as a combined through-right turn lane at Proposed Access "B" and terminates as the existing westbound left turn lane at Shopton Road.

Improve Steele Creek Road Between I-485 Outer Ramps & Dixie River Road as follows:

Construct a 3rd southbound through lane on Steele Creek Road that commences at the I-485 Outer Exit Ramp and terminates as the existing right turn lane at Dixie River Road

Improve Steele Creek Road (NC 160) & Brown-Grier Road (intersection # 1) as follows:

Construct a northbound right turn lane on Steele Creek Road with a minimum of 200 feet of storage and a 150-foot bay taper

Extend the existing southbound left turn lane storage on Steele Creek Road from 150 feet to 225 feet with a 150-foot bay taper.

Improve Steele Creek Road (NC 160) & Dixie River Road (intersection # 3) as follows:

Re-mark the existing painted out northbound left turn lane on Steele Creek Road to a 2nd left turn lane (300 feet of storage and a 250-foot bay taper); Construct a 2nd eastbound left turn on Dixie River Road (within the existing median) with 400 feet of storage (matching the existing left turn lane) and a 200-foot bay taper Mark-out the existing outer eastbound left turn lane for an eventual through lane for the future Berewick Commons offsite development on the east side of Steele Creek Road; and

Improve Steele Creek Road (NC 160) & Trojan Drive/Rigsby Road (intersection # 4) as follows:

Extend the existing raised median on Steele Creek Road a minimum of 100 feet north of Trojan Drive/Rigsby Road to eliminate the possibility of left entering vehicles or left exiting hicles. The northbound left turn lane at Trojan Drive will be removed; and

Construct a southbound right turn lane on Steele Creek Road with 100 feet of storage and a 150-foot bay taper.

Construct an eastbound right turn lane on the I-485 Outer Exit Ramp with a minimum of 1,150 feet of storage and a 200-foot bay taper (the existing eastbound combined

Improve Steele Creek Road (NC 160) & Inner Ramps (intersection # 6) as follows:

Improve Steele Creek Road (NC 160) & I-485 Outer Ramps (intersection # 5) as follows:

Re-mark the existing westbound combined through-right turn exit lane to a combined through-left turn lane on the I-485 Inner Exit Ramp; and Construct a westbound right turn lane on the I-485 Inner Exit Ramp with a minimum of 275 feet of storage and a 200-foot bay taper.

Improve Steele Creek Road (NC 160) & Shopton Road (intersection #7) as follows:

Re-mark the existing westbound through lane to a 2nd left turn lane on Shopton Road with 225 feet of storage and a 200-foot bay taper; and

Extend the existing westbound right turn lane 150 feet on Shopton Road (to the existing retail driveway) and re-mark to a combined through-right turn lane; and With the introduction of this 2nd left turn lane the southwest corner of the intersection will need to be modified with new pavement (to safely maneuver larger vehicles without sing into the adjacent travel lane) that terminates at the existing right turn lane on Steele Creek Road (CVS pharmacy - approximately 125 feet in length).

Contribute Funds for the future Signalization of the Intersection Dixie River Road & Shopton Road (intersection #9) as follows:

Provide up to \$86,000.00 toward the cost of the future installation of a traffic signal at this intersection (after a traffic signal warrant analysis is performed by CDOT or NCDOT and ffic warrants for the intersection are met). Petitioner's contribution will not exceed the amount stated above.

Improve Dixie River Road & Proposed Access A (intersection 10A) as follows:

Construct Proposed Access "A" with one northbound ingress lane and one southbound egress lane that terminates as a right turn lane. The existing median on Dixie River Road will nate the possibility of left entering vehicles or left exiting vehicles; and

Improve Dixie River Road & Proposed Access B (intersection 10B) as follows: Signalize the intersection, [the cost of the proposed signal to be shared with the developer of Berewick Town Center;]

Re-marked as a combined through-right turn lane the existing westbound outer through lane on Dixie River Road.

The existing eastbound left turn lane with 350 feet of storage on Dixie River Road is acceptable as is; construct dual southbound left turn exit lanes on Proposed Access "B" with 150 feet of storage and a 100-foot bay taper; Construct a southbound (future combined thru-right) right turn exit lane on Proposed Access "B";

Construct Proposed Access "B" with one northbound entering lane; The existing westbound right turn lane on Dixie River Road should be extended as a second through lane (the outer lane will be a combined through-right turn lane at Proposed ss "B") where the new through lane constructed in the existing median terminates as the existing westbound left turn lane at Shopton Road (for all intersections on Dixie River Road);

Construct a second eastbound through lane on Dixie River Road that commences at a point east of Shopton Road and terminates as the existing eastbound outermost left turn lane at Steele Creek Road (for all intersections on Dixie River Road).

Improve Dixie River Road & Proposed Access "C" (intersection 10C) as follows:

Petitioner to fund the full cost of the installation of traffic signal at this intersection The existing eastbound left turn lane with 260 feet of storage and the existing westbound left turn lane with 560 feet of storage on Dixie River Road are acceptable as is;

Construct a westbound right turn lane on Dixie River Road with 100 feet of storage and a 100-foot bay taper; and Construct dual southbound left turn exit lanes on Proposed Access "C". The inner left turn lane will include 200 feet of storage and a 100-foot bay taper and the outer left turn lane Il terminate from the inner through lane from the Trojan Drive/Proposed Access "K" intersection. The southeast corner of the intersection will be widened with a 100-foot taper in ord-

Improve Dixie River Road & Proposed Access "D" (intersection 10D) as follows:

safely maneuver larger vehicles without crossing into the adjacent travel lane;

Construct Proposed Access "D" with one northbound ingress lane and one southbound egress lane. The existing median on Dixie River Road will eliminate the possibility of left ering vehicles or left exiting vehicles; and The existing westbound through lane on Dixie River Road will be re-marked as a combined through-right turn lane;

Improve Dixie River Road & Proposed Access "E" (intersection 10E) as follows:

Construct a roundabout with the following laneage: 14-foot wide ingress lanes (two on each of the two Dixie River legs and one on the Proposed Access "E" leg) and two 14-foot e egress lanes (two on each of the two Dixie River legs and one on the Proposed Access "E" leg). The roundabout will generally consist of a minimum 65-foot wide diameter island, a not wide truck apron, two 16-foot wide circulating lanes, and 5-foot wide bike lanes on both sides of Dixie River Road (160-foot wide inscribed diameter).

Improve Dixie River Road & Proposed Access "F" (intersection 10F) as follows:

Construct Proposed Access "F" with one northbound ingress lane and one southbound egress lane. The existing median on Dixie River Road will eliminate the possibility of left ring vehicles or left exiting vehicles; and The existing westbound through lane on Dixie River Road will be re-marked as a combined through-right turn lane.

Improve Trojan Drive & Proposed Access "G" (intersection 10G) as follows:

Construct Proposed Access "G" with one southbound ingress lane.

With one eastbound and westbound through lane on Trojan Drive with a two-way left-turn lane (TWLTL) (three-lane section) commencing at Steele Creek Road and terminating a nopton Road (the TWLTL will terminate as a westbound left turn lane at Proposed Access "N"); Create with pavement markings and eastbound and westbound left turn lane on Trojan Drive with 100 feet of storage each within the existing TWLTL described above;

Construct Proposed Access "G" with a northbound left turn egress lane with 100 feet of storage; Construct Proposed Access "G" with a northbound combined thru-right egress lane (opposite Old Trojan Drive); and

Improve Trojan Drive & Proposed Access "H" (intersection 10H) as follows: With one eastbound and westbound through lane on Trojan Drive with a two-way left-turn lane (TWLTL) (three-lane section) commencing at Steele Creek Road and terminating at on Road (the TWLTL will terminate as a westbound left turn lane at Proposed Access "N"). An eastbound left turn lane with a minimum of 100 feet of storage will be marked within

Proposed Access "H" with 150 feet of stem length with one northbound entering lane and two southbound exit lanes (separate left and right lanes).

Improve Trojan Drive & Proposed Access "I" (intersection 10I) as follows: With one eastbound and westbound through lane on Trojan Drive with a two-way left-turn lane (TWLTL) (three-lane section) commencing at Steele Creek Road and terminating at pton Road (the TWLTL will terminate as a westbound left turn lane at Proposed Access "N"). An eastbound left turn lane with a minimum of 100 feet of storage will be marked within e TWLTL; and

Proposed Access "I" with 225 feet of stem length with one southbound entering lane and two northbound exit lanes (separate left and right lanes). Improve Trojan Drive & Proposed Access "J" (intersection 10J) as follows:

With one eastbound and westbound through lane on Trojan Drive with a two-way left-turn lane (TWLTL) (three-lane section) commencing at Steele Creek Road and terminating at hopton Road (the TWLTL will terminate as a westbound left turn lane at Proposed Access "N"). An eastbound left turn lane with a minimum of 100 feet of storage should be marked vithin the TWLTL: and.

Proposed Access "J" with 150 feet of stem length with one southbound entering lane and two northbound exit lanes (separate left and right lanes). Improve Trojan Drive/Private Street & Proposed Access "K" (intersection 10K) as follows:

With one eastbound and westbound through lane on Trojan Drive/Private Street with a two-way left-turn lane (TWLTL) (three-lane section) commencing at Steele Creek Road and rminating at Shopton Road (the TWLTL will terminate as a westbound left turn lane at Proposed Access "N"). A westbound left turn lane with 75 feet of storage and an eastbound left turn lane with 100 feet of storage should be marked within the TWLTL. Trojan Drive/Private Street will be under stop sign control at this intersection (Proposed Access "K" will be a

A westbound right turn lane on Trojan Drive with 100 feet of storage and a 100-foot bay taper;

An eastbound right turn lane on Private Street with 100 feet of storage and a 100-foot bay taper The south leg of Proposed Access "K" will include the inner northbound lane as a combined through-left turn lane and the outer northbound leg will be a combined thru-right turn Proposed Access "K" with 300 feet of stem length, with one northbound entering lane and two southbound exit lanes (the inner lane is a combined through-left turn lane and the outer

10I ) as follows:

With one eastbound and westbound through lane on Trojan Drive with a two-way left-turn lane (TWLTL) (three-lane section) commencing at Steele Creek Road and terminating a Shopton Road (the TWLTL will terminate as a westbound left turn lane at Proposed Access "N"). A westbound left turn lane with a minimum of 100 feet of storage should be marked

Improve Private Street & Proposed Access "M" (intersection 10M) as follows:

With one eastbound and westbound through lane on Private Street with a two-way left-turn lane (TWLTL) (three-lane section) commencing at Steele Creek Road and terminating at nopton Road (the TWLTL will terminate as a westbound left turn lane at Proposed Access "N"). An eastbound and westbound left turn lane with 100 feet of storage should be marked within the TWLTL. Private Street will be under stop sign control at this intersection (Proposed Access "M" will be a free-flow movement) A westbound right turn lane on Private Street with 100 feet of storage and a 100-foot bay taper;

The south leg of Proposed Access "M" will include a northbound left turn lane with 100 feet of storage and a combined thru-right turn lane; and Proposed Access "M" with a minimum of 175 feet of stem length, with one northbound entering lane and two southbound exit lanes (the inner lane terminates as a left turn lane and he outer lane is a combined through-right turn lane).

Proposed Access "L" with 150 feet of stem length with one southbound entering lane and two northbound exit lanes (separate left and right lanes).

Improve Private Street & Proposed Access "N" (intersection 10N) as follows:

With one eastbound and westbound through lane on Private Street with a two-way left-turn lane (TWLTL) (three-lane section) commencing at Steele Creek Road and terminating at Proposed Access "N" with 150 feet of stem length with one southbound entering lane and two northbound exit lanes (separate left and right lanes).

Improve Shopton Road & Private Street (intersection 100) as follows:

Access "O" with one eastbound ingress lane and one westbound egress lane that terminates as a right turn lane: Construct a raised median on Shopton Road a minimum of four-feet wide that extends 100 feet north and south of the Private Street to eliminate the possibility of left entering vehicles or left exiting vehicles; and

A northbound right-turn lane on Shopton Road with 100 feet of storage and a 150-foot bay taper. Improve Shopton Road & Proposed Access "P" (intersection 10P) as follows:

Petitioner to fund the full cost of the installation of a traffic signal at this intersection:

A northbound right turn lane on Shopton Road with 100 feet of storage and a 150-foot bay taper: A southbound left turn exit lane on Shopton Road with 150 feet of storage, a 100-foot bay taper, and a 500-foot through lane taper; An eastbound entering lane on Proposed Access "B"; and

Separate westbound left (150 feet of storage) and right (termination) exit lanes on Proposed Access "P".

Improve Steele Creek Road & Proposed Access "R" (intersection 10R) as follows: Construct proposed access "R" with one westbound ingress lane (right-in only).

II. Standards, Phasing and Other Provisions.

CDOT/NCDOT Standards. All of the foregoing public roadway improvements will be subject to the standards and criteria of CDOT and NCDOT, as applicable, to the roadway ments within their respective road system authority. It is understood that such improvements may be undertaken by the Petitioner on its own or in conjunction with other evelopment or roadway projects taking place within the broad southwest Mecklenburg area, by way of a private/public partnership effort or other public sector project support.]

Phasing and Substantial Compliance.

Development Areas E, F, G and H. The Petitioner will be allowed to obtain a certificate of occupancy for any one or all of the buildings located within Development Areas E, F, C

Improve Steele Creek Road (NC 160) & Dixie River Road (intersection #3) as follows:

Re-mark the existing painted out northbound left turn lane on Steele Creek Road to a 2nd left turn lane with 300 feet of storage and 250-foot bay taper.

Improve Steele Creek Road (NC 160) & Trojan Drive/Rigsby Road (intersection #4) as follows: Extend the existing raised median on Steele Creek Road a minimum of 100 feet north of Trojan Drive/Rigsby Road to eliminate the possibility of left entering vehicles or left exiting ehicles (the northbound left turn lane at Trojan Drive will be removed); and Construct a southbound right turn lane on Steele Creek Road with 100 feet of storage and a 150-foot bay taper.

Improve Dixie River Road & Proposed Access "A" (intersection 10A) as follows: Construct Proposed Access "A" with one northbound ingress lane and one southbound egress lane that terminates as a right turn lane. The existing median on Dixie River Road will liminate the possibility of left entering vehicles or left exiting vehicles; and

The existing westbound outer through lane on Dixie River Road should be re-marked as a combined through-right turn lane Improve Dixie River Road & Proposed Access "B" (intersection 10B) as follows:

[Signalize the intersection, the cost of the proposed signal to be shared with the developer of Berewick Town Center] The existing eastbound left turn lane with 350 feet of storage on Dixie River Road is acceptable as is; Construct dual southbound left turn exit lanes on Proposed Access "B" with 150 feet of storage and a 100-foot bay taper

Construct a second receiving lane on eastbound Dixie River Road from Proposed Access "B" within the existing median to tie at the start of the storage of the existing eastbound nside left turn lane on Dixie River Road: Construct a southbound (future combined thru-right) right turn exit lane on Proposed Access "B";

The existing lane that terminates as a westbound right turn lane on Dixie River Road is acceptable as is. Improve Troian Drive & Proposed Access "G" (intersection 10G) as follows:

With one eastbound and westbound through lane on Trojan Drive with a two-way left turn lane (TWLTL) (three lane section) commencing at Steele Creek Road and terminating cess 10H (the road will be extended to Shopton Road as part of phase two of the development);

Construct Proposed Access "G" with one southbound ingress lane. Improve Steele Creek Road & Proposed Access "R" (intersection 10R) as follows:

Construct Proposed Access "G" with a northbound left turn egress lane with 100 feet of storage;

Construct Proposed Access "G" with a northbound combined thru-right egress lane (opposite Old Trojan Drive); and

nd D upon the substantial completion of the improvements listed above in Section 5.I.a. - z. of these Development Standard

Construct one northbound entering lane on Proposed Access "B"; and

Construct Proposed Access "R" with one westbound ingress lane (right-in only). Development Areas A, B, C, and D. The Petitioner will be allowed to obtain a certificate of occupancy for any one or all of the buildings located within Development Areas A, B, C

Substantial Completion. Reference to "substantial completion" for certain improvements as set forth in the provisions of Section 5.II above shall mean completion of the roadway tents in accordance with the standards set forth in Section 5.II.a above provided, however, in the event certain non-essential roadway improvements (as reasonably determined by CDOT) are not completed at the time that the Petitioner seeks to obtain a certificate of occupancy for building(s) on the Site in connection with related development phasing described love, then CDOT will instruct applicable authorities to allow the issuance of certificates of occupancy for the applicable buildings, and in such event the Petitioner may be asked to post a letter of credit or a bond for any improvements not in place at the time such a certificate of occupancy is issued to secure completion of the applicable improvements. d. Right-of-way Availability. It is understood that some of the public roadway improvements referenced in subsection a. above may not be possible without the acquisition of

additional right of way. If after the exercise of diligent good faith efforts, the Petitioner is unable to acquire any land necessary to provide for any such additional right of way upon mmercially reasonable terms and at market prices, then CDOT, the City of Charlotte Engineering Division or other applicable agency, department or govern with condemnation of any such land. In such exem, the Resitioner shall reinflues the applicable agency, department or governmental body for the cost of any such condemnation proceedings including compensation paid by the applicable agency, department or governmental body for any such land and the expenses of such proceedings. Furthermore, in the event public roadway improvements referenced in subsection a above are delayed because of delays in the acquisition of additional right-of-way as contemplated herein and such delay extend beyond the time that the Petitioner seeks to obtain a certificate of occupancy for building(s) on the Site in connection with related development phasing described above, then CDOT will nstruct applicable authorities to allow the issuance of certificates of occupancy for the applicable buildings; provided, however. Petitioner continues to exercise good faith efforts to complete the applicable road-way improvements; in such event the Petitioner may be asked to post a letter of credit or a bond for any improvements not in place at the time such a certificate occupancy is issued to secure completion of the applicable improvements.

Alternative Improvements. Changes to the above referenced readyways and the shows represent the shows represent the shows ready and the shows represent the shows e. Alternative Improvements. Changes to the above referenced roadway improvements can be approved through the Administrative Amendment process upon the determination and mutual agreement of Petitioner, CDOT, Planning Director, and as applicable, NCDOT, provided, however, the proposed alternate transportation improvements provide (in the aggregate) comparable transportation network benefits to the improvements identified in this Petition.

Special Requirements for Trojan Drive Extension. The interior public street referenced as Trojan Drive Extension on the Rezoning Plan will be considered an "Avenue" as defined in the City of Charlotte Subdivision Ordinance but constructed substantially as shown by the cross-sections on Sheet RZ- 4. The Petitioner reserves the right to provide a median along portions of this public street. If a median is added the median will be of sufficient width to accommodate trees as specified by the City of Charlotte Tree Ordinance

Architectural standards: The principal buildings constructed on the Site may use a variety of building materials. The building materials used will be a combination of the following: brick, stone, simulate one, pre-cast stone, precast concrete, synthetic stone, stucco, EIFS or wood. Buildings materials for the principal buildings constructed within Development Area A will be limited to 60% EIFS excluding the Pedestrian Access Plazas as indicated below in Section 6.c (the portions of the buildings located behind the loading area screen walls will not be included when calculating the percentage of allowed EIFS). Building materials for the principal buildings constructed within all the other Development Areas will be limited to 40% EIFS.

The Petitioner will coordinate the general annearance of the Site's building architecture, landergaing, signeds and attentions allowants with the Description generally similar building materials, colors, architectural details, streetscapes, landscape materials and landscape designs. Reference is made to "Building Two" within Development Area A as generally depicted on the Rezoning Plan. The two (2) "Pedestrian Access Plazas" located on either side of Building Two shall be designed to serve generally as a "front door" type feature to that portion of the development within Development Area A, and as such will be designed substantially in cordance with the following standards: (i) towers located at the Pedestrian Access Plazas will be designed using up to 50% EIFS with the remaining being cultured/cast stone or other high quality architectural finish to a height of 12 feet, and above 12 feet the building material will be primarily EIFS; (ii) architectural features located at the Pedestrian Access Plazas will be designed using up to 50% EIFS with the remainder being cultured/cast stone or other high quality architectural finish; and (iii) the area of Building Two between the Pedestrian Access Plazas will be designed using up to 60% EIFS with the remainder being cultured/cast stone or other high quality architectural finish (the portions of the buildings located behind the loading

\_\_\_\_\_ d. The principal buildings throughout the Site may be built in phases. Without limiting the generality of the foregoing, portions of the buildings facing Shopton Road may not be built when other buildings within Development A are constructed; in this regard, the ends of such buildings that may be expanded during a subsequent phase of development will be treated, prior to such expansion in the manner generally depicted on Sheet RZ-4 of the Rezoning Plan. The buildings that are completed during the first phase of development that will be expanded in ubsequent phases will also be finished in the manner generally depicted on Sheet RZ-4. The walls used to screen the service and loading areas of buildings on the Site will be designed as generally depicted on Sheet RZ-5a and RZ-5b of the Rezoning Plan; special tention and additional details will be added to the screen walls that face Dixie River Road in the manner generally depicted on Sheet RZ-5a and RZ-5b of the Rezoning Plan The service areas of the buildings constructed within Development Areas B, C, and D will be screened from the adjoining streets with walls designed to match and compliment the

building architecture of the adjacent buildings. Architectural features such as, but not limited to, banding, medallions, changes in color or design features or materials will be provided to avoid a sterile, unarticulated blank treatment of such walls. g. Retaining walls located on the Site will be treated with landscaping to help soften their appearance.

h. Meter banks will be located behind the building and will be screened where visible from public view. Roof top HVAC and related mechanical equipment will be screened from public view at grade

rea screen walls will not be included when calculating the percentage of allowed EIFS)

Streetscape, Landscaping and Buffers: No buildings or parking areas will be allowed within a 35 foot landscape area along I-485, nothing shall prevent signs from being placed within the 35 foot landscape area. This 35 foot landscape area will be landscaped with a variety of evergreen and deciduous shrubs, ornamental grasses and seasonal color. No less than 20 shrubs per 100 linear feet will be provided

b. A 35 foot setback will be provided along Shopton Road as generally depicted on the Rezoning Plan. Reference is made to the Optional Provisions regarding the placement of signs within portions of the 35 foot setback along Shopton Road. The setback area along Shopton Road will be landscaped with trees at the rate of one tree per 40 linear feet with the arrangement nd placement of these trees to be determined by the Petitioner during the land development permitting process. These trees will be in addition to any required street trees and screening required by the Tree Ordinance and the zoning regulations.

or the portions of the Site designated CC on the Technical Data Sheet, a setback as required by the CC Zoning District will be established along existing and proposed public streets, rovided, however, the Petitioner reserves the right to the reduce the CC district setback from 35 feet to 14 feet as allowed by the Ordinance. d. Along Dixie River Road the Petitioner will provide a variety of landscape treatments as described in this subsection. At the intersection of Dixie River Road and Berewick Comm Parkway, at the roundabout intersection on Dixie River Road and within Development Areas B, C and D, the Petitioner will provide a low wall (2.0 to 2.5 feet high) and low accen plantings to screen parking areas from Dixie River Road; such wall will be constructed of building materials generally compatible with the buildings within the applicable Development rea; provided, however, if a building is located adjacent to Dixie River Road without parking or maneuvering between such building and Dixie River Road, the requirement for a low wall will not apply. Along the other portions of Dixie River Road where a low screen wall is not required, the Petitioner will provide a 10 foot landscape area, and where spacing of development lements reasonably permits, a berm that will create an attractive streetscape treatment. The landscaping within the 10 foot area will contain at a minimum 30 shrubs and three (3) small maturing trees per 100 linear feet of street frontage, the three (3) trees will be in addition to any required street trees. The arrangement of the trees and shrubs within the 10 foot area will be determined by the Petitioner during the land development permitting process. Along a portion of Dixie River Road the Petitioner must provide a utility easement for the installation of a orce water main and a sanitary sewer line; accordingly where this easement runs parallel the right-of-way for Dixie River Road, the Petitioner will not be required to provide the 10 foot ndscape area and the additional landscaping described above, provided that screening of parking areas will still be required and provided further that no more than [400] linear feet of 10 oot landscape area along Dixie River Road may be effected by this utility easement.

e. The Petitioner will provide eight (8) foot planting strips and six (6) foot sidewalks along the Site's frontage on Steele Creek Road, Dixie River Road, Trojan Drive and Shopton Road. Planting strips and sidewalks along the Site's other public and private streets will be installed to the extent required by the Design Standards for Streets outlined in the Subdivision

f. Along the Site's internal private streets, the Petitioner will provide a sidewalk and a cross-walk network that links all the buildings on the Site with one another by way of links to sidewalks along the abutting public and private streets and/or other pedestrian features. The minimum width for these internal sidewalks will be six (6) feet. Street trees will also be

A buffer will be provided along the Site's southeastern property boundary as generally depicted on the Rezoning Plan. This buffer may be reduced in width as allowed by the Ordinance by the installation of a fence or wall. This buffer may be eliminated when the use or zoning on the adjoining property changes to a use or zoning category that no longer requires

If at the time of the application of the first building permit for a building within Development Area G, the property currently consisting of Tax Parcel #199-243-01 located across Trojan Drive from Development Area G has been developed for one or more single family residential homes, the Petitioner shall install a 20 foot Class C buffer along Trojan Drive adjacent to Development Area E; no such buffer shall be required if such property has not been developed for one or more single family residential homes at the time of the application of the first building permit for a building within Development Area G.

Foundation plantings shall be provided for the outlet retail center within Development Area A as identified on Sheets RZ-5a and RZ-5b. 

8. Environmental Features:

ave no ownership interest in the CMANN station

The Site will comply with the Tree Or

approval of the specific Erosion Control Plan for the Site):

a. The Petitioner shall comply with the Charlotte City Council approved and adopted Post Construction Controls Ordinance.

The location, size and type of storm water management systems depicted on the Rezoning Plan is subject to review and approval as part of the full development plan submittal and is ot implicitly approved with this rezoning. Adjustments may be necessary in order to accommodate actual storm water treatment requirements and natural site discharge points. In order to provide greater assurance of downstream water quality protection, the Petitioner will provide funds to Charlotte Storm Water Services/Mecklenburg County Water Quality rogram for the purchase, installation, maintenance and operation of a temporary Continuous Monitoring and Alert Notification Network (CMANN) station, the funds to be provided will be afficient to allow the County to operate and monitor the station while the Site is deemed to be under "Development" to be defined as the period of time from issuance of a grading permit to

when the grading permit is closed. The proposed CMANN station must be installed and operational prior to the issuance of a clearing and/or grading permit for the Site. Charlotte Storm

Water Services/Mecklenburg County Water Quality Program shall have sole responsibility for operation of the CMANN station while the Site is under "Development". The Petitioner will

In addition, the Petitioner in coordination with City Engineering will provide enhanced on-site erosion control measures. The following is a list of measures that will be undertaken n the Site to manage erosion from the Site while the Site is under "Development" (this list of measures may be modified, (measures added and deleted), by City Engineering as part of the

) enlarged sediment basin capacity; (ii) sediment basin skimmer (top down) dewatering; (iii) increased resonance time for basin dewatering; (iv) sediment basins with silt bag outlets; (v) PAM (Polyacrylamide) - enhanced settling; (vi) stream berms; (vii) diversion ditches; (viii) double row, high hazard silt fence; and (ix) a dedicated erosion control manager. 

The Petitioner will construct an eight (8) foot multi-use trail around the proposed water quality storm water detention pond located within Development Area D as generally depicted on the Schematic Site Plan. The multi-use trail will connect to the sidewalk along Dixie River Road and to the sidewalk along the internal public street abutting the facility. This multi-use trail will be an asphalt trail or equivalent surface. The Petitioner will provide seating areas and pedestrian scale lighting along portions of the multi-use trail. The water quality/detention pond will be landscaped and maintained as an open space amenity area.

The Petitioner will provide three (3) "Pedestrian Access Plazas" and one (1) "Pedestrian Access" into the buildings constructed within Development Area A in the locations generally depicted on Sheet RZ-4 of the Rezoning Plan. The Pedestrian Access Plazas will be designed as significant pedestrian access points and focal features of that portion of the development. The Pedestrian Access Plazas and Pedestrian Accesses will be improved with special architectural treatments and high quality building materials. The Pedestrian Access Plazas will include features such as but not limited to; water features, windows, specially graphics, landscaping, specialty paying, high quality EIFS, seating areas, signage, art work and other site elements that help create a vibrant entrance, substantially in the manner depicted on Sheets RZ-5a and RZ-5b. Portions of the Pedestrian Accesses and Plazas and Pedestrian Accesses may be used for outdoor dining associated with restaurants.

The Petitioner may provide a playground or "play bay" area especially designed for children within Development Area A substantially in the manner depicted on Sheet RZ-5a of the Rezoning Plan.

d. The open space area surrounding the water quality/storm water detention pond will be improved as an amenity area as part of phase one of the development.

<u>\*</u> Signage as allowed by the Ordinance and the Optional Provisions listed above may be provided. The Site will be viewed as a Planned Development as defined by the Ordinance

a. All new lighting shall be full cut-off type lighting fixtures excluding lower, decorative lighting that may be installed along the driveways, sidewalks, and parking areas.

b. Detached lighting on the Site will be limited to 30 feet in height. No "wall pak" lighting will be allowed, however architectural lighting on building facades, such as sconces, will be permitted and in loading dock areas or at the rear of the buildings

nsequently Shopping Center signs may be located throughout the Site as allowed by the Ordinance or by the Optional Provisions above. The allowed signs may contain business and

a. The Petitioner will provide a bus stop shelter and waiting pad along the internal public street in the location generally depicted on the Sheet RZ-2.

12. Miscellaneous:

dentification signage for any of the businesses or tenants located on the Site.

where "wall pak" lighting that is designed as down lighting will be allowed.

13. Amendments to the Rezoning Plan

b. The Petitioner reserves the right to request a modification to the required internal public/private streets through the Alternative Compliance provisions of the Subdivision Regulations

a. Future amendments to the Rezoning Plan (which includes these Development Standards) may be applied for by the then Owner or Owners of the applicable Development Area

portion of the Site affected by such amendment in accordance with the provisions herein and of Chapter 6 of the Ordinance. 14. Binding Effect of the Rezoning Application:

a. If this Rezoning Petition is approved, all conditions applicable to the development of the Site imposed under the Rezoning Plan will, unless amended in the manner provided herein and under the Ordinance, be binding upon and inure to the benefit of the Petitioner and subsequent owners of the Site and their respective heirs, devisees, personal representatives,

Section A Avenue Proposed R.O.W.

TRAFFIC FIGURES - LANEAGE RCMSKINS: 1, 60/13/12 fatt, por marships 2, 03/21/13 Rev. per marships Figure 11a 2012 (CDOT) RECOMMENDED LANEAGE Prop. 2-Lane Roundabout REVISIONS: 1, 00/12/13 Rev. per excellego 2, 00/19/13 Rev. per excellego

1SIONS: 1221.12 - REVISE PER STAFF C 03.06.13 - REVISE PER STAFF C 03.15.13 - REVISE PER STAFF C

# OVERALL EXTERIOR ELEVATION BOARD - CONCEPTUAL RENDERINGS

1.14.2013

### WEST ELEVATION



**BUILDING 03** 

### SOUTH ELEVATION



EAST ELEVATIONS: FACING I-485



EAST ELEVATIONS: FACING I-485




## NORTH ELEVATIONS

### NOTE:

ARCHITECTURE WILL INCLUDE A MIXTURE OF VARIED PARAPET HEIGHTS, SHINGLE AND STANDING SEAM ROOFING, BALUSTRADE, DECORATIVE RELIEFS, TRELLIS AND A VARIETY OF WINDOW, DOOR AND ADVERTISING OPENINGS/ PANELS, MODULATED BUILDING FRONTAGES AND AWNINGS TO CREATE VISUAL INTEREST AS ILLUSTRATED ON THIS SHEET.



STEELE CI REZONING I STEELE CREEK (1997) CONCEPTUAL A

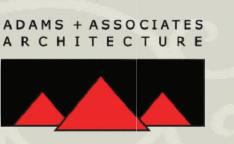



BUILDING 02 "FRONT DOOR"







## NOTE:

ARCHITECTURE WILL INCLUDE A MIXTURE OF VARIED PARAPET HEIGHTS, SHINGLE AND STANDING SEAM ROOFING, BALUSTRADE, DECORATIVE RELIEFS, TRELLIS AND A VARIETY OF WINDOW, DOOR AND ADVERTISING OPENINGS/ PANELS, MODULATED BUILDING FRONTAGES AND AWNINGS TO CREATE VISUAL INTEREST AS ILLUSTRATED ON THIS SHEET.

