

- a. ÚNĽESS OTHER STANDARDS ARE ESTABLISHED BY THE REZONING PLAN OR THESE DEVELOPMENT STANDARDS, ALL DEVELOPMENT STANDARDS ESTABLISHED UNDER THE CITY OF CHARLOTTE ZONING ORDINANCE (THE "ORDINANCE") FOR THE INSTITUTIONAL ZONING DISTRICT SHALL BE FOLLOWED IN CONNECTION WITH THE DEVELOPMENT TAKING PLACE ON
- b. THE DEVELOPMENT DEPICTED ON THIS PLAN IS INTENDED TO REFLECT THE ARRANGEMENT OF PROPOSED USES ON THE SITE, BUT THE EXACT CONFIGURATION, PLACEMENT, AND SIZE OF INDIVIDUAL SITE ELEMENTS MAY BE ALTERED OR MODIFIED WITHIN THE LIMITS PRESCRIBED BY THE ORDINANCE DURING THE DESIGN DEVELOPMENT AND CONSTRUCTION PHASE.
- c. THE PETITIONER ACKNOWLEDGES THAT OTHER STANDARD DEVELOPMENT REQUIREMENTS IMPOSED BY OTHER CITY ORDINANCES, SUCH AS THOSE THAT REGULATE STREETS, SIDEWALKS, TREES, AND SITE DEVELOPMENT, MAY APPLY TO THE DEVELOPMENT OF THIS SITE. THESE ARE NOT ZONING REGULATIONS, ARE NOT ADMINISTERED BY THE ZONING ADMINISTRATOR, AND ARE NOT SEPARATE ZONING CONDITIONS IMPOSED BY THIS SITE
- CHANGES TO THE REZONING PLAN WILL BE REVIEWED AND APPROVED AS ALLOWED BY **SECTION 6.207 OF THE ORDINANCE.**

- 🖟 a.` THE SITE WILL BE DEVELOPED TO ADD A 2-STORY EVENTS BUILDING AND THREE (3) SMALLER 📈 BREAK-OUT ROOM FACILITIES AS ALLOWED BY THE USES PERMITTED UNDER SECTION 9.502(3.1) OF THE ORDINANCE FOR A CONFERENCE CENTER, INCLUDING FACILITIES FOR CORPORATE MEETINGS, TRAINING, RETREATS, OR OTHER MEETINGS.
- 'b. THE PROPOSED BUILDINGS ON THE SITE WILL SATISFY OR EXCEED THE SETBACK, SIDE YARD, REAR YARD, SCREENING AND BUFFER REQUIREMENTS ESTABLISHED UNDER THE ORDINANCE.

c. THE EXISTING USE OF THE SITE WILL BE PRESERVED. PROPOSED SITE IMPROVEMENTS AND NEW EVENTS BUILDING & MEETING SPACE BUILDINGS WILL SUPPORT THE EXISTING CONFERENCE CENTER UTILIZING THE EXISTING MANOR HOUSE AND RETREAT CENTER BUILDING.

### 4. TRANSPORTATION

- a. PARKING LAYOUT IS GENERAL AND WILL BE MODIFIED TO SAVE EXISTING TREES.
- b. PARKING, BOTH ON-SITE AND OFF-SITE, WILL PROVIDED WHICH WILL MEET OR EXCEED THE STANDARDS OF THE ZONING ORDINANCE. ON-SITE PARKING WILL BE LOCATED SO AS TO MINIMIZE THE NEED TO REMOVE TREES FROM THE SITE. IT IS THE PETITIONER'S INTENT TO LOCATE THE PARKING WITHIN EXISTING GRAVEL ROADBED IN SMALL PODS SCATTERED AMONG THE TREES SO AS TO MINIMIZE THE OVERALL IMPACT AND TO PRESERVE AS MANY OF THE LARGE TREES AS POSSIBLE. THE PETITIONER WILL CONSULT WITH THE URBAN FORESTRY STAFF AS TO THE DETAILS OF THE PARKING LAYOUT AND IT'S RELATIONSHIP TO TREES AND THEIR ROOT ZONES. SOME TREES MAY NEED TO BE REMOVED, BUT THE TREES NOTED ON THE SITE PLAN LOCATED AWAY FROM PARKING AND DRIVE AISLES AND BUILDING AREAS WILL BE PRESERVED. PAVED PORTIONS OF OLD DRIVEWAYS THAT ARE NOT TO BE USED WILL BE
- c. THE OPERATION OF THE CONFERENCE CENTER ON THE SITE WILL SCHEDULE ACTIVITIES, SUCH AS CONFERENCES/MEETINGS, SO AS TO AVOID PEAK TRAFFIC HOURS AND WILL COORDINATE WITH PROVIDENCE DAY SCHOOL TO MITIGATE IMPACTS ON SCHOOL ACTIVITIES.

## 5. ARCHITECTURAL STANDARDS

(INVERT ELEVATION NOT FIELD MEASURED DURING THIS SURVEY DUE TO SAFETY ISSUES, BUT, RATHER IS BASED ON INFORMATION

TAKEN FROM C.M.U. AS-BUILT PLANS)

- ( a. THE PETITIONER SHALL ENSURE THAT THE PROPOSED DESIGN AND PLACEMENT OF THE PROPOSED STRUCTURES, ALONG WITH THE BUILDING MATERIALS, WILL SERVE TO ENHANCE  ${\cal J}$ THE EXISTING STRUCTURES AND THE OVERALL CHARACTER, OF THE SITE. A A A A A A A A A
- b. THE PROPOSED EVENTS CENTER AND MEETING SPACES WILL BE DESIGNED TO COMPLEMENT THE EXISTING MANOR HOUSE. DESIGN ELEMENTS SUCH AS PORCHES, BALCONIES, DORMERS, CLERESTORIES, AND ROOF LINES WILL BE INCORPORATED INTO THE DESIGN. THE FOOTPRINT AND MASSING OF THE PROPOSED BUILDINGS MAY BE ADJUSTED TO REDUCE THE IMPACT ON
- C. OWNER WILL CONSULT WITH THE LANDMARKS COMMISSION STAFF CONCERNING THE POTENTIAL HISTORIC DESIGNATION OF THE PROPERTY AND THE ARCHITECTURE OF THE
- PROPOSED BUILDINGS FOR THE RETREAT CENTER. d. DUMPSTERS ARE PROHIBITED. ROLLOUT CONTAINERS SCREENED WITH GATED ENCLOSURE TO

### 6. STREETSCAPE AND LANDSCAPING

- a. A CLASS C BUFFER WILL BE PROVIDED PER SECTION 12.302 AS NOTED ON THE SITE PLAN.
- b. EXISTING TREES TO BE PRESERVED WILL HAVE "TREE PROTECTION FENCING" PLACED AROUND THEIR DRIP LINES TO PREVENT DISTURBANCES TO ROOT ZONES DURING ALL PHASES OF CONSTRUCTION. OWNER TO RETAIN ARBORIST/HORTICULTURIST TO PREPARE A PROTECTION PLAN FOR TRESS TO BE SAVED.
- b. BUFFER AREAS REQUIRED BY THE ZONING ORDINANCE WILL BE DEVELOPED IN ACCORDANCE WITH SECT. 12.302. BUFFERS WILL NOT BE REDUCED.
- c. SCREENING WILL CONFIRM TO THE APPLICABLE STANDARDS OF SECT. 12.303 OF THE ZONING
- d. ON-SITE PARKING AND LOADING AREAS WILL BE SCREENED PER SECTION 12.303.

d. PROPOSED ZONING INST. (CD) SPA (TO APPROVE ADDITIONAL BUILDINGS AND SITE IMPROVEMENTS)

e-1. EXISTING CONFERENCE CENTER "MANOR HOUSE" = 2 OFFICES, ADMINISTRATION SPACE, LOUNGE, RESTROOMS, BREAKOUT ROOMS

4,059 SQ. FT.

14 SPACES (1 SPACE PER 300 SQ. FT.)

EXISTING RETREAT CENTER - 1 OFFICE/ ADMINS., LOUNGE, RESTROOMS, LARGE ASSEMBLY SPACE,

27 SPACES (1 SPACE PER 4 PEOPLE) e-3. PROPOSED 2-STORY EVENTS BUILDING/- RĚSTROOMS, ĽAŘGĚ AŠŞEMBLY ŠPÁCE, BŘEAK-OUT ROOMS TOTAL SQ. FT. OF LARGE ASSEMBLY SPACE 4,800 SQ. FT. MAXIMUM (15 sf/ PERSON = 320 PEOPLE)

**80 SPACES (1 SPACE PER 4 PEOPLE)** e-4. PROPOSED 1-STORY BREAK OUT MEETING SPACE A'

540 SQ. FT. MAXIMUM

540 SQ. FT. MAXIMUM (15 sf/ PERSON = 34 PEOPLE)

300 SQ. FT. MAXIMUM (15 sf/ PERSON = 20 PEOPLE)


h. , FLOQR AREA RATIO 🚬 11,859 SQ. FT. / 2.69 ACRES (117,200 SQ. FT.) = 0.1

20FT.

20FT. 121 SPACES **41 SPACES EXISTING ON-SITE PARKING** 

> **80 SPACES MIN.** PROPOSED OFF-SITE PARKING - OFF-SITE PARKING WITH A SHARED PARKING AGREEMENT - OFF-SITE PARKING WITH A FIVE YEAR LEASE AGREEMENT

**41 SPACES** 

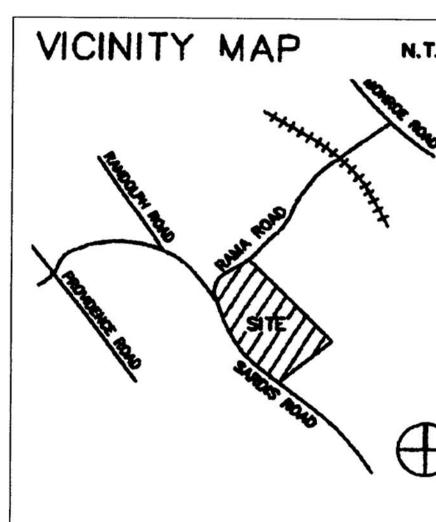

## 7. ENVIRONMENTAL FEATURES

a. THE PETITIONER SHALL COMPLY WITH THE CHARLOTTE CITY COUNCIL APPROVED AND ADOPTED POST CONSTRUCTION CONTROLS ORDINANCE.


## 8. SIGNAGE

a. SIGNAGE WILL BE PERMITTED IN ACCORDANCE WITH APPLICABLE ZONING STANDARDS. THE EXACT LOCATION OF THE SITE SIGNAGE WILL BE DETERMINED AS PART OF THE DETAILED CONSTRUCTION AND LANDSCAPING PLANS FOR THE SITE. DETACHED SIGNAGE TO BE THREE FEET IN HEIGHT AND 24 SQUARE FEET IN AREA. BUILDING SIGNS MUST BE PROHIBITED.

- a. THROUGHOUT THIS REZONING PETITION, THE TERMS "OWNER", "OWNERS", OR "PETITIONER" SHALL, WITH RESPECT TO THE SITE, BE DEEMED TO INCLUDE THE HEIRS, DEVISEES, PERSONAL REPRESENTATIVES, SUCCESSORS IN INTEREST AND ASSIGNEES OF THE OWNER OR OWNERS OF
- THE SITE WHO MAY BE INVOLVED IN ITS DEVELOPMENT FROM TIME TO TIME. b. THE THREE (3) PROPOSED ONE-STORY "BREAK OUT MEETING SPACES" (LABELED "A", "B" AND "C" ON THIS REZONING PLAN) ARE DESIGNATED BREAK OUT SPACES FOR EVENTS ASSOCIATED. WITH THE EVENTS BUILDING, RETREAT CENTER OR MANOR HOUSE ON THE SITE AND WILL ONLY BE USED BY THE SAME TENANTS OCCUPYING THESE LARGER BUILDINGS. BREAK OUT SPACES WILL NOT BE LEASED SEPARATELY FOR DIFFERENT EVENTS.



This drawing and the design shown are the property of Neighboring Concepts, PLLC The reproduction, copying, or other use of this drawing without their written consent is prohibited and any infringement will be subject to

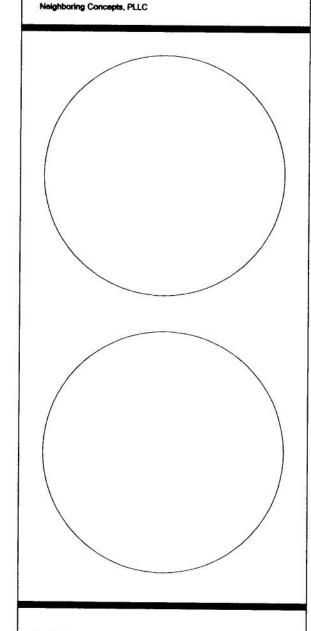

# WHITEHEAD **MANOR** RETREAT **CENTER**

FILE NO.

Issue Date: SEP 20, 2013

I.N.I, Checked: I.N.I.

NOVEMBER 15, 2013

Rev. 2 Date:

Rev. 3 Date:

Rev. 4 Date:

PETITION NO. 2013-099

**REZONING PLAN**