1603BASE.DWG

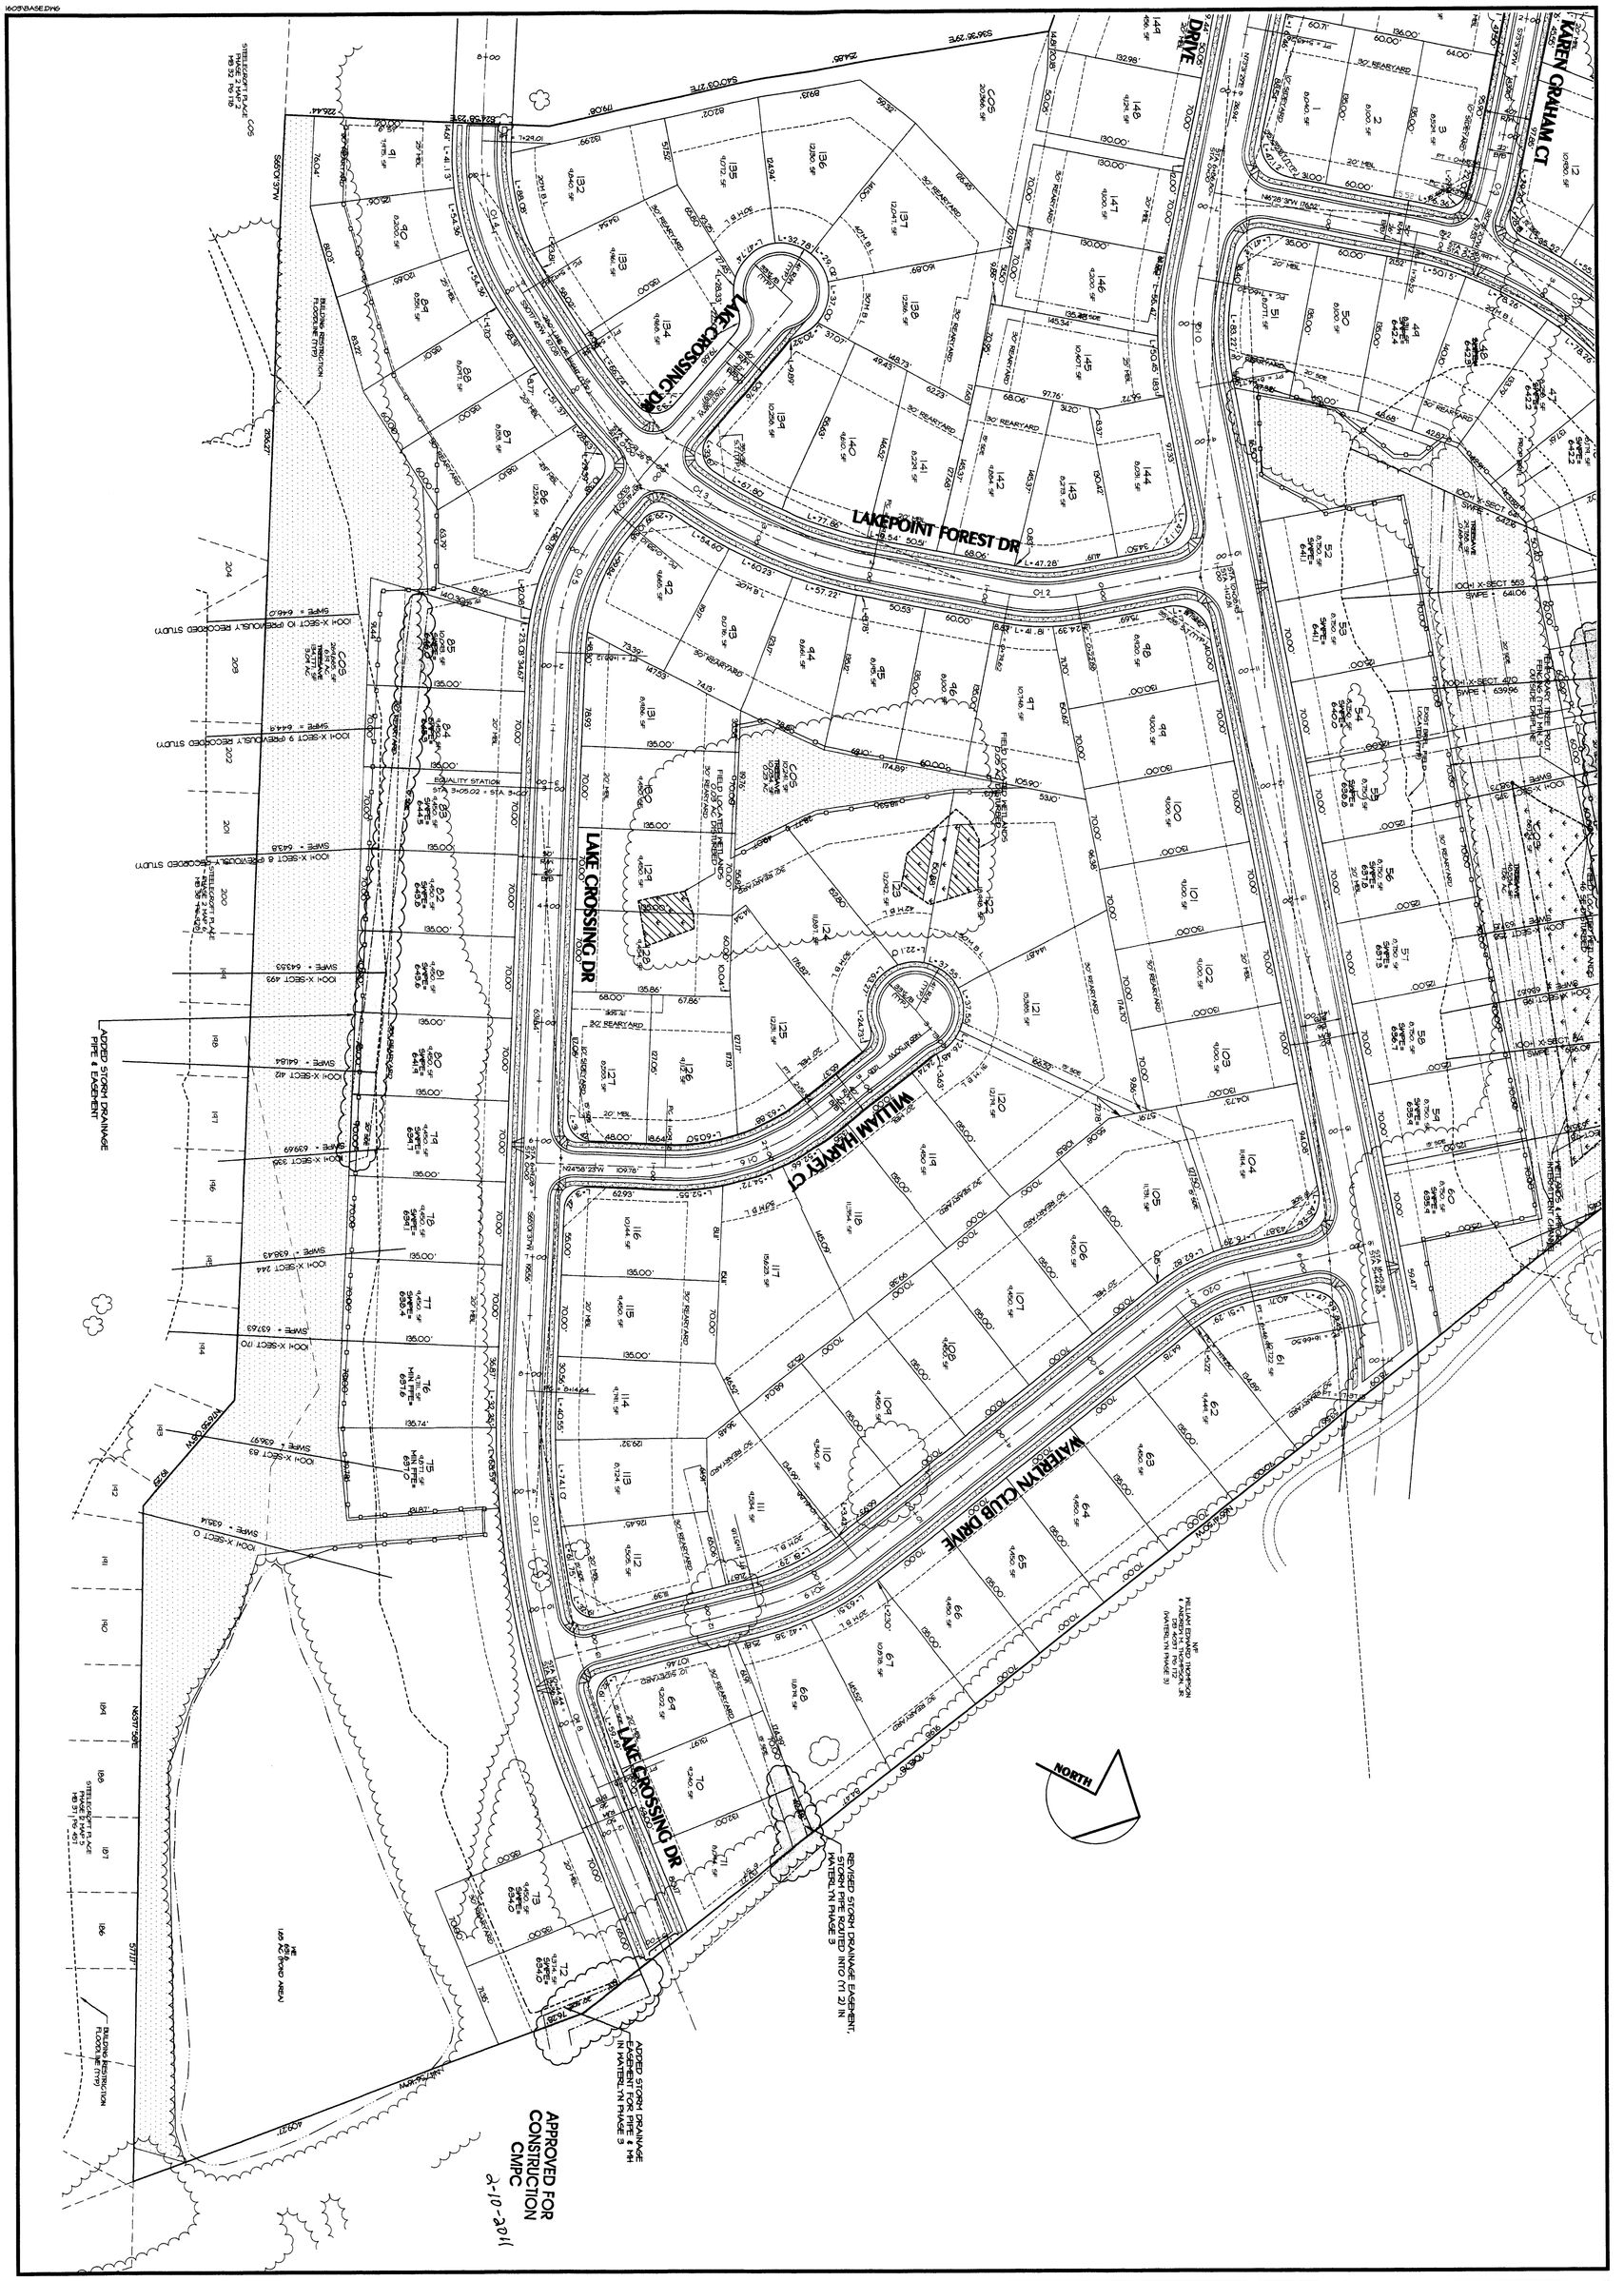

Sheet No. 3 of 15

Preliminary Subdivision Site Plan

WaterLyn

Steele Creek Township, Mecklenburg County, North Carolina
HTL Development, 2716 Westport Road, Charlotte, NC 28208

Scale:	1"=60'
Date:	11/30/03
Drawn By:	MJK
Designed By:	MJK
Job No.:	1603

NORTH CAROLINA PROFESSIONAL SEAL 4608 SURVEYOR MICHAEL J. KENNEY 4/15/05

Revisions:
1. 2/4/04 REVISED PER CMPC, CED & CDOT REVIEW COMMENTS
2. 3/24/04 REVISED PER CMPC, CED & CDOT REVIEW
3. 11/7/05 REMOVED LOT 74 AND SOME TREESAVE FOR CLUB SITE
4. 10/10/07 REVISE PER STORM DRAINAGE AS-BUILTS
5. 4/07/08 REVISE PER STORM DRAINAGE REVISIONS AND AS-BUILTS

KENNEY DESIGN GROUP, PA
Engineering
Land Planning
Land Surveying
1316 GREENWOOD CLIFF
CHARLOTTE, NORTH CAROLINA 28204
PH: 704/377-6099 FAX: 704/377-6097
EMAIL: KENNEY@VNET.NET