(IN FEET)

1 inch = 50 ft.

REPLACE THE PREVIOUSLY SUBMITTED

SCHEMATIC SITE PLAN (12-07-05)

VICINITY MAP

Live Oaks **DEVELOPMENT STANDARDS**

General Provisions

These Development Standards form a part of the Technical Data Sheet associated with the Rezoning Petition filed by Live Oak Development Partnership, LLC, representing the Housing Authority of the City of Charlotte (the "Petitioner"). This rezoning Petition and accompanying plan/1 seeks to accommodate the development of a mixed use center on the approximate 4.91 acre site 7. Storm Water Management bounded and accessed by way of Savings Place via Fairview Road from the north (the "Site"). Development of the site will be governed by the Technical Data Sheet, these Development Standards, and the applicable provisions of the Zoning Ordinance of the City of Charlotte (the "Ordinance"). Unless the Technical Data Sheet or these Development Standards establish more stringent standards, the regulations established under the Ordinance for the Mixed Use
Development District – Optional (MUDD-O) zoning district classification together with the optional provisions provided herein, shall govern all development taking place on the Site.

The Technical Data Sheet is accompanied by a development scheme which depicts potential development scenarios for the Site. This plan is referred to as the Schematic Site Plan. Detailed site planning and building design for the Site has not been finalized. The development scenario depicted on the Schematic Site Plan is intended to reflect a potential arrangement of proposed uses and elements on the Site. The exact placement, configuration, and size of the uses and elements may be altered during the design development and construction document phases of the project without further zoning approvals provided such altered design is within the limits described by this Technical Data Sheet, accompanying Development Standards, and the provisions of the Ordinance.

1. Permitted Uses

The Site may be devoted to any uses which are permitted by right or under prescribed conditions (together with any incidental or accessory uses and structures associated therewith) which are permitted under the Ordinance in the MUDD-Ozoning district classification, together with the optional provisions provided herein. These uses may include residential and retail uses to the densities and limitations as described and set forth within these Development Standards.

2. Maximum Building Areas and Limitations:

- The Site may include up to 248 Multi-Family Residential Units, and a maximum total of 12,000 of Retail together with associated surface parking, parking structures and other ancillary facilities such as marketing and leasing offices to serve the development occurring on the Site. The areas of development within the Site will be depicted on the Technical Data Sheet, and described as Development Zone "A" and Development Zone "B", with the following uses:
 - Development Zone A: Up to 50 Multi Family Residential Units Surface Parking, Parking Structure, and ancillary service and access areas

Development Zone B: Up to 198 Multi Family Residential Units Up to 12,000 sf of Retail Surface Parking, Parking Structure, and ancillary service and

access areas

- b. The Petitioner reserves the right to modify maximum square footage and residential units indicated within the respective Development Zones through administrative approval of Planning Staff, however will not exceed the maximum Multi Family Units and Retail development area as described for the total Site.
- c. Up to three independent, disconnected buildings may be developed on the Site, however the primary use of any building developed on the Site will be Residential. d. Retail Uses will be located primarily along the ground floor street or drive frontage of the development.

~~~~~ 3. Setbacks and Yards

 $\sim\sim\sim\sim\sim\sim\sim$ All buildings constructed within the Site shall satisfy or exceed the setback, rear yard and side yard requirements established under the Ordinance for the MUDD zoning district; provided, that the Site may be viewed as a unified development plan so that yards will not be required between buildings (or any other improvements) on the site. The developer(s) reserve the right to subdivide the Site and create lots interior to the development with no public street frontage or side and/or rear yards as part of a unified development plan. In addition, the Site may also be viewed as a unified development plan in conjunction with the adjoining property to the west currently controlled by the Charlotte Housing Authority, and the property to the north west currently controlled by others subject to such adjoining tracts being rezoned to the MUDD-O zoning classification (all such adjoining property being more particularly described in pending rezoning Petition 2006-42), or other applicable future zoning classifications. As such, yards will not be required between buildings (or any other improvements) located on the Site or with respect to buildings (or any other improvements) located on the adjoining tracts as described.

4. Optional Development Provisions

The Petitioner hereby seeks the right through the MUDD-O process to obtain deviations from the strict application of the Ordinance as follows:

- a. In the event public streets or portions of public streets are located within the interior of the Site, or if the portions of the existing public streets are abandoned through the appropriate process and converted to private streets, and/or the proposed streets are developed as private streets, the Petitioner seeks the following Optional Provisions:
 - Allowance of diagonal parking and maneuvering between buildings and abutting public streets as generally depicted on the accompanying Schematic Site Plan A reduction in the width of the required setback along the interior street (whether public or private) from fourteen feet, to a minimum setback of 10 feet which shall include a five foot sidewalk and a five foot plating strip to accommodate the
 - planting of street trees. Use of a hammerhead turn-around design (as defined by CDOT) in lieu of a culde-sac to satisfy the transition requirements from a public street to a private street along the existing Savings Place alignment.
- The Petitioner seeks the optional provision to provide a variation from the MUDD signage provisions so as to permit the location of off-premises project identification signage at the intersection of the existing Savings Place and Fairview Road with the consent of the adjoining property owner. The Petitioner further seeks the optional provision to allow for a project identification sign to be located at the intersection of Sharon Road and the proposed access driveway running from the site to Sharon Road, and also for a maximum of two detached project identification signs within the interior of the Site. These These signs and other signs within the Site will conform to the standards as set forth in Section 13.108a, and Sections 13.108b, and Section 13.109 of the Ordinance. The Petitioner seeks the Optional Provision to allow blank building walls on those portions of buildings abutting structured parking
- The Petitioner may subdivide the Site and create lots within the interior of the of the development with no public street frontage or internal side or rear yards

5. Design and Performance Standards:

- a. All street walls will, at a minimum, conform to the requirements of Section 9.8506 part 2 paragraph a. The architectural treatment of the street level frontage of the any Parking Structure(s) that front a street will be compatible with the architectural treatments of the street level frontage of the commercial uses fronting the same street(s).

 All primary streets within the site will be open and accessible to the public
- All sidewalks within the site will be a minimum of five feet in width. The Petitioner shall provide a minimum width five foot sidewalk extending from Development area "A" (as depicted on the accompanying Technical Data Sheet) to the primary street currently depicted as Savings Place. The Multi-Family components of the Petition will meet all requirements as stated in Chapters 9 and 12 of the Charlotte City Code regarding solid waste dumpster, compactor, and recycling areas.

 Dumpster areas will be enclosed on all four sides by an opaque wall with one side being
- of a building, then the side or rear of the building may be substituted for the wall, Detached pedestrian scale light poles and fixtures will be located along the primary stree and pedestrian sidewalks and will be consistent in design and will not exceed 15 feet in height. This excludes street lighting. The maximum height of any portion of any Building developed on the Site will not exceed 65 feet in height as measured from the finished floor elevation of the first occupied floor

a hinged opaque gate. If one or more sides of a dumpster area adjoin a side or rear wall

- of the Building. The maximum height to the parapet of any Building developed on the Site will not exceed 60 feet in height as measured from the finished floor elevation of the first occupied floor of the building. On the southern facing elevation of the Multi-Family Building, full balconies will only be allowed on the first and second floors. "Juliette" balconies will be allowed on the third and fourth floors of the southern facing elevation of the Building

 All roof mounted mechanical equipment will be screened from view from adjoining public
- rights-of-way and abutting properties as viewed from grade. k. All freestanding lighting fixtures, except street lights erected along public or private streets, will be uniform in design.
- The maximum height of any freestanding lighting fixture, including its base, may not exceed 30 feet. All parking lot and roadway/driveway area lighting shall be capped and designed such that direct illumination does not extend past any exterior property line No Wal-Pak type fixtures shall be used; however, Wall-mounted decorative light fixtures such as sconces are permitted.

 n. Service areas will be screened from public view.
- n. Service areas will be screened from public view.

 o. Signage will be designed and erected in accordance with the applicable requirements of the Ordinance subject to the optional provisions described herein. On-premises directional and instructional signage will be permitted in accordance with Section 13.106 of the Ordinance.
- The development occurring on the Site will conform to the open space requirements as described in Section 9.8506 part 4. These Open Spaces may include plazas, courtyards, second floor terraces, with up to 30 percent of the required open spaces located within an enclosed ground floor level.

6. Parking:

- a. The parking and loading areas within the site will, as a minimum, satisfy the requirements of the Ordinance through a combination of on-street, surface lot, and structured parking
 - b. The Petitioner reserves the right to construct and maintain interim surface parking within the site to accommodate the parking requirements of the initial phases of the project

either inside or outside the described development zones associated with the defined

initial phase of development. The Petitioner from the right to incorporate diagonal on-street parking along the Site's primary street frontage.

a. Storm Water runoff from the site will be managed through proven techniques which satisfy the standards imposed by the City of Charlotte Ordinances and the Charlotte Mecklenburg Storm Water Design Manual, and LUESA in existence as of approval of this The Petitioner acknowledges that other standard development requirements imposed by other city ordinances, standards, policies and appropriate design manuals will exist. These criteria, for example those that regulate streets, sidewalks, trees, stormwater, and site development etc. will apply to the development of the Site. Conditions set forth in this Petition are supplemental requirements imposed on the development in addition to other standards. Where conditions on this plan differ from ordinances, standards, policies, and approaches in existence at the time of formal engineering plan review submission, the stricter condition of existing requirements shall apply. The Petitioner shall tie into the existing storm water system(s). The Petitioner shall have the receiving drainage system analyzed to ensure that it will not be taken out of standard due to the development. If it is found that that development will cause the storm drainage system to be taken out of standard, the Petitioner shall provide alternate methods to prevent this from occurring. The Petitioner shall control and treat the entire runoff volume for the post development 1 year 24 hour storm. Run off draw down time shall be a minimum of 24 hours, but not more than 120 hours. Peak storm water release rates should match pre-development rates for the 2 year and 10 year 6 hour storm events. The use of structural storm water treatment systems (wet ponds, extended detention wetlands, bio-retention) etc. shall be incorporated into the Site and designed to have an 85% average annual removal for Total Suspended Solids generated from the development according to the specifications in the most recent version of the NC Department of Environment and Natural Resources Best Management Practices Manual (Design Standards shall be met according to the City of Charlotte BMP Manual, when available). The Petitioner reserves the right to provide alternative design methods for reaching the intent of the water quality and storm water management objectives as described above, and to seek variances from NCDENR and Mecklenburg County based on demonstration of intent of the standards and alternative means of compliance. ~~~~~

8. Vehicular Access and Roadways

- a. Vehicular access to the Site shall be as generally depicted on the Technical Data Sheet. b. The placement, configurations and locations of these access points are subject to any minor modifications required to accommodate actual site and building design, and any adjustments that may be required by CDOT.
- c. The City of Charlotte Department of Transportation, along with Charlotte Mecklenburg Planning Commission Staff shall inform the Petitioner of the locations of the transitional Rights of Ways along the surrounding street frontage, the allowable curblines surrounding the Site, and the corresponding building setbacks.
- d. The Petitioner reserves the right to seek abandonment of existing portions of Savings Place, easements, alleyways, or other encumbrances within the site through quit claim procedure or other methods in order to create a compatible and integrated development. e. The Petitioner reserves the right, upon abandonment, to reconstruct all or portions of
- Savings Place as a private drive

 f. The Petitioner will provide, through the adjoining property, a private driveway and pedestrian access to Sharon Road as a part of this Petition and will acquire the required driveway permits to provide such. In the event that the adjoining property is rezoned as a part of the proposed unified development as described in Section 3, Setbacks and Yards; § the Petitioner waives responsibility to provide driveway and pedestrian access to Sharon Road with the understanding that such access will be provided by others as a part of the development of the adjoining property.
- As described in (f) above, the Petitioner will provide pedestrian access to the existing CATS stop on Sharon Road by providing access to the existing sidewalk along Sharon Road

9. Fire Protection

Adequate fire protection will be provided in accordance with the requirements of the office of the Fire Marshall and building code in existence at the time of approval of this Petition.

10. Amendments to the Rezoning Plan:

a. Future amendments to the Petition or portions thereof may be applied for by the then Owner of the Parcel or Parcels within the site in accordance with provisions of Chapter 6

11. Binding Effect of the Rezoning Documents and Definitions:

- If this Rezoning Petition is approved, all conditions applicable to the development of the Site imposed under these Development Standards and the Technical Data Sheet will, unless amended in the manner provided under the Ordinance, be binding upon and inure to the benefit of the Petitioner and the current and subsequent owners of the Site, and their respective successors in interest and assigns
- Throughout these Development Standards, the terms, "Petitioner" and "Owner" or "Owners" shall be deemed to include the heirs, devisees, personal representatives, successors in interest and assigns of the Petitioner or the Owner or Owners of the Site from time to time who may be involved with any future development thereof.

Live Oaks Property Rezoning

5815 Westpark Drive Charlotte, NC 28217

T: 704.525.6350 F: 704.561.8700

www.littleonline.com

This drawing and the design shown are the property

of Little Diversified Architectural Consulting. The

reproduction, copying or other use of this drawing

without their written consent is prohibited and any

infringement will be subject to legal action.

−© Little 2005

PROJECT TEAM
principal in charge J. Gamble, ASLA
PROJECT MANAGER C. Chastain, RLA
DRAWN BY

C. Chastain, RLA


NO. REASON

$ \Lambda $	Resubmittal Revision	1/20,

Technical Data Sheet

101.1686.00

PETITION # = 22-2006

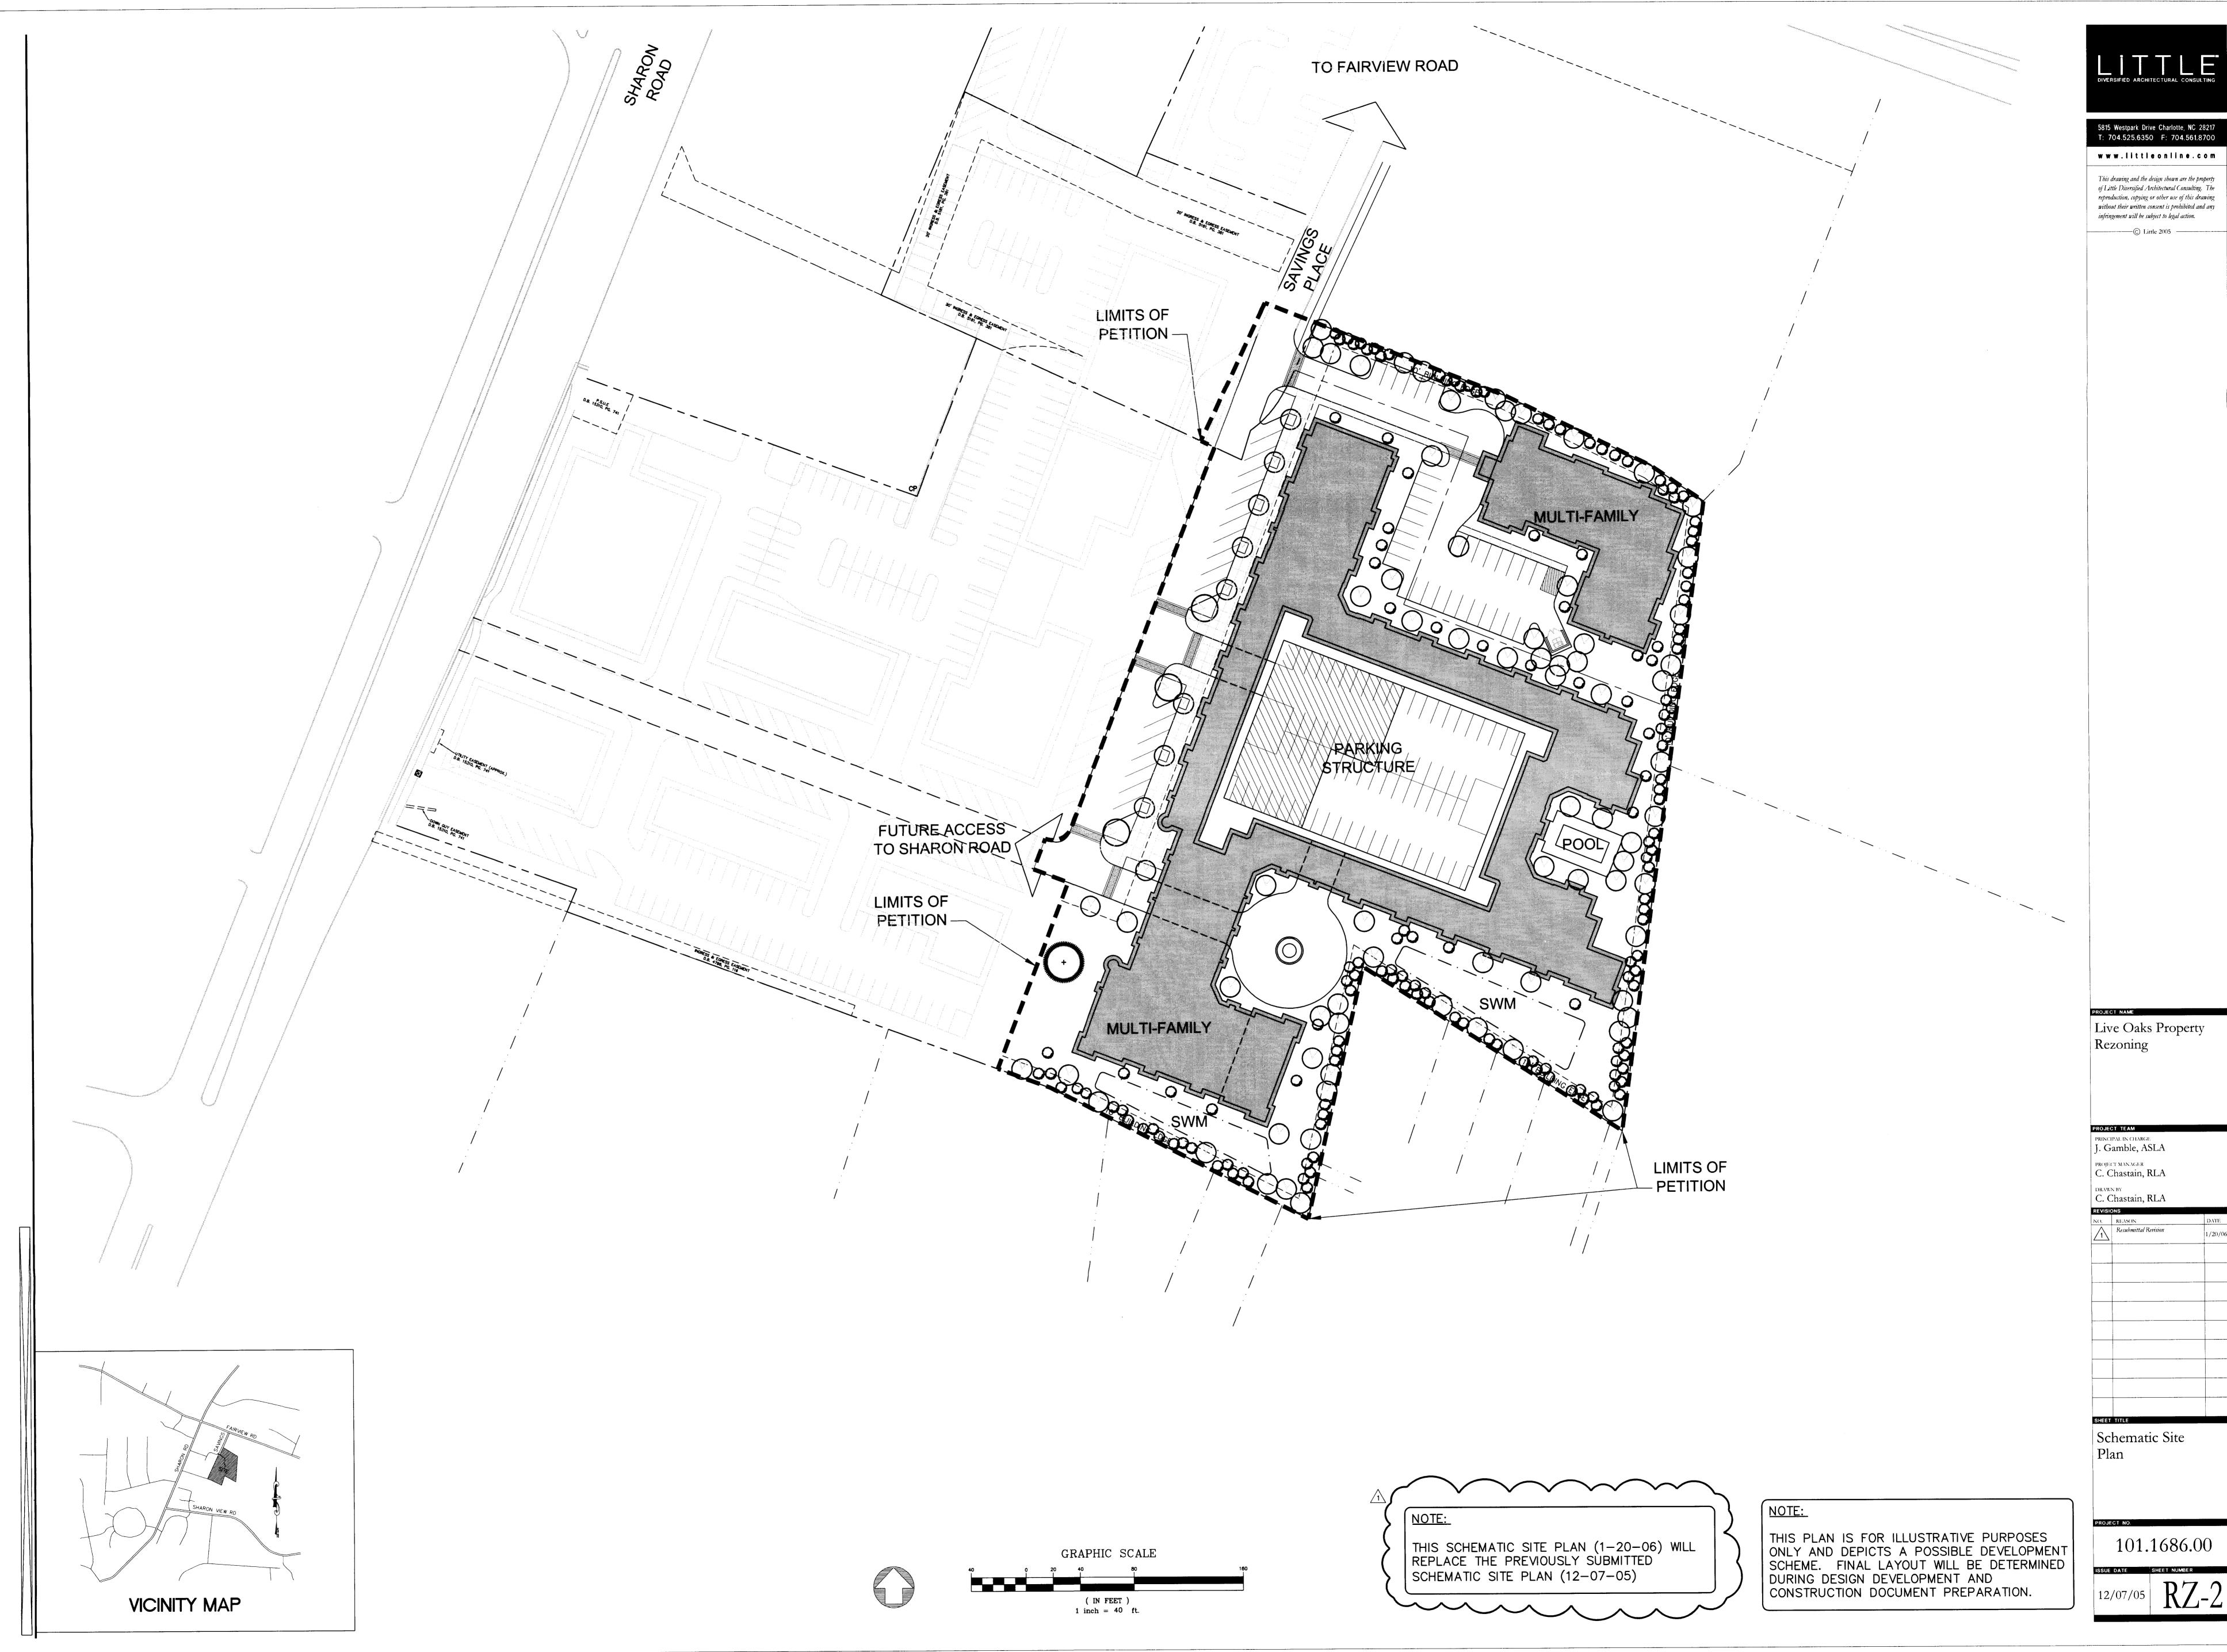

5815 Westpark Drive Charlotte, NC 28217 T: 704.525.6350 F: 704.561.8700

This drawing and the design shown are the property of Little Diversified Architectural Consulting. The reproduction, copying or other use of this drawing without their written consent is prohibited and any


Live Oaks Property Rezoning

principal in charge
J. Gamble, ASLA

C. Chastain, RLA

Schematic Site

101.1686.00

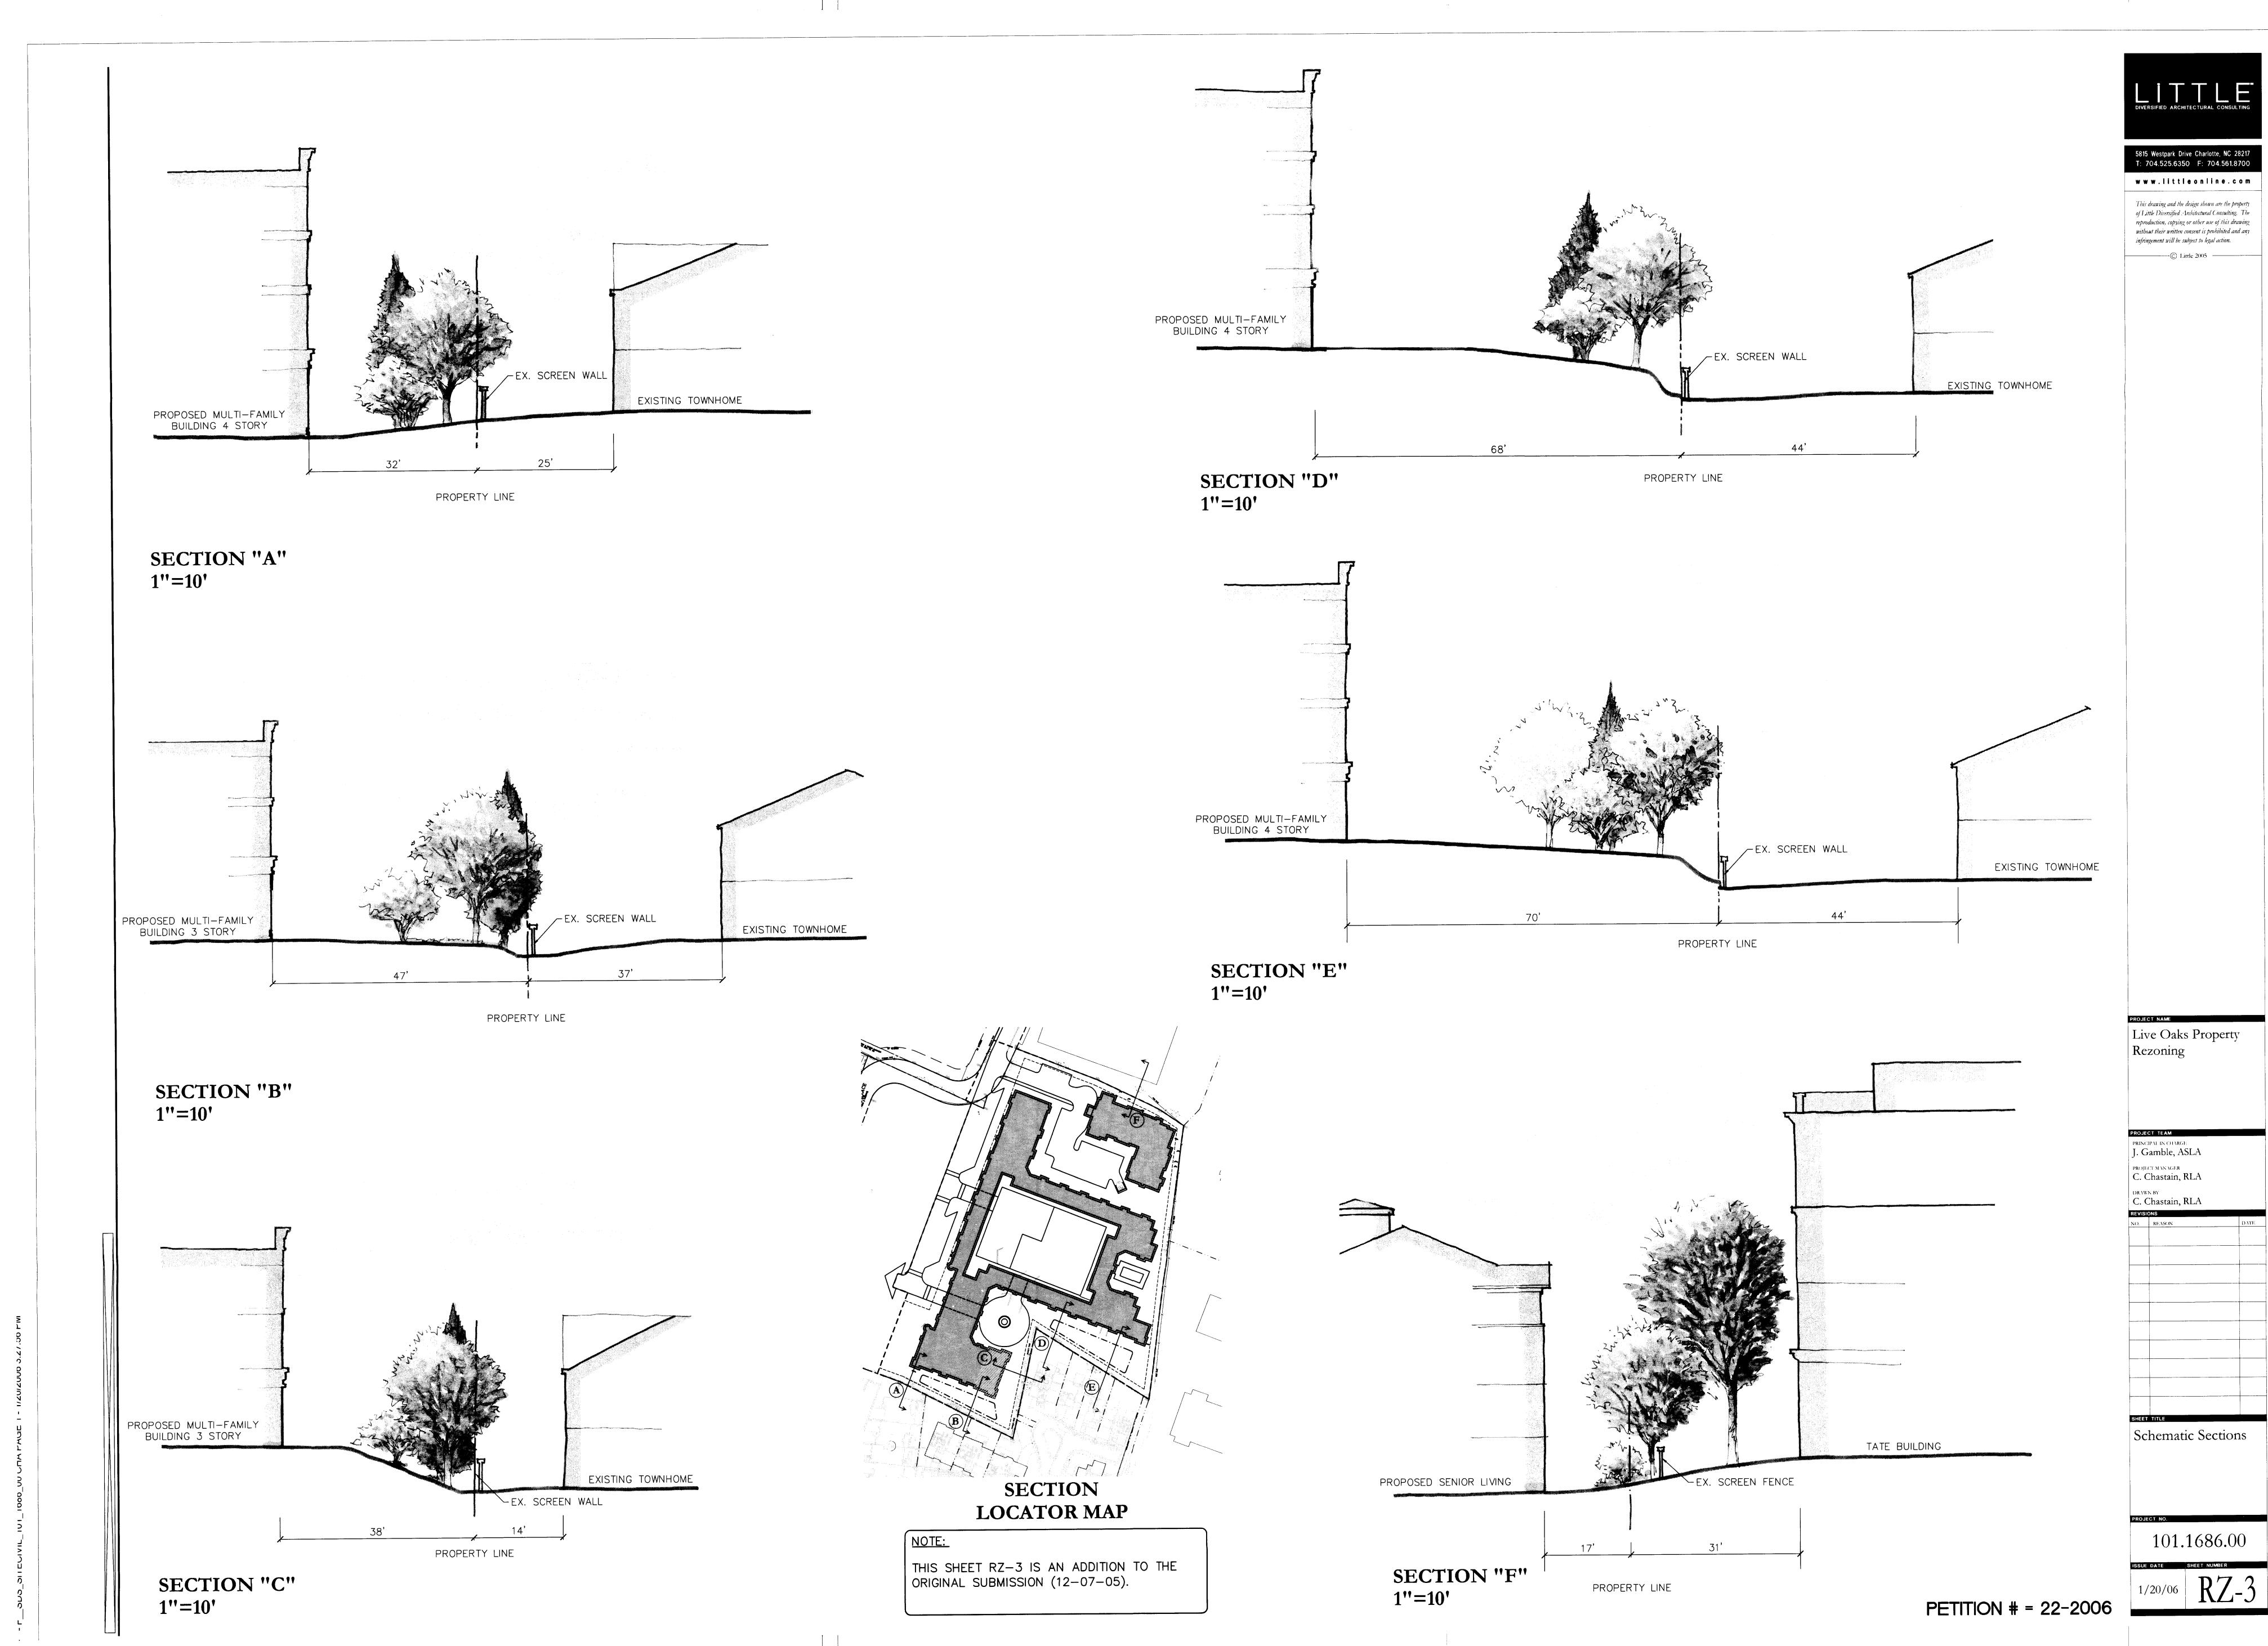




SENIOR LIVING ELEVATIONS




MULTI-FAMILY WEST ELEVATION

MULTI-FAMILY SOUTH ELEVATION

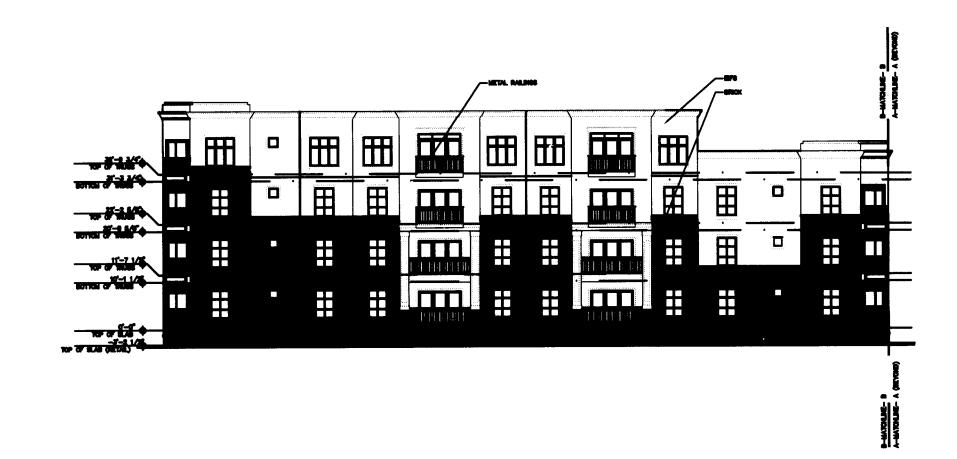

HOUSING STUDIO

MULTI-FAMILY SOUTH ELEVATION

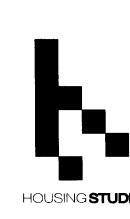

NOTE:

THIS SHEET RZ-4 IS AN ADDITION TO THE ORIGINAL SUBMISSION (12-07-05).

101.1686.00

5815 Westpark Drive Charlotte, NC 28217 : 704.525.6350 F: 704.561.8700

www.littleonline.com

This drawing and the design shown are the property of Little Diversified Architectural Consulting. The reproduction, copying or other use of this drawing without their written consent is prohibited and any infringement will be subject to legal action.

PETITION # = 22-2006

Schematic

Elevations