


						- PRELIMINARY	
							THIS DRAWING OR BILL OF MATERIAL IS
						X - FOR APPROVAL	CONFIDENTIAL AND MAY NOT BE LOANED, REPRODUCED OR COPIED, EITHER WHOLLY OR
В	03/15/10	REV. NOTE 7 PER CITY COMMENTS DATED 3/14/10	RNV	RY			IN PART, OR MADE PUBLIC IN ANY MANNER WITHOUT THE WRITTEN CONSENT OF DUKE
Α	02/15/10	REVISIONS PER CITY COMMENTS DATED 2/02/10	RNV	RY			ENERGY CORPORATION.
0	12/23/09	SUBMIT TO THE CITY OF CHARLOTTE FOR REZONING	RNV	RY		- AS BUILT	
No.	DATE	DESCRIPTION OF ISSUE OR REVISION	DR.	CK.	APP.		

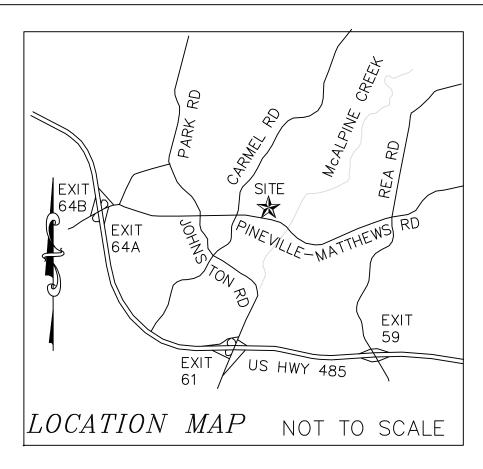

- 1. The development of the site will be controlled by the standards depicted on this site plan and by the standards of the City of Charlotte Zoning Ordinance. The development depicted by this plan is intended to reflect the general arrangement of proposed uses on the site, but the exact details of the configuration, placement and size of individual buildings and/or site elements may be altered or modified within the limits prescribed by the ordinance as specified in Section 6.206(2) as may be applicable. Minor and incidental changes of detail which do not alter the basic, overall layout and/or the relationships to abutting sites are permitted as a matter of right for the petitioner/developer.
- Vehicular points of access shall be limited to those shown on the plan. The exact 2. location may vary from that depicted, but shall comply with all applicable design/locational requirements of the Charlotte Dept. of Transportation and/or the North Carolina Dept. of Transportation.
- 3. The use proposed by this rezoning is a solar panel/array energy project by Duke Energy, which will also allow public access to the site, including educational displays and A information. All other office district uses are permitted.
- 4. Wall pack type lighting shall be prohibited.

5. No building is planned in conjunction with the proposed use. However, the site plan herein will allow a building to be erected (not shown) if later needed. The maximum size of the building shall be 1000 sq feet.

6. A 16 ft wide Class C rear yard buffer shall be established as shown (If required by THENCE WITH A { A ordinance standards).

7. The petitioner will replace the existing Bradford Pear street trees with a new small A maturing species. The petitioner shall replace the trees prior to the issuance of the driveway permit associated with this project. The new trees shall be planted 30 feet on center in the 20 foot setback.

8. The petitioner will construct a new 5-foot wide internal sidewalk that connects the Δ educational/display area with the existing sidewalk along Pineville-Matthews Rd. (See site plan for approximate location).

9. It is not anticipated that school buses will access the site and parking lot. However, in A the event that a school bus does, Duke Energy will coordinate the bus access by having the appropriate security personnel on site to allow the bus to adequately and safely maneuver in the "existing gravel drive" (beyond the new security gate in the paved parking area).

Site Data

Tax Parcel: 211-201-07 Existing Zoning: R-3 A Proposed Zoning: O-1(CD) Permitted Uses: All uses in the O-1 district Proposed Building Size (max): 1000 sq feet Site Acreage: 1.32 +/- acres (See Survey)

LEGEND

LANDSCAPE - CLASS "C" BUFFER = EP REINFORCED CONCRETE PIPE OVHD DISTRIBUTION LINE — _ ____ GV GAS VALVE (OVERHEAD) WV WATER VALVE □ REBAR WITH 3" DISK MARKED "CITY OF CHARLOTTE SURVEY MARKER" (F) ■ #4 REBAR(F) ● MAG NAIL(S) ● PK(S) WATER METER WM ▲ #5 REBAR(S) 🗃 CON. MON.(F) GW GUY WIRE SIGN ____ ☆ LIGHT POLE () MONITORING WELL \bigcirc TELECOM MANHOLE RETAIL POWER POLE СВ CATCH BASIN SANITARY SEWER MANHOLE ഭ oPt POINT NOT SET X FIRE HYDRANT WOODS LINE £3 TREES BP = BRADFORD PEAR TREEBN = RIVER BIRCH TREE

FOR PUBLIC HEARING REZONING PETITION 2010 - 20	DUKE ENERGY CORP. 526 SOUTH CHURCH ST. CHARLOTTE, NC 28202 PH. 704-382-2741 MCALPINE SUBSTATION SOLAR ARRAYS ADDITION CHARLOTTE, NC								
	7148 PI	SHEET NUMBER							
		1 OF 1							
	DATE	SCALE	DRAWN BY	CHECKED	APPROVED	REV.	DRAWING NUMBER		
	02.04.10	1" = 30'	RNV	BY		В	SP - 01		