




**O** 2459 Wilkinson Blvd, Ste 200 Charlotte, NC 28208  
**P** 704.343.0608  
**W** [www.drgrp.com](http://www.drgrp.com)

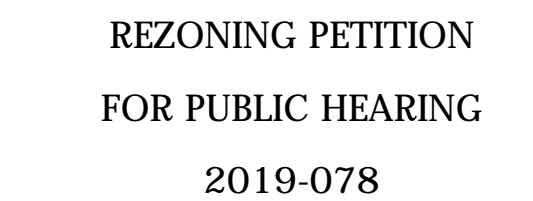

REZONING PETITION

**CHARTER PROPERTIES, INC.**  
1520 SOUTH BOULEVARD, SUITE 215  
CHARLOTTE, NC 28203  
704.377.4172

50 0 50 100  
SCALE: 1" = 100'

PROJECT #: 278-033  
DRAWN BY: JO  
CHECKED BY: NB


MAY 3, 2019

**REVISIONS:**

1. 08.12.19 PER REVIEW COMMENTS

2. 09.12.19 PER SITE UPDATES

RZ1.0

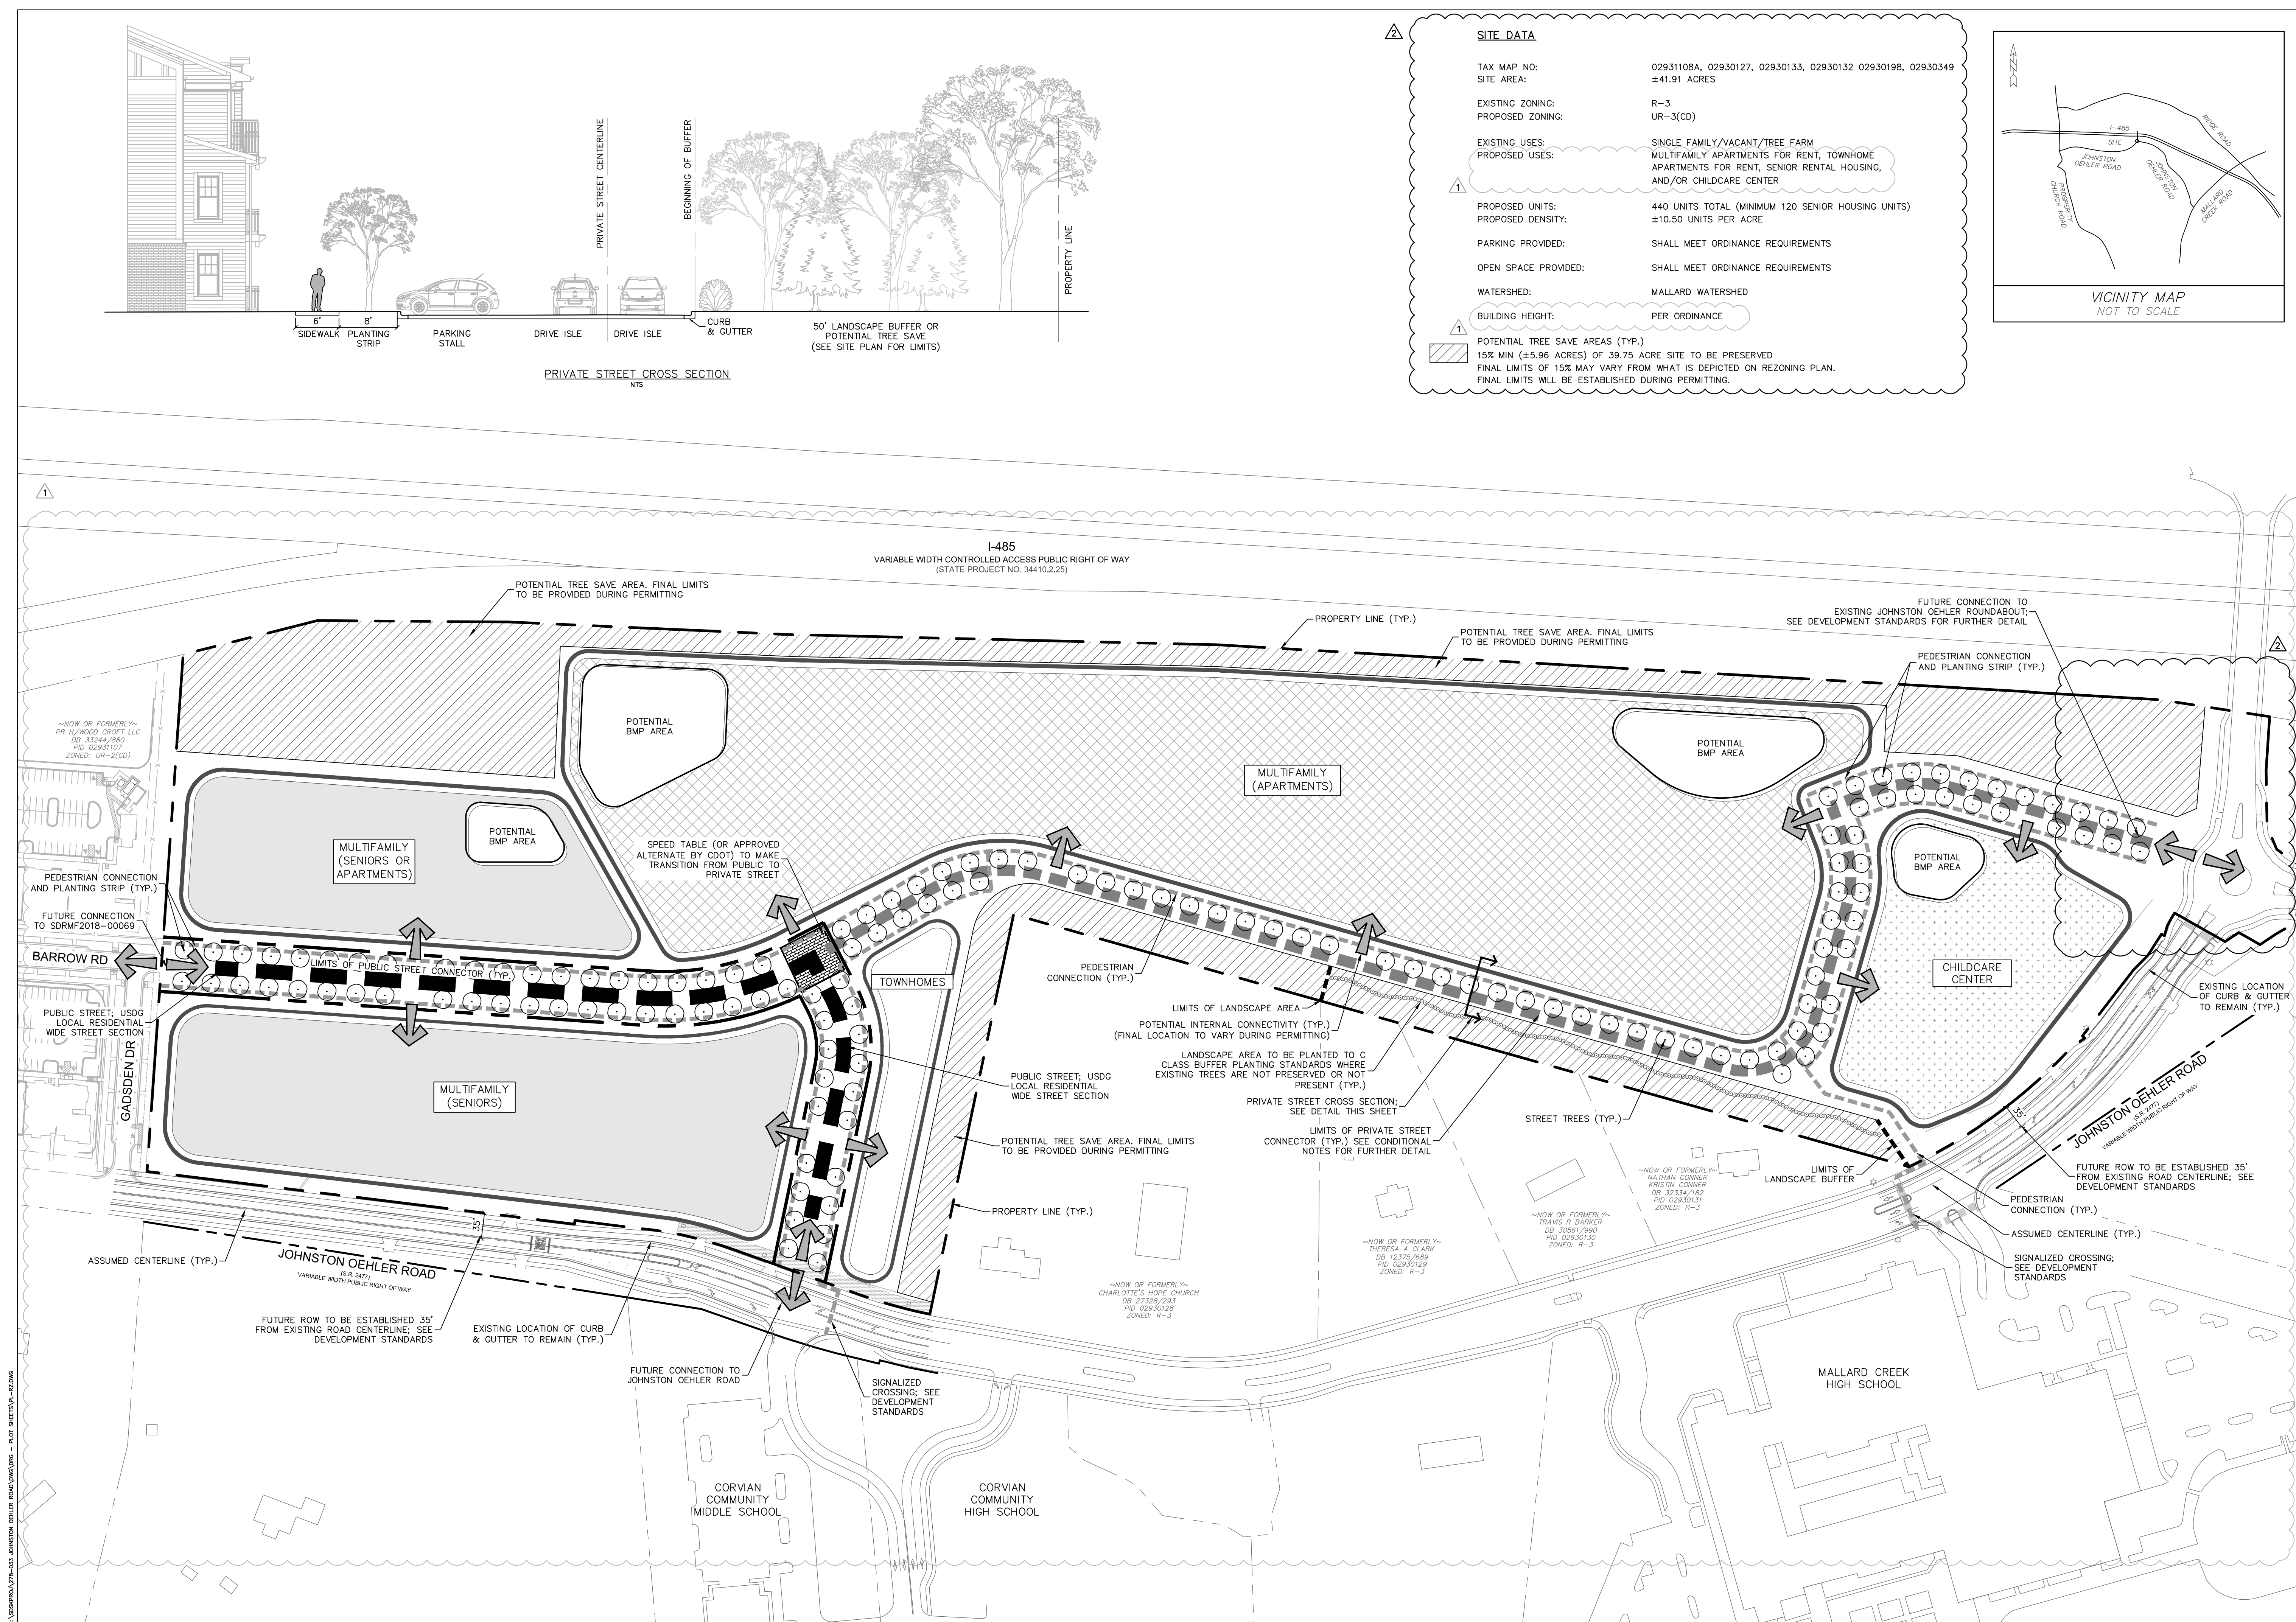

Copyright © 2019 Desian Resource Group, PA. This plan or drawing and any accompanying documents or calculations are the property of Desian Resource Group, PA; and are intended solely for the use of the recipient noted. No third party use or modification is permitted without written authorization.



Copyright © 2019 Design Resource Group, PA This plan or drawing and any accompanying documents or calculations are the property of Design Resource Group, PA; and are intended solely for the use of the recipient noted. No third party use or modification is permitted without written authorization.