


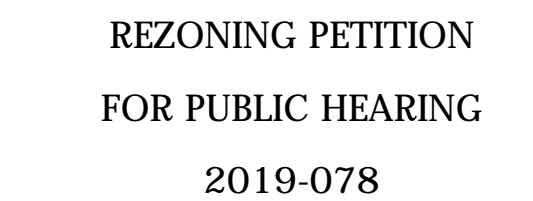

O 2459 Wilkinson Blvd, Ste 200 Charlotte, NC 28208
P 704.343.0608
W www.drgrp.com




REZONING PETITION

CHARTER PROPERTIES, INC.
1520 SOUTH BOULEVARD, SUITE 215
CHARLOTTE, NC 28203
704.377.4172


50 0 50 100
SCALE: 1" = 100'

MAY 3, 2019

RZ1.0

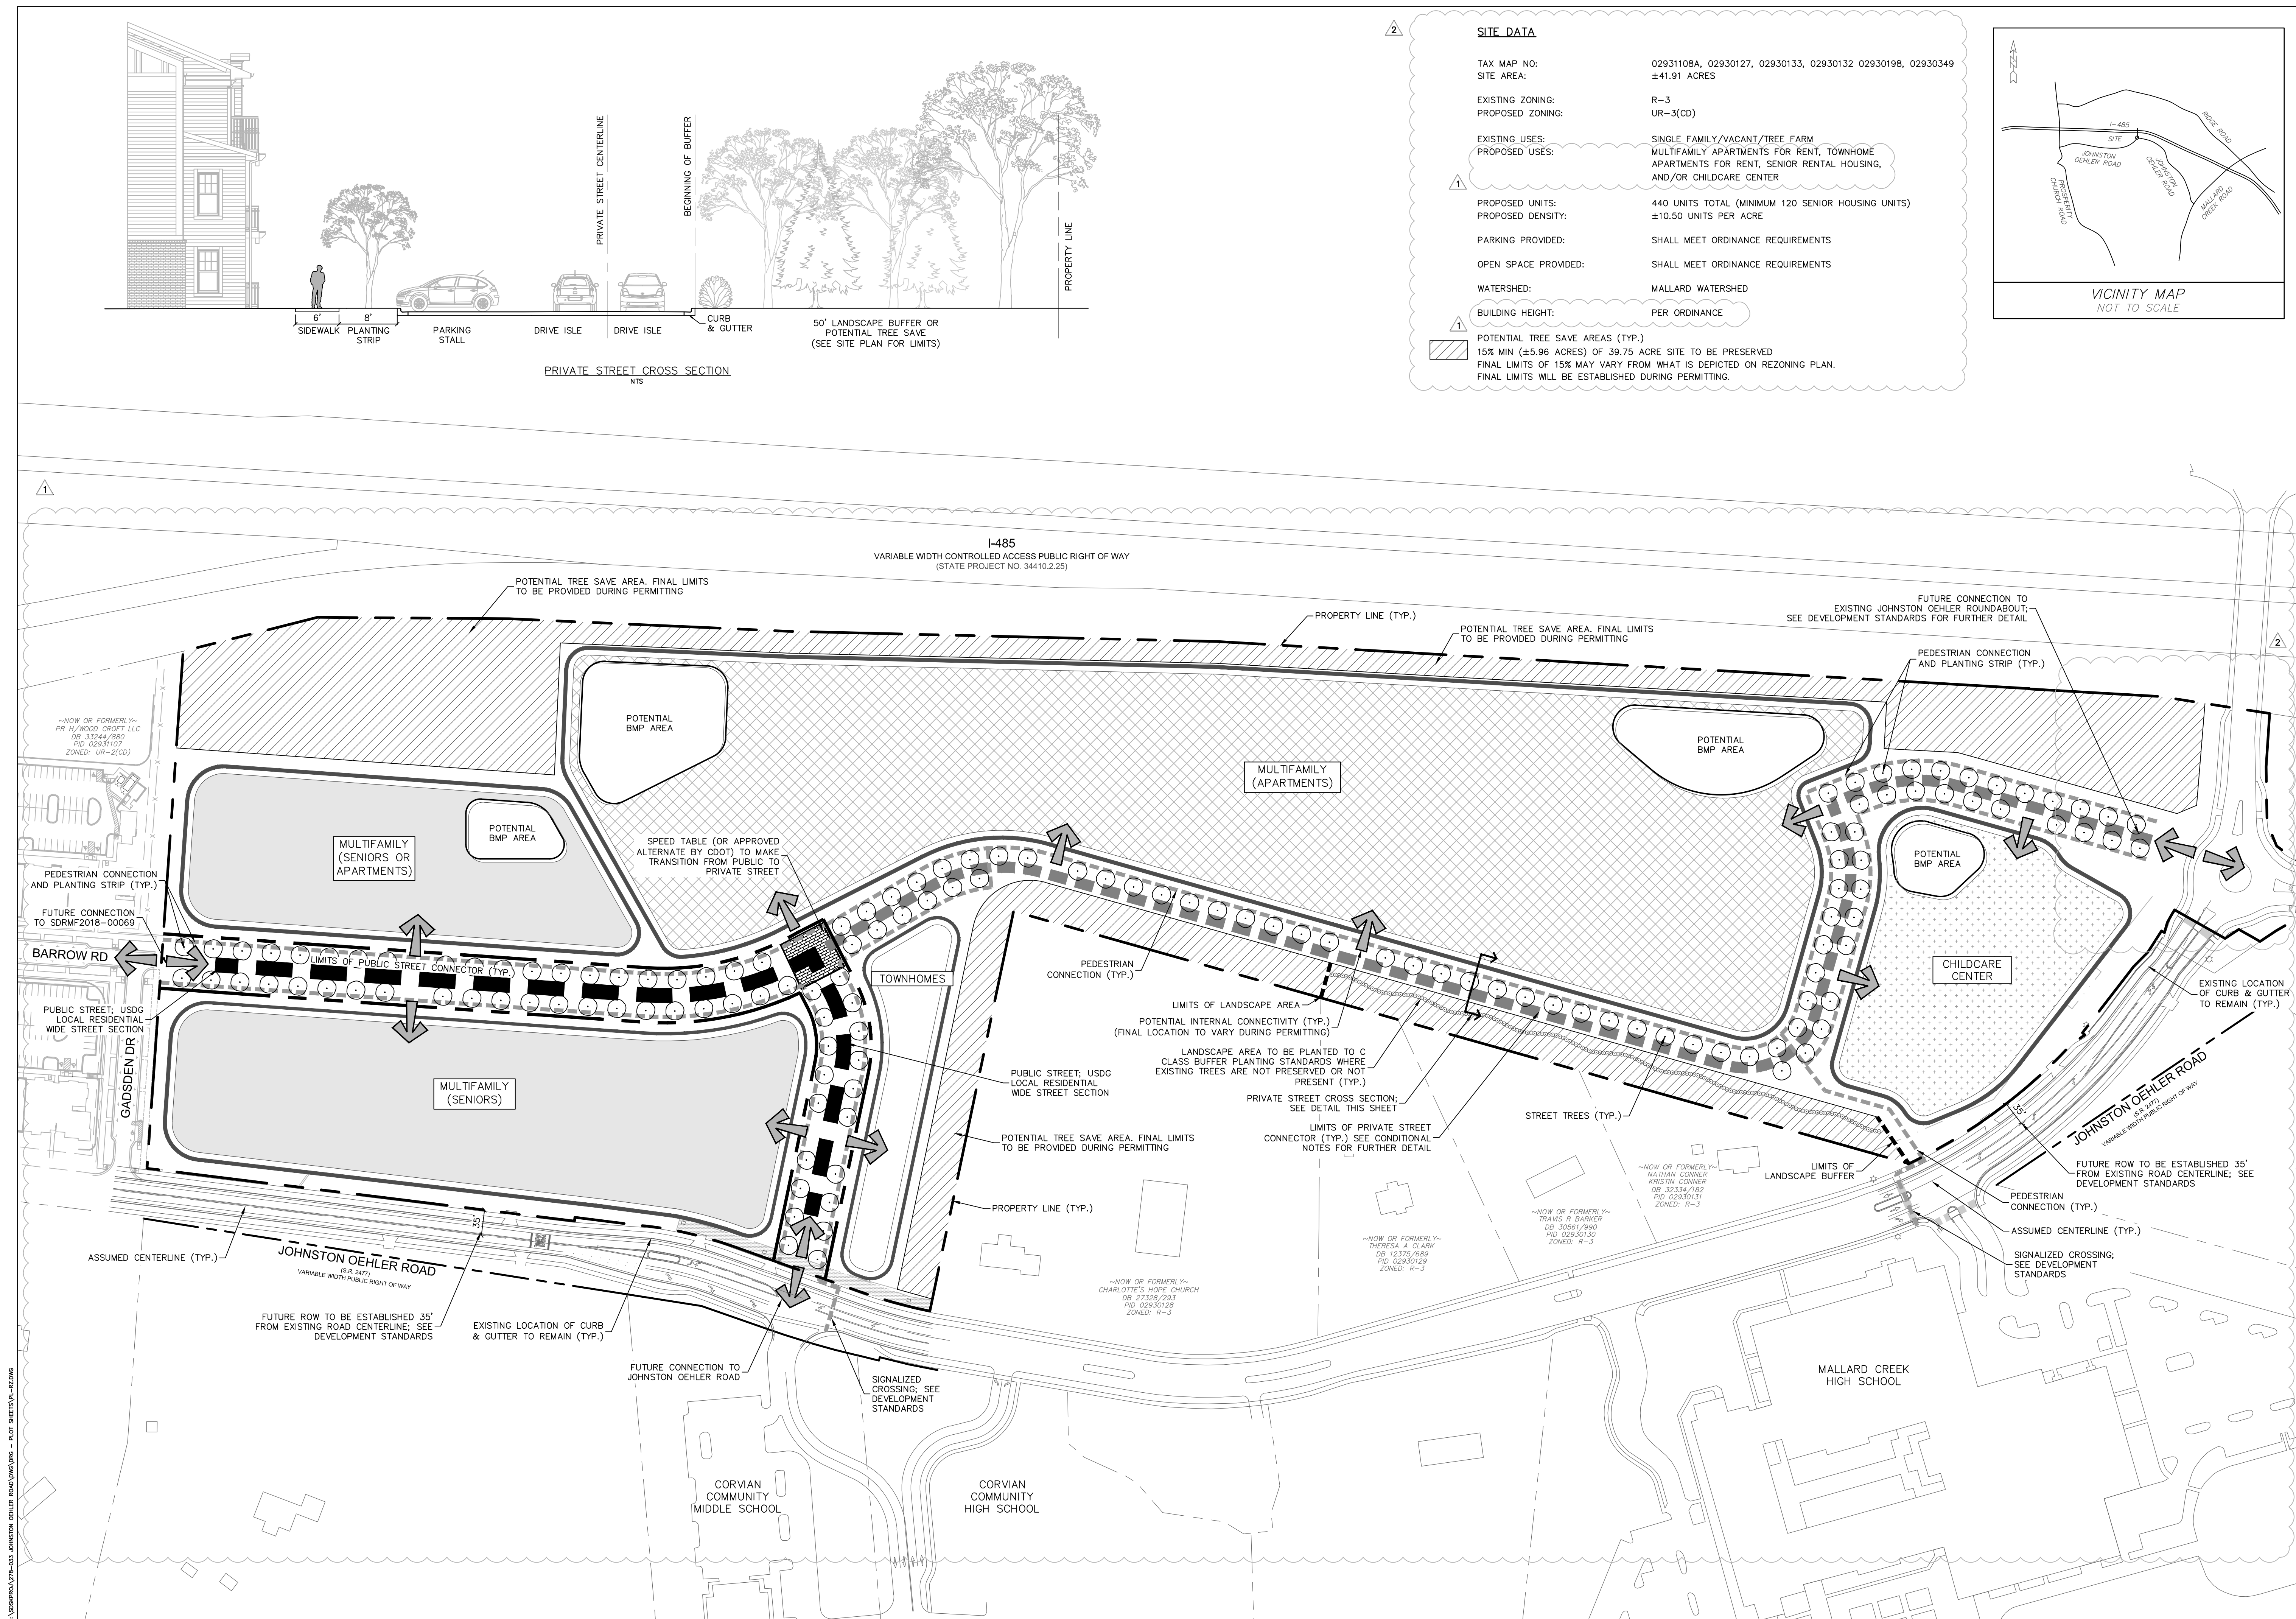

Copyright © 2019 Design Resource Group, PA. This plan or drawing and any accompanying documents or calculations are the property of Design Resource Group, PA, and are intended solely for the use of the recipient noted. No third party use or modification is permitted without written authorization.

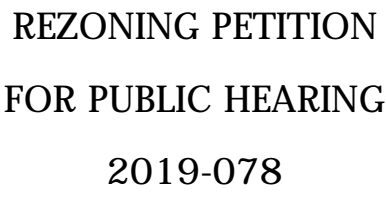

JOHNSTON OEHLER SITE

CHARLOTTE, NORTH CAROLINA

CHARTER PROPERTIES, INC.

1520 SOUTH BOULEVARD, SUITE 215
CHARLOTTE, NC 28203

704.377.4172

PROJECT #: 278-033
DRAWN BY: JO
CHECKED BY: NB

MAY 3, 2019

REVISIONS:

1. 08.12.19 PER REVIEW COMMENTS
2. 09.12.19 PER SITE UPDATES
3. 10.25.19 PER SITE UPDATES